

MASS GRADING PAD AS-BUILT TOPO - SHOTS & BREAKLINES



SPARKS FIRE STATION 6

CITY OF SPARKS

SPARKS


NEVADA

AS-BUILT TOPO ON 12/15/23

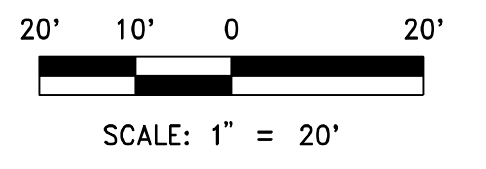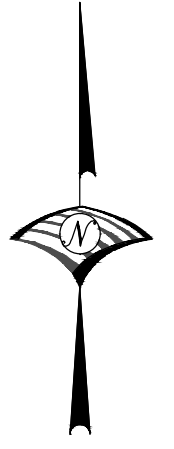

LEGEND:

- 0.94 AS-BUILT PAD VS. FG COMPARISON POINT WITH ELEVATION DIFFERENCE
- AS-BUILT TOPO MAJOR CONTOUR
- AS-BUILT TOPO MINOR CONTOUR
- DESIGN FG CONTOUR

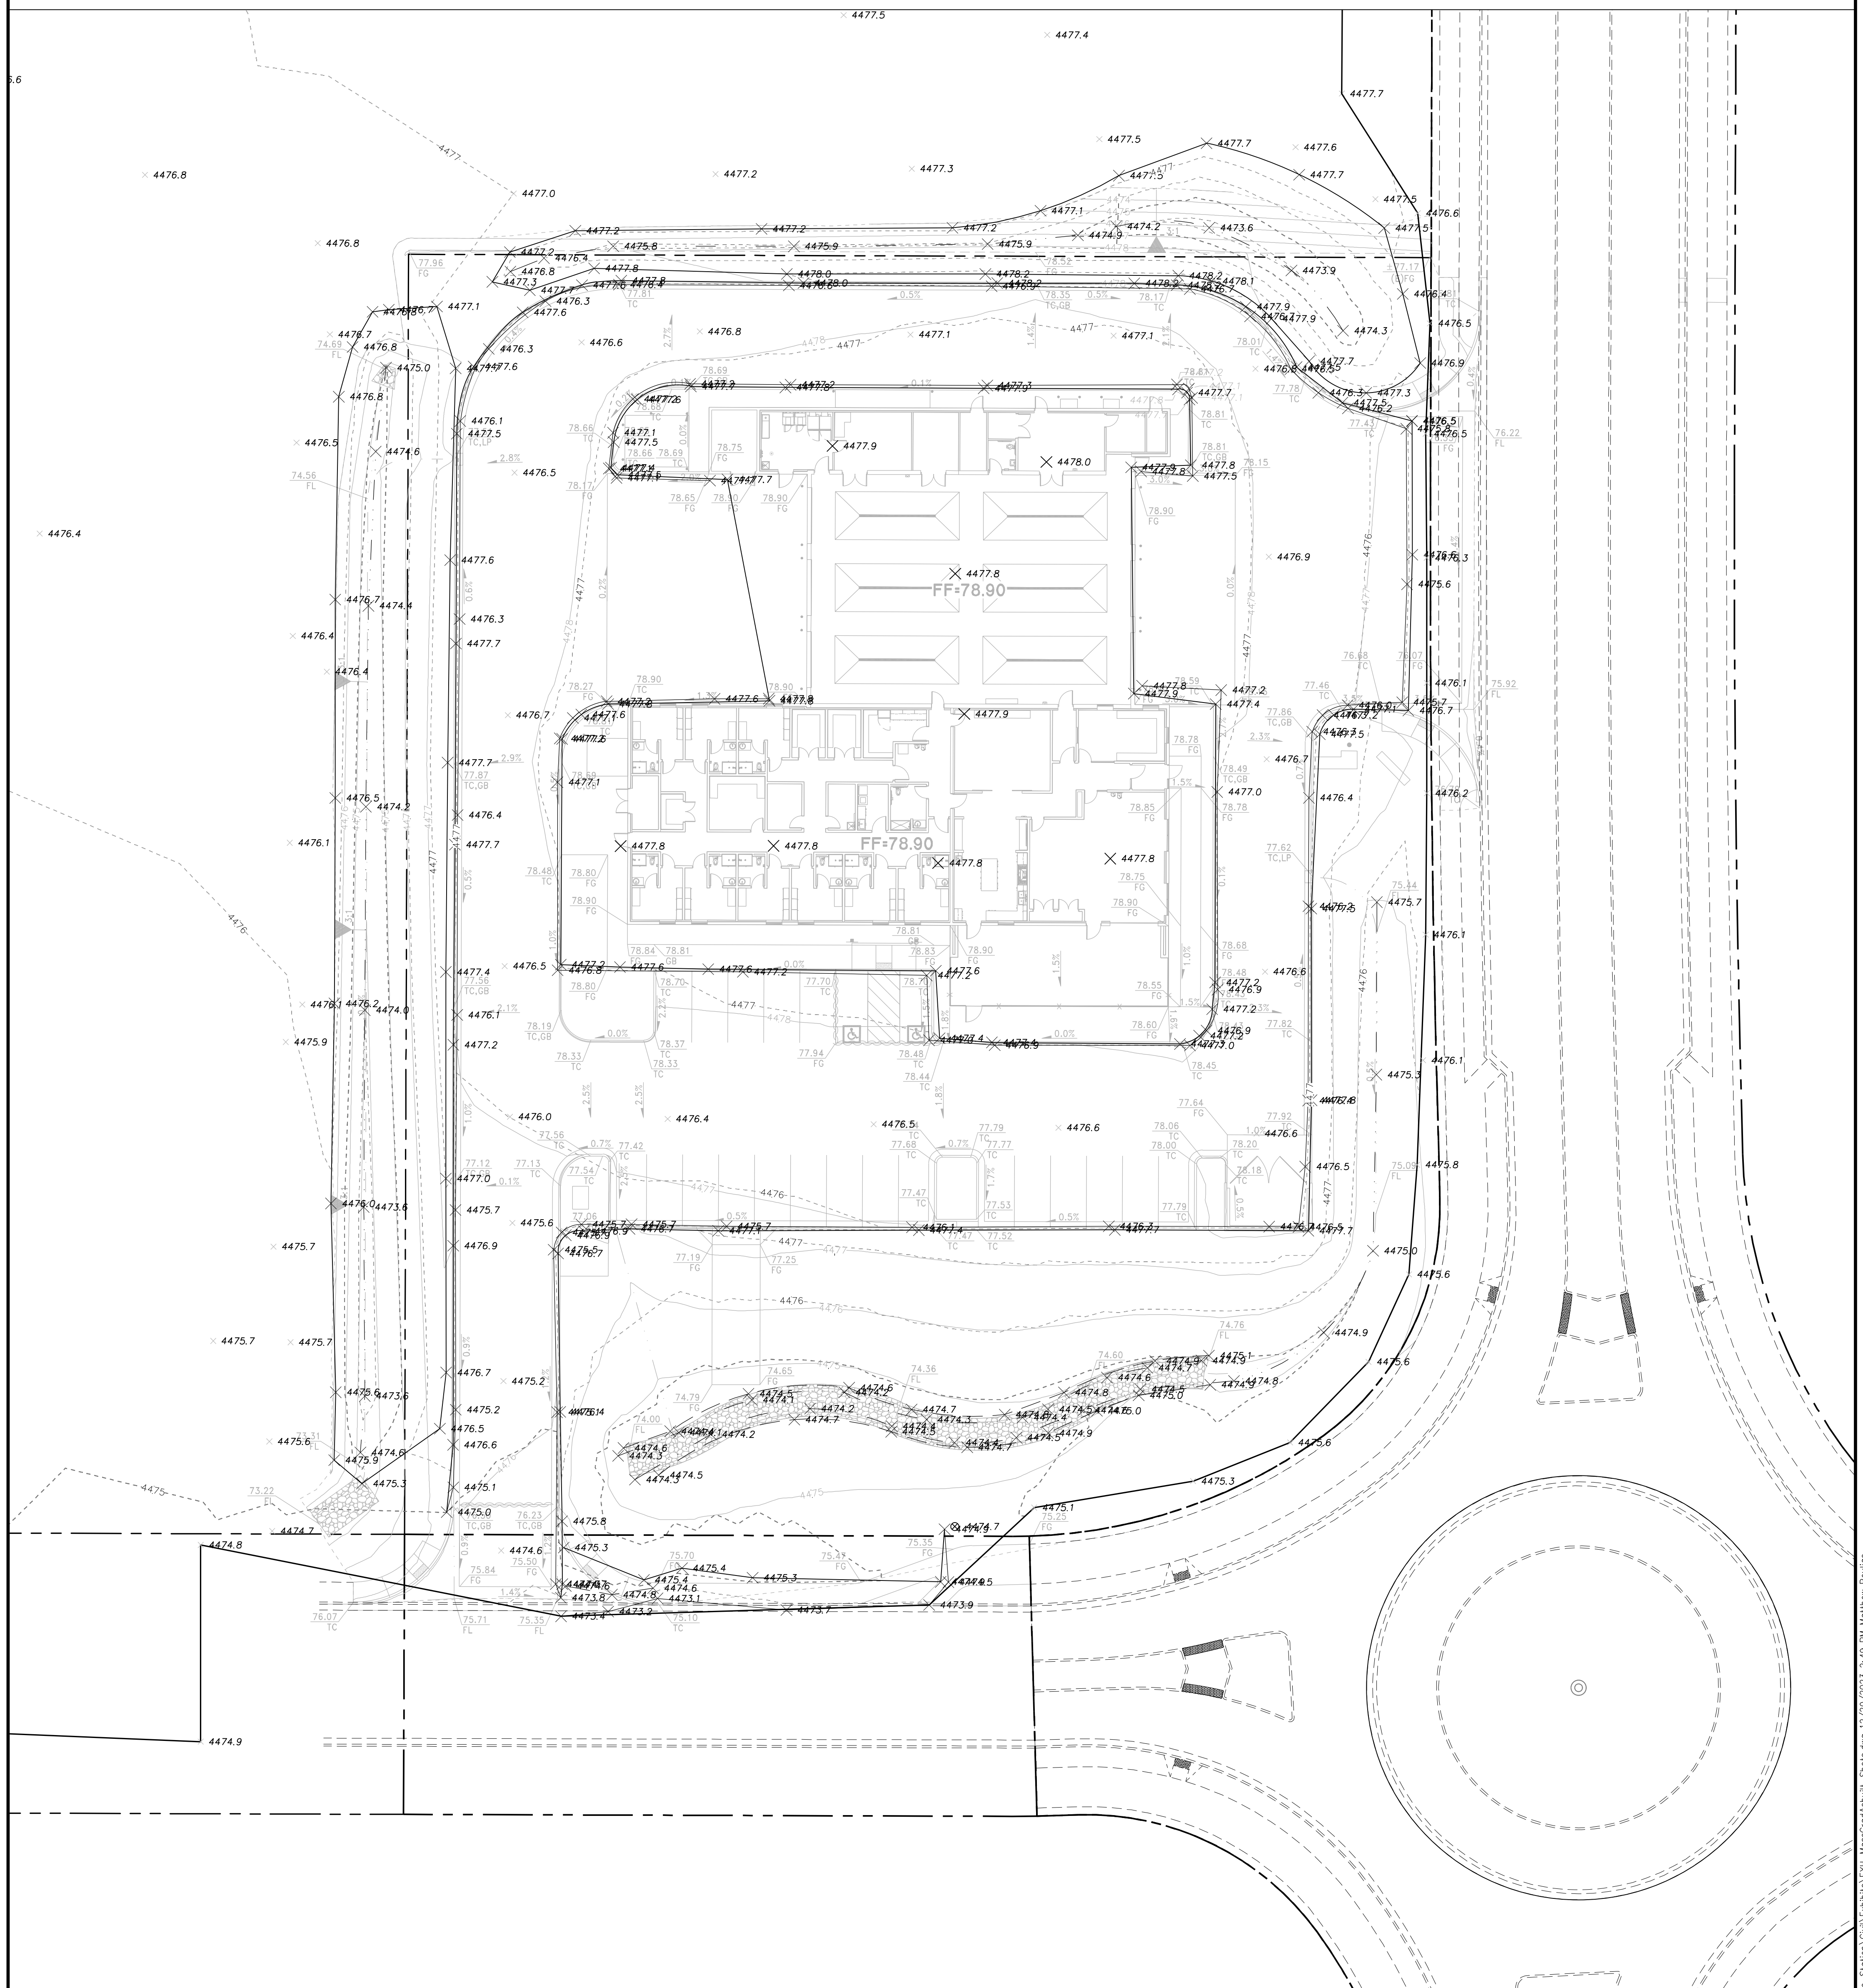

WOOD RODGERS
BUILDING RELATIONSHIPS ONE PROJECT AT A TIME
1361 Corporate Boulevard Tel 775.823.4068
Reno, NV 89502 Fax 775.823.4066

PROJECT NAME

J:\Users\66231_CitySparks\CitySparks\020_Plan_Fire_Station\City\Comb\As-Built_MassGrading\020_Plan_Fire_Station\City\Comb\As-Built_MassGrading\12/20/2023 2:49 PM Matthew Roulos

