



SPARKS POLICE DEPARTMENT HVAC UPGRADE



PWP# WA-2020-073
 BID #19/20-008

1701 E. PRATER WAY
 SPARKS, NEVADA
 89434

SHEET INDEX

GENERAL SHEET
 T10 TITLE SHEET-GENERAL INFO

MECHANICAL SHEETS

- M01 MECHANICAL SYMBOL LIST
- M02 MECHANICAL SCHEDULES
- M03 MECHANICAL SCHEDULES (2)
- M04 MECHANICAL SCHEDULES (3)
- M05 MECHANICAL COMPLIANCE CERTIFICATE
- M06 MECHANICAL COMPLIANCE CERTIFICATE (2)
- M07 MECHANICAL COMPLIANCE CERTIFICATE (3)
- M08 MECHANICAL COMPLIANCE CERTIFICATE (4)
- M09 MECHANICAL ZONE PLAN
- M10 MECHANICAL DEMOLITION FLOOR PLAN - BASEMENT
- M11 MECHANICAL DEMOLITION FLOOR PLAN - GROUND FLOOR
- M12 MECHANICAL DEMOLITION FLOOR PLAN - SECOND FLOOR
- M13 MECHANICAL PIPING DEMOLITION FLOOR PLAN - BASEMENT
- M14 MECHANICAL PIPING DEMOLITION FLOOR PLAN - GROUND FLOOR
- M15 MECHANICAL PIPING DEMOLITION FLOOR PLAN - SECOND FLOOR
- M16 MECHANICAL DEMOLITION ENLARGED PLANS
- M20 MECHANICAL FLOOR PLAN - BASEMENT
- M21 MECHANICAL FLOOR PLAN - GROUND FLOOR
- M22 MECHANICAL FLOOR PLAN - SECOND FLOOR
- M23 MECHANICAL PIPING FLOOR PLAN - BASEMENT
- M24 MECHANICAL PIPING FLOOR PLAN - GROUND FLOOR
- M25 MECHANICAL PIPING FLOOR PLAN - SECOND FLOOR
- M26 MECHANICAL ENLARGED PLANS
- M41 MECHANICAL PIPING DIAGRAM
- M51 MECHANICAL CONTROLS
- M52 MECHANICAL CONTROLS (2)
- M61 MECHANICAL DETAILS
- M62 MECHANICAL DETAILS (2)
- M63 MECHANICAL DETAILS (3)
- M64 MECHANICAL DETAILS (4)

ELECTRICAL SHEETS

- E01 ELECTRICAL SYMBOL LIST
- E02 ELECTRICAL NOTES AND CALCULATIONS
- E11 ELECTRICAL DEMOLITION FLOOR PLAN - BASEMENT
- E12 ELECTRICAL DEMOLITION FLOOR PLAN - GROUND FLOOR
- E13 ELECTRICAL DEMOLITION FLOOR PLAN - SECOND FLOOR
- E21 ELECTRICAL FLOOR PLAN - BASEMENT
- E22 ELECTRICAL FLOOR PLAN - GROUND FLOOR
- E23 ELECTRICAL FLOOR PLAN - SECOND FLOOR




DESIGN CONSULTANTS



MECHANICAL
 Matthew C. Myres, PE
 Mechanical Engineer
 MMI Engineering Co.
 385 Gentry Way
 Reno, Nevada, 89502
 (775)-750-0849



ELECTRICAL
 Keller Hackbusch, PE
 Electrical Engineer
 Dinter Engineering Co.
 385 Gentry Way
 Reno, Nevada, 89502
 Office: 775-826-4044
 Direct: 775-882-4618

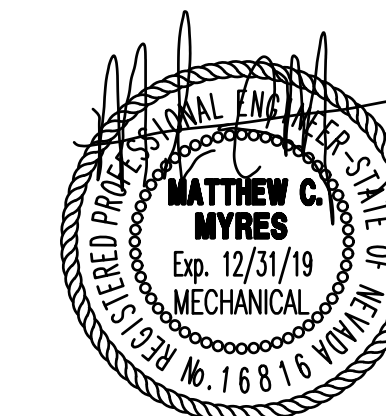


MATTHEW C. MYRES, PE
 MMI ENGINEERING

DATE: 11/13/2019

JON R. ERICSON, PE, P.T.O.E.
 CITY ENGINEER

DATE: 11/13/2019

MMI ENGINEERING
 385 GENTRY WAY
 RENO, NV, 89502
 (775) 499-5784
 WWW.MMI-DESIGNER.COM
 MMI PROJECT #2016-19

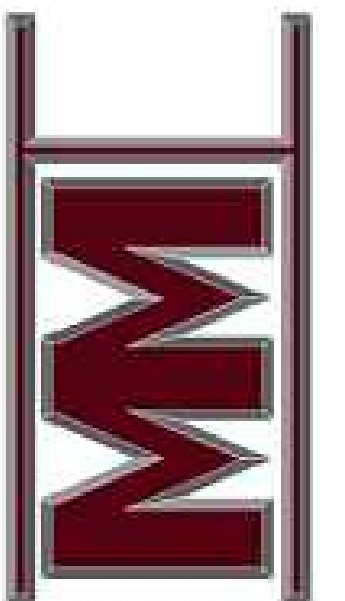

MMI ENGINEERING

SPARKS POLICE DEPARTMENT
 HVAC UPGRADE PHASE 1
 1701 EAST PRATER WAY
 SPARKS, NEVADA 89434

SHEET TITLE
 TITLE SHEET - GENERAL
 INFO

REVISIONS

1	PLAN REVIEW COMMENTS (04/09/18)
2	OWNER REVISIONS (10/31/18)
3	OWNER REVISIONS (06/04/19)

BID DOCUMENTS

DATE :
 MARCH 26, 2018

SHEET NUMBER :


T1.0

MECHANICAL SYMBOL LIST

(NOTE: ALL OF THE SYMBOLS INDICATED BELOW MAY NOT APPEAR ON THIS PROJECT)

	DUCT W/ SIZE INDICATED (FIRST FIG. IS SIDE SHOWN)		MPS	MEDIUM PRESSURE STEAM SUPPLY		P.D.	PIPING TEE DOWN		FROM BELOW
			RD	REFRIGERANT DISCHARGE PIPING		P.U.	PIPING TEE UP		FEET
	V.D.		RL	REFRIGERANT LIQUID PIPING		P.U.	PIPING ELBOW UP		GAUGE
	DUCT WITH ACOUSTIC LINING		RS	REFRIGERANT SUCTION PIPING		P.D.	PIPING ELBOW DOWN		GALLON
	F.D.R.		RF	REFRIGERANT FILTER			BRANCH - TOP CONNECTION		GALLONS PER HOUR
	S.D.		RS	REFRIGERANT STRAINER			BRANCH - BOTTOM CONNECTION		GALLONS PER MINUTE
	F.S.D.		RFD	REFRIGERANT FILTER AND DRIER			BRANCH - SIDE CONNECTION		HEAD
	EX		RD	REFRIGERANT DRIER		P.T.	PLUGGED TEE		HORSEPOWER
	SQUARE TO ROUND DUCT TRANSITION		RI	REFRIGERANT VIBRATION ISOLATOR		P.T.T.	PRESSURE & TEMPERATURE TAP		HOUR
	DUCT SIZE TRANSITION		ROB	REFRIGERANT OIL SEPARATOR		C.O.P.	CAP ON END OF PIPE		KILOWATTS
	FLEXIBLE DUCT CONNECTOR		G.V.	GATE VALVE		FLX	FLEXIBLE COUPLING		LEAVING AIR TEMPERATURE
	SPLITTER DAMPER		GLV	GLOBE VALVE			ARROW INDICATES DIRECTION OF FLOW		LEAVING WATER TEMPERATURE
	TURNING VANES		ANV	ANGLE VALVE		L.W.C.O.	LOW WATER CUT-OFF		MAXIMUM
	SUPPLY AIR DUCT DOWN		B.L.V.	BALL VALVE		P.O.C.	POINT OF CONNECTION - NEW ITEMS TO EXISTING ITEMS		BRITISH THERMAL UNITS PER HOUR (THOUSANDS)
	SUPPLY AIR DUCT UP		B.F.V.	BUTTERFLY VALVE		A.P.	ACCESS PANEL		MINIMUM
	RETURN AIR DUCT DOWN		C.H.V.	CHECK VALVE		RM	DUCTWORK / PIPING / EQUIPMENT TO BE REMOVED		MAKE-UP AIR
	RETURN AIR DUCT UP		TDV	TRIPLE DUTY VALVE			EXISTING DUCTWORK / PIPING / EQUIPMENT TO REMAIN		NEW
	EXHAUST AIR DUCT DOWN		B.V.	BALANCING VALVE			MECHANICAL EQUIPMENT INDICATED (SEE SCHEDULE)		NORMALLY CLOSED
	EXHAUST AIR DUCT UP		H.V.	3/4" HOSE END DRAIN VALVE			DIFFUSER OR GRILLE INDICATED (SEE SCHEDULE)		NORMALLY OPEN
	SUPPLY AIR DIFFUSER WITH FLEX CONNECTION		S.O.V.	SHUT-OFF VALVE IN RISER		T	THERMOSTAT		NOMINAL
	RETURN AIR GRILLE OPEN TO CEILING SPACE		C.C.	CIRCUIT SETTER BALANCE VALVE		H	HUMIDISTAT		OUTSIDE AIR
	ROUND SUPPLY AIR DIFFUSER WITH RIGID CONNECTION		B.P.	BACKFLOW PREVENTOR		T2	THERMOSTAT WITH ZONE INDICATED		ON CENTER
	RETURN AIR GRILLE WITH RIGID DUCT CONNECTION		R.P.B.P.	REDUCED PRESSURE BACKFLOW PREVENTOR		P	PONTENTIOMETER		OUTSIDE AIR
	MOTORIZED DAMPER		S.V.	SOLENOID VALVE		S	SENSOR		PRESSURE DROP
	OPPOSED BLADE DAMPER		F.S.	FLOW SWITCH		S.DET.	SMOKE DETECTOR		RETURN AIR GRILLE
	HEATING HOT WATER SUPPLY PIPING		P.S.	PRESSURE SWITCH		T.C.P.	TEMPERATURE CONTROL PANEL		RELATIVE HUMIDITY
	HEATING HOT WATER RETURN PIPING		P.R.V.	PRESSURE REDUCING VALVE		AFF	ABOVE FINISHED FLOOR		REVOLUTION PER MINUTE
	CHILLED WATER SUPPLY PIPING		S.T.R.	STRAINER		AFG	ABOVE FINISHED GRADE		SUPPLY AIR DIFFUSER
	CHILLED WATER RETURN PIPING		S.T.R.	STRAINER WITH 3/4" HOSE END DRAIN VALVE		BDD	BACKDRAFT DAMPER		SEASONAL ENERGY EFFICIENCY RATIO
	HEAT PUMP WATER SUPPLY PIPING		P.T.R.	PRESSURE - TEMPERATURE RELIEF VALVE		BHP	BRAKE HORSEPOWER		SQUARE FEET
	HEAT PUMP WATER RETURN PIPING		RV	PRESSURE RELIEF VALVE		B.J.	BETWEEN JOISTS		SHEET METAL
	CONDENSER WATER SUPPLY PIPING		2VAL	2-WAY CONTROL VALVE		B.O.D.	BOTTOM OF DUCT		STATIC PRESSURE
	CONDENSER WATER RETURN PIPING		3VAL	3-WAY CONTROL VALVE		B.O.G. (L.)	BOTTOM OF GRILLE (LOUVER)		MANUAL TIMER SWITCH
	ICE WATER SUPPLY PIPING		U	UNION		B.O.R.	BOTTOM OF REGISTER		STANDARD
	ICE WATER RETURN PIPING		F	FLANGE		BTUH	BRITISH THERMAL UNITS PER HOUR		TEMPERATURE
	HIGH PRESSURE CONDENSATE RETURN		FL	FLEXIBLE PIPING CONNECTOR		CFH	CUBIC FEET PER HOUR		TO ABOVE
	HIGH PRESSURE STEAM SUPPLY		CR	CONCENTRIC REDUCER		CFM	CUBIC FEET PER MINUTE		TRANSFER AIR GRILLE
	LOW PRESSURE CONDENSATE RETURN		ER	ECCENTRIC REDUCER		CLG	CEILING		TO BELOW
	LOW PRESSURE STEAM SUPPLY		P.R.G.	PRESSURE GAUGE WITH GAUGE COCK		DL	DRY BULB TEMPERATURE		THROUGH JOISTS
	MEDIUM PRESSURE CONDENSATE RETURN		TH	THERMOMETER		DN	DOWN		TOP OF DUCT
			A.A.V.	AUTOMATIC AIR VENT		(E)	EXISTING		TOP OF GRILLE (LOUVER)
			M.A.V.	MANUAL AIR VENT		EAT	ENTERING AIR TEMPERATURE		TOP OF REGISTER
			V.B.	VACUUM BREAKER		EDB	ENTERING DRY BULB		TYPICAL
			P.A.	PIPE ANCHOR		ESP	EXTERNAL STATIC PRESSURE		UNDERCUT DOOR
			P.G.	PIPE ALIGNMENT GUIDE		EWT	ENTERING WATER TEMPERATURE		UNDER FLOOR
			E.J.	PIPE EXPANSION JOINT		F	DEGREES FARENHEIT		WET BULB TEMPERATURE
						F.A.	FROM ABOVE		WATER COLUMN

MMI ENGINEERING
385 GENTRY WAY
RENO, NV. 89502
(775) 499-5784
WWW.MMI-ENGINEER.COM
MMI PROJECT #2016-19

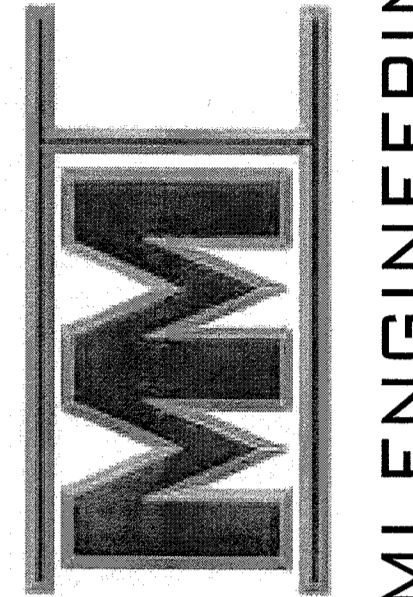


MMI ENGINEERING

SPARKS POLICE DEPARTMENT
HVAC UPGRADE PHASE 1
1701 EAST PRATER WAY
SPARKS, NEVADA 89434

SHEET TITLE
MECHANICAL SYMBOL LIST

REVISIONS

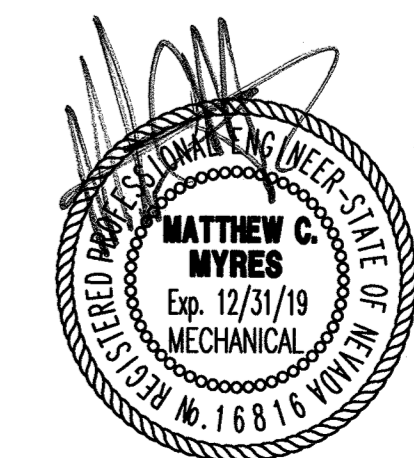


BID DOCUMENTS

DATE : MARCH 26 2018
SHEET NUMBER : MAR 28 2018
COMMUNITY SERVICES BUILDING DIVISION
MO.1

VAV BOX SCHEDULE

UNIT DESIGNATION	MAKE AND MODEL NUMBER	STANDARD FEATURES AND OPTIONAL ACCESSORIES	UNIT SIZE	CONTROL VALVE TYPE	MAX AIR FLOW (CFM) @ 1.0" W.G.	MIN AIR FLOW (CFM) @ 0.03" W.G.	REHEAT AIR VOLUME (CFM)	REHEAT COIL							CONTROLS	INLET STATIC (in wc)	DISCHARGE SOUND CRITERIA		RADIATED SOUND CRITERIA			
								CAPACITY (MEH)	EAT (°F)	LAT (°F)	WPD. (ft. wg)	COIL APD. (IN W.C.)	FLOW (GPM)	ENT (°F)			LMT (°F)	ROWS	SOUND PWR. LVL. (OCTAVES 2-7)	NC	SOUND PWR. LVL. (OCTAVES 2-7)	NC
VAV B1	ENVIRO-TEC SDR	MULTI-POINT AVERAGING VELOCITY SENSOR, 1/2" THICK FIBERGLASS INSULATION, 22 GAUGE UNIT CASING, NEMA 1 WIRING ENCLOSURE, UL 2TTV1/1# TRANSFORMER, HOT WATER REHEAT COIL, MODULATING CONTROL VALVE PACKAGE INCLUDING ISOLATION BALL VALVES, UNIONS, AND P/T PORTS	12	3-WAY	1875	940	940	29.3	55	88	0.2	0.41	2	150	120	2	DIGITAL ELECTRONIC	1	66,59,56,53,49,46	16	53,48,44,37,33,29	18
VAV B2	ENVIRO-TEC SDR	MULTI-POINT AVERAGING VELOCITY SENSOR, 1/2" THICK FIBERGLASS INSULATION, 22 GAUGE UNIT CASING, NEMA 1 WIRING ENCLOSURE, UL 2TTV1/1# TRANSFORMER, HOT WATER REHEAT COIL, MODULATING CONTROL VALVE PACKAGE INCLUDING ISOLATION BALL VALVES, UNIONS, AND P/T PORTS	05	2-WAY	350	180	180	5.4	55	81	0.31	0.06	.75	150	135	1	DIGITAL ELECTRONIC	1	71,67,57,53,48,47	26	55,53,49,41,37,33	23
VAV B3	ENVIRO-TEC SDR	MULTI-POINT AVERAGING VELOCITY SENSOR, 1/2" THICK FIBERGLASS INSULATION, 22 GAUGE UNIT CASING, NEMA 1 WIRING ENCLOSURE, UL 2TTV1/1# TRANSFORMER, HOT WATER REHEAT COIL, MODULATING CONTROL VALVE PACKAGE INCLUDING ISOLATION BALL VALVES, UNIONS, AND P/T PORTS	16	2-WAY	2,640	1320	1320	43.9	55	90	0.33	0.29	2.25	150	110	2	DIGITAL ELECTRONIC	1	65,57,56,51,47,45	15	53,48,43,39,35,31	16
VAV B4	ENVIRO-TEC SDR	MULTI-POINT AVERAGING VELOCITY SENSOR, 1/2" THICK FIBERGLASS INSULATION, 22 GAUGE UNIT CASING, NEMA 1 WIRING ENCLOSURE, UL 2TTV1/1# TRANSFORMER, HOT WATER REHEAT COIL, MODULATING CONTROL VALVE PACKAGE INCLUDING ISOLATION BALL VALVES, UNIONS, AND P/T PORTS	12	2-WAY	1800	1800	950	51.3	55	85	0.12	0.57	2.5	150	108	3	DIGITAL ELECTRONIC	1	66,59,56,53,49,46	16	53,48,44,37,33,29	18
VAV B5	ENVIRO-TEC SDR	MULTI-POINT AVERAGING VELOCITY SENSOR, 1/2" THICK FIBERGLASS INSULATION, 22 GAUGE UNIT CASING, NEMA 1 WIRING ENCLOSURE, UL 2TTV1/1# TRANSFORMER, HOT WATER REHEAT COIL, MODULATING CONTROL VALVE PACKAGE INCLUDING ISOLATION BALL VALVES, UNIONS, AND P/T PORTS	10	2-WAY	1,440	720	720	23.9	55	90	0.46	0.45	1.5	150	117	2	DIGITAL ELECTRONIC	1	67,61,57,54,50,47	18	57,48,46,39,33,29	20
VAV B6	ENVIRO-TEC SDR	MULTI-POINT AVERAGING VELOCITY SENSOR, 1/2" THICK FIBERGLASS INSULATION, 22 GAUGE UNIT CASING, NEMA 1 WIRING ENCLOSURE, UL 2TTV1/1# TRANSFORMER, HOT WATER REHEAT COIL, MODULATING CONTROL VALVE PACKAGE INCLUDING ISOLATION BALL VALVES, UNIONS, AND P/T PORTS	10	2-WAY	1,050	530	530	16	55	87	0.08	0.27	1.25	150	124	2	DIGITAL ELECTRONIC	1	63,58,54,51,48,44	N/A	53,44,43,36,30,29	16
VAV B7	ENVIRO-TEC SDR	MULTI-POINT AVERAGING VELOCITY SENSOR, 1/2" THICK FIBERGLASS INSULATION, 22 GAUGE UNIT CASING, NEMA 1 WIRING ENCLOSURE, UL 2TTV1/1# TRANSFORMER, HOT WATER REHEAT COIL, MODULATING CONTROL VALVE PACKAGE INCLUDING ISOLATION BALL VALVES, UNIONS, AND P/T PORTS	10	2-WAY	1,400	700	700	21.2	55	87	0.06	0.63	1.5	150	121	3	DIGITAL ELECTRONIC	1	67,61,57,54,50,47	18	57,48,46,39,33,29	20
VAV B8	ENVIRO-TEC SDR	MULTI-POINT AVERAGING VELOCITY SENSOR, 1/2" THICK FIBERGLASS INSULATION, 22 GAUGE UNIT CASING, NEMA 1 WIRING ENCLOSURE, UL 2TTV1/1# TRANSFORMER, HOT WATER REHEAT COIL, MODULATING CONTROL VALVE PACKAGE INCLUDING ISOLATION BALL VALVES, UNIONS, AND P/T PORTS	08	2-WAY	1,000	500	500	15	55	87	0.23	0.46	1	150	119	2	DIGITAL ELECTRONIC	1	70,63,57,54,50,46	21	60,52,48,42,37,30	22
VAV B9	ENVIRO-TEC SDR	MULTI-POINT AVERAGING VELOCITY SENSOR, 1/2" THICK FIBERGLASS INSULATION, 22 GAUGE UNIT CASING, NEMA 1 WIRING ENCLOSURE, UL 2TTV1/1# TRANSFORMER, HOT WATER REHEAT COIL, MODULATING CONTROL VALVE PACKAGE INCLUDING ISOLATION BALL VALVES, UNIONS, AND P/T PORTS	08	2-WAY	700	350	350	11.3	55	89	0.15	0.26	0.75	150	119	2	DIGITAL ELECTRONIC	1	64,58,54,51,47,43	16	56,45,44,39,34,27	18
VAV G1	ENVIRO-TEC SDR	MULTI-POINT AVERAGING VELOCITY SENSOR, 1/2" THICK FIBERGLASS INSULATION, 22 GAUGE UNIT CASING, NEMA 1 WIRING ENCLOSURE, UL 2TTV1/1# TRANSFORMER, HOT WATER REHEAT COIL, MODULATING CONTROL VALVE PACKAGE INCLUDING ISOLATION BALL VALVES, UNIONS, AND P/T PORTS	08	2-WAY	780	390	390	11.8	55	87	0.15	0.31	0.75	150	118	2	DIGITAL ELECTRONIC	1	64,58,54,51,47,43	N/A	56,45,44,39,34,27	18
VAV G2	ENVIRO-TEC SDR	MULTI-POINT AVERAGING VELOCITY SENSOR, 1/2" THICK FIBERGLASS INSULATION, 22 GAUGE UNIT CASING, NEMA 1 WIRING ENCLOSURE, UL 2TTV1/1# TRANSFORMER, HOT WATER REHEAT COIL, MODULATING CONTROL VALVE PACKAGE INCLUDING ISOLATION BALL VALVES, UNIONS, AND P/T PORTS	14	3-WAY	2,560	1280	1280	46	55	93	2	0.37	2.5	150	112	2	DIGITAL ELECTRONIC	1	66,59,57,53,49,46	16	53,48,44,38,34,30	18
VAV G3	ENVIRO-TEC SDR	MULTI-POINT AVERAGING VELOCITY SENSOR, 1/2" THICK FIBERGLASS INSULATION, 22 GAUGE UNIT CASING, NEMA 1 WIRING ENCLOSURE, UL 2TTV1/1# TRANSFORMER, HOT WATER REHEAT COIL, MODULATING CONTROL VALVE PACKAGE INCLUDING ISOLATION BALL VALVES, UNIONS, AND P/T PORTS	14	2-WAY	2,640	1320	1320	46.8	55	92	2	0.39	2.5	150	111	2	DIGITAL ELECTRONIC	1	66,59,57,53,49,46	16	53,48,44,38,34,30	18
VAV G4	ENVIRO-TEC SDR	MULTI-POINT AVERAGING VELOCITY SENSOR, 1/2" THICK FIBERGLASS INSULATION, 22 GAUGE UNIT CASING, NEMA 1 WIRING ENCLOSURE, UL 2TTV1/1# TRANSFORMER, HOT WATER REHEAT COIL, MODULATING CONTROL VALVE PACKAGE INCLUDING ISOLATION BALL VALVES, UNIONS, AND P/T PORTS	14	2-WAY	2,850	1,430	1,430	49.8	55	92	2.38	0.44	2.75	150	113	2	DIGITAL ELECTRONIC	1	68,60,59,54,50,47	19	55,50,46,40,35,31	20
VAV G5	ENVIRO-TEC SDR	MULTI-POINT AVERAGING VELOCITY SENSOR, 1/2" THICK FIBERGLASS INSULATION, 22 GAUGE UNIT CASING, NEMA 1 WIRING ENCLOSURE, UL 2TTV1/1# TRANSFORMER, HOT WATER REHEAT COIL, MODULATING CONTROL VALVE PACKAGE INCLUDING ISOLATION BALL VALVES, UNIONS, AND P/T PORTS	06	2-WAY	460	230	230	7	55	88	0.08	0.18	0.5	150	121	2	DIGITAL ELECTRONIC	1	65,60,55,51,45,43	18	55,50,46,39,33,29	20

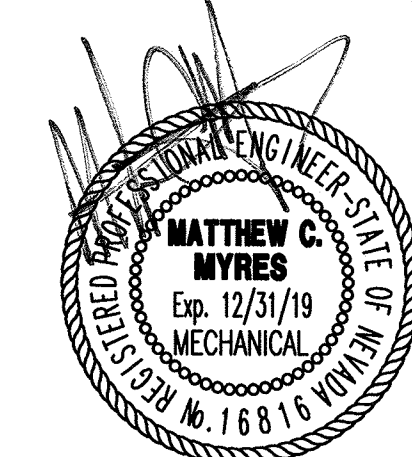

3/26/2018

BID DOCUMENTS


SPARKS POLICE DEPARTMENT
 HVAC UPGRADE PHASE 1
 1701 EAST PRATER WAY
 SPARKS, NEVADA 89434

SHEET TITLE
 MECHANICAL SCHEDULES

REVISIONS

DATE: MARCH 26, 2018 RECEIVED-CITY OF SPARKS
 SHEET NUMBER: MAR 28 2018
 COMMUNITY SERVICES BUILDING DIVISION
M0.2


MMI ENGINEERING
 385 GENTRY WAY
 RENO, NV. 89502
 (775) 499-5784
 WWW.MMI-DESIGNER.COM
 MMI PROJECT #2016-19

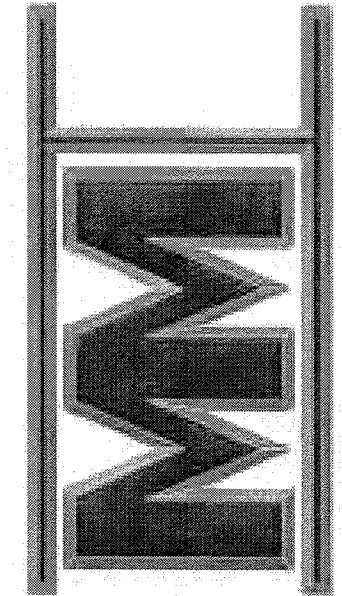

MMI ENGINEERING

VAV BOX SCHEDULE

UNIT DESIGNATION	MAKE AND MODEL NUMBER	STANDARD FEATURES AND OPTIONAL ACCESSORIES	UNIT SIZE	CONTROL VALVE TYPE	MAX AIR FLOW (CFM) @ 1.0" W.G.	MIN AIR FLOW (CFM) @ 0.03" W.G.	REHEAT AIR VOLUME (CFM)	REHEAT COIL							CONTROLS	INLET STATIC (In wc)	DISCHARGE SOUND CRITERIA		RADIATED SOUND CRITERIA			
								CAPACITY (MBH)	EAT (°F)	LAT (°F)	WPD. (ft. wg)	COIL APD. (IN W.C.)	FLOW (GPM)	EHT (°F)			LHT (°F)	ROWS	SOUND PWR LVL. (OCTAVES 2-1)	NC	SOUND PWR LVL. (OCTAVES 2-1)	NC
VAV 66	ENVIRO-TEC SDR	MULTI-POINT AVERAGING VELOCITY SENSOR, 1/2" THICK FIBERGLASS INSULATION, 22 GAUGE UNIT CASING, NEMA 1 WIRING ENCLOSURE, UL 21TV/1# TRANSFORMER, HOT WATER REHEAT COIL, MODULATING CONTROL VALVE PACKAGE INCLUDING ISOLATION BALL VALVES, UNIONS, AND P/T PORTS	12	2-WAY	2200	1100	1100	40.4	55	88.5	1.51	0.53	2.5	150	111	2	DIGITAL ELECTRONIC	1	68,61,58,54,51,41	19	54,49,46,39,33,29	20
VAV 67	ENVIRO-TEC SDR	MULTI-POINT AVERAGING VELOCITY SENSOR, 1/2" THICK FIBERGLASS INSULATION, 22 GAUGE UNIT CASING, NEMA 1 WIRING ENCLOSURE, UL 21TV/1# TRANSFORMER, HOT WATER REHEAT COIL, MODULATING CONTROL VALVE PACKAGE INCLUDING ISOLATION BALL VALVES, UNIONS, AND P/T PORTS	10	2-WAY	1500	750	750	25.5	55	91	0.61	0.48	1.75	150	120	2	DIGITAL ELECTRONIC	1	67,61,57,54,50,41	18	51,48,46,39,33,29	20
VAV 68	ENVIRO-TEC SDR	MULTI-POINT AVERAGING VELOCITY SENSOR, 1/2" THICK FIBERGLASS INSULATION, 22 GAUGE UNIT CASING, NEMA 1 WIRING ENCLOSURE, UL 21TV/1# TRANSFORMER, HOT WATER REHEAT COIL, MODULATING CONTROL VALVE PACKAGE INCLUDING ISOLATION BALL VALVES, UNIONS, AND P/T PORTS	12	2-WAY	1835	920	920	31.4	55	91	0.78	0.4	1.75	150	113	2	DIGITAL ELECTRONIC	1	66,59,56,53,49,46	16	53,48,44,37,33,29	18
VAV 69	ENVIRO-TEC SDR	MULTI-POINT AVERAGING VELOCITY SENSOR, 1/2" THICK FIBERGLASS INSULATION, 22 GAUGE UNIT CASING, NEMA 1 WIRING ENCLOSURE, UL 21TV/1# TRANSFORMER, HOT WATER REHEAT COIL, MODULATING CONTROL VALVE PACKAGE INCLUDING ISOLATION BALL VALVES, UNIONS, AND P/T PORTS	10	2-WAY	1450	730	730	24	55	90	0.46	0.45	1.5	150	111	2	DIGITAL ELECTRONIC	1	67,61,57,54,50,41	18	51,48,46,39,33,29	20
VAV 610	ENVIRO-TEC SDR	MULTI-POINT AVERAGING VELOCITY SENSOR, 1/2" THICK FIBERGLASS INSULATION, 22 GAUGE UNIT CASING, NEMA 1 WIRING ENCLOSURE, UL 21TV/1# TRANSFORMER, HOT WATER REHEAT COIL, MODULATING CONTROL VALVE PACKAGE INCLUDING ISOLATION BALL VALVES, UNIONS, AND P/T PORTS	10	2-WAY	1165	580	580	20.4	55	92	0.4	0.32	1.25	150	111	2	DIGITAL ELECTRONIC	1	64,58,55,52,48,45	N/A	54,45,44,37,31,29	18
VAV 611	ENVIRO-TEC SDR	MULTI-POINT AVERAGING VELOCITY SENSOR, 1/2" THICK FIBERGLASS INSULATION, 22 GAUGE UNIT CASING, NEMA 1 WIRING ENCLOSURE, UL 21TV/1# TRANSFORMER, HOT WATER REHEAT COIL, MODULATING CONTROL VALVE PACKAGE INCLUDING ISOLATION BALL VALVES, UNIONS, AND P/T PORTS	10	2-WAY	1270	640	640	21.3	55	90	0.4	0.31	1.25	150	115	2	DIGITAL ELECTRONIC	1	65,59,55,53,49,45	15	55,46,45,37,32,29	19
VAV 612	ENVIRO-TEC SDR	MULTI-POINT AVERAGING VELOCITY SENSOR, 1/2" THICK FIBERGLASS INSULATION, 22 GAUGE UNIT CASING, NEMA 1 WIRING ENCLOSURE, UL 21TV/1# TRANSFORMER, HOT WATER REHEAT COIL, MODULATING CONTROL VALVE PACKAGE INCLUDING ISOLATION BALL VALVES, UNIONS, AND P/T PORTS	12	3-WAY	1800	900	900	31.4	55	91	0.78	0.39	1.75	150	113	2	DIGITAL ELECTRONIC	1	66,59,56,53,49,46	16	53,48,44,37,33,29	18
VAV 613	ENVIRO-TEC SDR	MULTI-POINT AVERAGING VELOCITY SENSOR, 1/2" THICK FIBERGLASS INSULATION, 22 GAUGE UNIT CASING, NEMA 1 WIRING ENCLOSURE, UL 21TV/1# TRANSFORMER, HOT WATER REHEAT COIL, MODULATING CONTROL VALVE PACKAGE INCLUDING ISOLATION BALL VALVES, UNIONS, AND P/T PORTS	08	2-WAY	700	350	350	11.3	55	89	0.15	0.26	0.75	150	119	2	DIGITAL ELECTRONIC	1	64,58,54,51,47,43	16	56,45,44,39,34,21	18
VAV 614	ENVIRO-TEC SDR	MULTI-POINT AVERAGING VELOCITY SENSOR, 1/2" THICK FIBERGLASS INSULATION, 22 GAUGE UNIT CASING, NEMA 1 WIRING ENCLOSURE, UL 21TV/1# TRANSFORMER, HOT WATER REHEAT COIL, MODULATING CONTROL VALVE PACKAGE INCLUDING ISOLATION BALL VALVES, UNIONS, AND P/T PORTS	8	2-WAY	715	375	375	11.7	55	88	0.15	0.3	0.75	150	119	2	DIGITAL ELECTRONIC	1	56,45,44,39,34,21	16	64,58,54,51,47,43	18
VAV 615	ENVIRO-TEC SDR	MULTI-POINT AVERAGING VELOCITY SENSOR, 1/2" THICK FIBERGLASS INSULATION, 22 GAUGE UNIT CASING, NEMA 1 WIRING ENCLOSURE, UL 21TV/1# TRANSFORMER, HOT WATER REHEAT COIL, MODULATING CONTROL VALVE PACKAGE INCLUDING ISOLATION BALL VALVES, UNIONS, AND P/T PORTS	14	2-WAY	2,950	1,480	1,480	51.9	55	92	2.8	0.41	3	150	114	2	DIGITAL ELECTRONIC	1	68,60,59,54,50,41	19	55,55,46,40,35,31	20
VAV 616	ENVIRO-TEC SDR	MULTI-POINT AVERAGING VELOCITY SENSOR, 1/2" THICK FIBERGLASS INSULATION, 22 GAUGE UNIT CASING, NEMA 1 WIRING ENCLOSURE, UL 21TV/1# TRANSFORMER, HOT WATER REHEAT COIL, MODULATING CONTROL VALVE PACKAGE INCLUDING ISOLATION BALL VALVES, UNIONS, AND P/T PORTS	10	2-WAY	1,550	780	780	24.8	55	88.7	0.46	0.5	1.5	150	116	2	DIGITAL ELECTRONIC	1	67,61,57,54,50,41	18	51,48,46,39,33,29	20
VAV 617	ENVIRO-TEC SDR	MULTI-POINT AVERAGING VELOCITY SENSOR, 1/2" THICK FIBERGLASS INSULATION, 22 GAUGE UNIT CASING, NEMA 1 WIRING ENCLOSURE, UL 21TV/1# TRANSFORMER, HOT WATER REHEAT COIL, MODULATING CONTROL VALVE PACKAGE INCLUDING ISOLATION BALL VALVES, UNIONS, AND P/T PORTS	12	2-WAY	2,225	1,110	1,110	35.5	55	89	1	0.54	2	150	114	2	DIGITAL ELECTRONIC	1	68,61,58,54,51,41	19	54,49,46,39,33,29	20
VAV 618	ENVIRO-TEC SDR	MULTI-POINT AVERAGING VELOCITY SENSOR, 1/2" THICK FIBERGLASS INSULATION, 22 GAUGE UNIT CASING, NEMA 1 WIRING ENCLOSURE, UL 21TV/1# TRANSFORMER, HOT WATER REHEAT COIL, MODULATING CONTROL VALVE PACKAGE INCLUDING ISOLATION BALL VALVES, UNIONS, AND P/T PORTS	06	2-WAY	500	250	250	8.1	55	89.5	0.1	0.2	0.6	150	122	2	DIGITAL ELECTRONIC	1	66,62,55,52,46,44	20	57,52,48,41,35,29	22
VAV 619	ENVIRO-TEC SDR	MULTI-POINT AVERAGING VELOCITY SENSOR, 1/2" THICK FIBERGLASS INSULATION, 22 GAUGE UNIT CASING, NEMA 1 WIRING ENCLOSURE, UL 21TV/1# TRANSFORMER, HOT WATER REHEAT COIL, MODULATING CONTROL VALVE PACKAGE INCLUDING ISOLATION BALL VALVES, UNIONS, AND P/T PORTS	10	2-WAY	1,525	760	760	24.5	55	89.2	0.46	0.49	1.5	150	111	2	DIGITAL ELECTRONIC	1	67,51,57,54,50,41	18	51,48,46,39,33,29	20

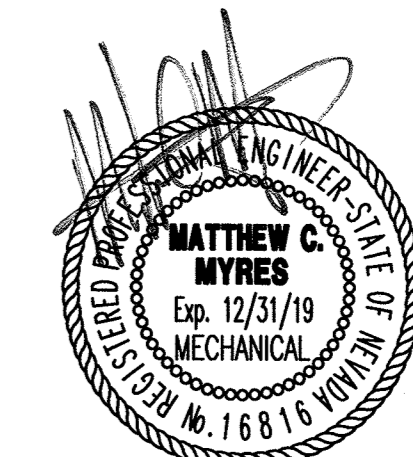

3/26/2018

BID DOCUMENTS

SPARKS POLICE DEPARTMENT
HVAC UPGRADE PHASE 1
1701 EAST PRATER WAY
SPARKS, NEVADA 89434


SHEET TITLE
MECHANICAL SCHEDULES (2)

REVISIONS

DATE: MARCH 26, 2018
SHEET NUMBER: 1
RECEIVED-CITY OF SPARKS
MAR 28 2018
COMMUNITY SERVICES BUILDING DIVISION

M0.3

MMI ENGINEERING
385 GENTRY WAY
RENO, NV. 89502
(775) 499-5784
WWW.MMI-ENGINEER.COM
MMI PROJECT #2016-19

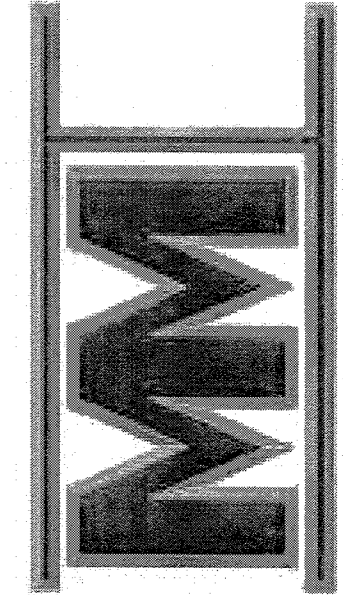

MMI ENGINEERING

DIFFUSER and REGISTER SCHEDULE

SYM	DESCRIPTION	MANUFACTURER and MODEL NUMBER	NECK SIZE	OBD	FINISH and MATERIAL	REMARKS
ES	EXISTING CEILING MOUNTED SUPPLY DIFFUSER	N/A	VARIABLE	N/A	VARIABLE	SEE PLANS FOR REBALANCE CFM
ER	EXISTING CEILING / WALL MOUNTED RETURN GRILLE	N/A	VARIABLE	N/A	VARIABLE	N/A
EE	EXISTING CEILING EXHAUST GRILLE	N/A	VARIABLE	N/A	VARIABLE	N/A
1	CEILING MOUNTED DIFFUSER, ROUND NECK, HIGH PERFORMANCE, 4 WAY THROW	PRICE ASFD SERIES	SEE PLANS	NO	WHITE ALUMINUM	24"x24" MODULE, COORDINATE FRAME TYPE WITH THE EXISTING CEILING CONDITIONS
2	CEILING SURFACE MOUNTED DIFFUSER, ROUND NECK, HIGH PERFORMANCE, 4 WAY THROW	PRICE 9FD-31 SERIES	SEE PLANS	NO	WHITE ALUMINUM	12"x12" MODULE, SURFACE MOUNTED FRAME TYPE
3	WALL MOUNTED SUPPLY GRILLE	PRICE 620DAL SERIES	SEE PLANS	NO	WHITE ALUMINUM	DOUBLE DEFLECTION LOUVER WITH ALUMINUM DAMPER
4	REMOVED EXHAUST GRILLE FROM SCHEDULE					
5	DUCT MOUNTED PERFORATED RETURN GRILLE	PRICE 9DGER SERIES	18" X 10"	NO	WHITE ALUMINUM	

GENERAL MECHANICAL NOTES

- DUE TO THE SMALL SCALE OF THE DRAWINGS, IT IS IMPOSSIBLE TO SHOW ALL REQUIRED OFFSETS, ELEVATIONS, ETC., IT IS THEREFORE THE CONTRACTOR'S RESPONSIBILITY TO VERIFY THE REQUIRED, ROUTING, ELEVATION, AND PLACEMENT OF EQUIPMENT AND PROVIDE REQUIRED OFFSETS INSTALLED IN ACCORDANCE WITH SMACNA STANDARDS AND THE SPECIFICATIONS TO MEET THE INTENT OF THE DESIGN.
- THIS CONTRACTOR SHALL BE RESPONSIBLE FOR THE CUTTING, SAUCUTTING OPENINGS OF WALLS, CEILING, SOFFITS AS REQUIRED FOR THE INSTALLATION OF EQUIPMENT AND DUCTWORK AS REQUIRED.
- ALL DUCTWORK IN CONCEALED AREAS SHALL HAVE 1/2" FIBERGLASS BLANKET INSULATION w/ ALL-SERVICE JACKET MANUFACTURED FROM KRAFT PAPER, REINFORCING SCRIM, ALUMINUM FOIL, AND VINYL FILM. INSULATION SHALL HAVE A MOLD, HUMIDITY, AND EROSION RESISTANT SURFACE THAT COMPLIES w/ THE CURRENT MECHANICAL CODE AND ASTM C553, TYPE II. INSULATION APPLIED TO THE EXTERIOR OF ANY DUCTS SHALL HAVE A FLAME SPREAD RATING THAT IS IN ACCORDANCE WITH NFPA 285, ASTM E84 OR UL T23, THE MATERIALS USED SHALL HAVE A FLAME-SPREAD RATING OF NOT MORE THAN 25 AND A SMOKE-DEVELOPED RATING OF NOT MORE THAN 50.
- ALL FACTORY PRODUCED AIR DUCT SHALL BE RATED FOR THE LISTED PRESSURES AND IN ACCORDANCE WITH THE ADOPTED MECHANICAL CODE. ALL DUCTWORK CONSTRUCTION SHALL BE IN STRICT ACCORDANCE WITH THE RECOMMENDATIONS AND REQUIREMENTS OF THE DUCT MANUAL AND SHEET METAL CONSTRUCTION FOR VENTILATING-AIR CONDITIONING SYSTEMS, LATEST EDITION, AS ISSUED BY THE SHEET METAL AND AIR CONDITIONING CONTRACTORS' NATIONAL ASSOCIATION, INC. (SMACNA). LOW PRESSURE ROUND DUCTS SHALL BE UNITED SHEET METAL SPIRAL UNIRIB DUCT WITH UNITED UNIWELDED FITTINGS. MATERIALS SHALL BE GALVANIZED STEEL OF GAUGES SHOWN IN THE LOW PRESSURE MANUAL UNLESS SPECIFICALLY NOTED OTHERWISE ON PLANS.
- THE CONTRACTOR SHALL KEEP INSTALLATION INSTRUCTIONS FOR ALL LISTED EQUIPMENT ON THIS PROJECT AT THE JOBSITE AND SHALL HAVE THEM ACCESSIBLE FOR THE FIELD INSPECTOR UPON REQUEST.
- INTERIOR CONDENSER WATER PIPING SHALL BE INSULATED WITH FIBERGLASS PIPE INSULATION WITH ALL SERVICE JACKET. 1" THICK ON PIPES SIZES UP TO AND INCLUDING 1 1/2". 1 1/2" THICK ON PIPE SIZES OVER 1 1/2". JACKET SHALL HAVE A SELF SEALING LAP AND A FLAME SPREAD RATING OF 25 OR LESS AND A SMOKE DEVELOPED RATING OF 50 OR LESS. INSULATE FITTINGS WITH PVC PRE-MOLDED INSULATED COVERS USING VAPOR BARRIER MASTIC AND TAPE. INSULATE ENTIRE SYSTEM INCLUDING VALVES, FLANGES, UNIONS, STRAINERS, FLEXIBLE CONNECTIONS, AND EXPANSION JOINTS.
- INTERIOR HOT WATER PIPING SHALL BE INSULATED WITH FIBERGLASS PIPE INSULATION WITH ALL SERVICE JACKET. 1/2" THICK ON PIPES SIZES UP TO AND INCLUDING 1 1/4". 2" THICK ON PIPE SIZES OVER 1 1/4". JACKET SHALL HAVE A SELF SEALING LAP AND A FLAME SPREAD RATING OF 25 OR LESS AND A SMOKE DEVELOPED RATING OF 50 OR LESS. INSULATE FITTINGS WITH PVC PRE-MOLDED INSULATED COVERS USING VAPOR BARRIER MASTIC AND TAPE. INSULATE FLANGES AND UNIONS.
- EXTERIOR HYDRONIC PIPING SHALL BE INSULATED WITH 1/2" THICK POLYISOCYANURATE FOAM PIPE INSULATION WITH ALUMINUM JACKET.
- CONTRACTOR TO REMOVE AND REPLACE SHEETROCK IN DESIGNATED LOCATIONS WHERE NECESSARY FOR VAV UNIT REPLACEMENTS PER CODE.

VAV BOX SCHEDULE

UNIT DESIGNATION	MAKE AND MODEL NUMBER	STANDARD FEATURES AND OPTIONAL ACCESSORIES	UNIT SIZE	CONTROL VALVE TYPE	MAX AIR FLOW (CFM) @ 1.0" W.G.	MIN AIR FLOW (CFM) @ 0.03" W.G.	REHEAT AIR VOLUME (CFM)	REHEAT COIL							CONTROLS	INLET STATIC (In wc)	DISCHARGE SOUND CRITERIA		RADIATED SOUND CRITERIA			
								CAPACITY (MBH)	EAT (°F)	LAT (°F)	W.P.D. (ft. wg)	COIL APD. (IN W.C.)	FLOW (GPM)	EAT (°F)			LAT (°F)	ROHS	SOUND PWR. LVL. (OCTAVES 2-7)	NC	SOUND PWR. LVL. (OCTAVES 2-7)	NC
VAV 99	ENVIRO-TEC SDR	MULTI-POINT AVERAGING VELOCITY SENSOR, 1/2" THICK FIBERGLASS INSULATION, 22 GAUGE UNIT CASING, NEMA 1 WIRING ENCLOSURE, UL 21TV/1# TRANSFORMER, HOT WATER REHEAT COIL, MODULATING CONTROL VALVE PACKAGE INCLUDING ISOLATION BALL VALVES, UNIONS, AND P/T PORTS	08	2-WAY	1000	500	500	15	55	81	0.23	0.46	1	150	119	2	DIGITAL ELECTRONIC	1	70,63,51,54,50,46	21	60,52,48,42,37,30	22
VAV 910	ENVIRO-TEC SDR	MULTI-POINT AVERAGING VELOCITY SENSOR, 1/2" THICK FIBERGLASS INSULATION, 22 GAUGE UNIT CASING, NEMA 1 WIRING ENCLOSURE, UL 21TV/1# TRANSFORMER, HOT WATER REHEAT COIL, MODULATING CONTROL VALVE PACKAGE INCLUDING ISOLATION BALL VALVES, UNIONS, AND P/T PORTS	10	2-WAY	1410	710	710	23.8	55	90	0.46	0.43	15	150	117	2	DIGITAL ELECTRONIC	1	67,61,51,54,50,47	18	57,48,46,39,33,29	20
VAV 911	ENVIRO-TEC SDR	MULTI-POINT AVERAGING VELOCITY SENSOR, 1/2" THICK FIBERGLASS INSULATION, 22 GAUGE UNIT CASING, NEMA 1 WIRING ENCLOSURE, UL 21TV/1# TRANSFORMER, HOT WATER REHEAT COIL, MODULATING CONTROL VALVE PACKAGE INCLUDING ISOLATION BALL VALVES, UNIONS, AND P/T PORTS	12	2-WAY	2125	1050	1050	30.1	55	86	0.2	0.5	2	150	119	2	DIGITAL ELECTRONIC	1	66,59,51,53,49,46	16	53,48,44,38,34,30	18
VAV 912	ENVIRO-TEC SDR	MULTI-POINT AVERAGING VELOCITY SENSOR, 1/2" THICK FIBERGLASS INSULATION, 22 GAUGE UNIT CASING, NEMA 1 WIRING ENCLOSURE, UL 21TV/1# TRANSFORMER, HOT WATER REHEAT COIL, MODULATING CONTROL VALVE PACKAGE INCLUDING ISOLATION BALL VALVES, UNIONS, AND P/T PORTS	10	2-WAY	1180	590	590	20.6	55	92	0.4	0.33	1.25	150	116	2	DIGITAL ELECTRONIC	1	64,58,55,52,48,45	N/A	54,45,44,37,31,29	18
VAV 913	ENVIRO-TEC SDR	MULTI-POINT AVERAGING VELOCITY SENSOR, 1/2" THICK FIBERGLASS INSULATION, 22 GAUGE UNIT CASING, NEMA 1 WIRING ENCLOSURE, UL 21TV/1# TRANSFORMER, HOT WATER REHEAT COIL, MODULATING CONTROL VALVE PACKAGE INCLUDING ISOLATION BALL VALVES, UNIONS, AND P/T PORTS	08	2-WAY	625	300	300	9.5	55	89	0.04	0.21	1	150	131	2	DIGITAL ELECTRONIC	1	54,44,43,38,33,26	15	62,51,52,50,46,42	16


2 REMOVED EXHAUST FAN SCHEDULE

FLUID COOLER SCHEDULE

SYM	DESCRIPTION	MAKE & MODEL NO.	CAPACITY	FLOW (GPM)	HP / KW	ELEC.	DRY WT.
FC 12	AIR COOLED, DIRECT DRIVE DRYCOOLER 30% PROPYLENE GLYCOL SOLUTION	LIEBERT MODEL# DDC00139	VERIFIED BY MANUFACTURER TO BE COMPATIBLE WITH (E) LIEBERT (AC-1) AND (E) LIEBERT (AC-2) SERVER ROOM UNITS	(E) AC-1: 9.9 (E) AC-2: 20.8	(2) 3/4 HP PUMPS	460V/3#, 1.6 FLA	500 LBS
FC 3	AIR COOLED, DIRECT DRIVE DRYCOOLER 30% PROPYLENE GLYCOL SOLUTION	LIEBERT MODEL# DDC00114	VERIFIED BY MANUFACTURER TO BE COMPATIBLE WITH LIEBERT (AC-3) SERVER ROOM UNITS	AC-3: 13.0	(2) 3/4 HP PUMPS	460V/3#, 1.6 FLA	540 LBS

SERVER ROOM UNIT

SYM	DESCRIPTION	MAKE & MODEL NO.	CAPACITY	FLOW (GPM)	EAT (°F)	FLUID	ELEC.	WT.	OPTIONS	NOTES
AC 3	WATER COOLED COMPUTER ROOM COOLING SYSTEM	LIEBERT MODEL# CRO20RJIATV824	TOTAL: 65200 BTUH SENSIBLE: 64900 BTUH	13.0 @ 24.0 W.P.D.	104.4	30% PROPYLENE-GLYCOL	460V/3#, 32.2 FLA	172 LBS	DUAL-FLOAT CONDENSATE PUMP, HUMIDIFIER, ELECTRIC REHEAT	DRAIN CONDENSATE TO (E) FLOOR DRAIN LOCATED BELOW RAISED FLOOR IN COMPUTER EQUIPMENT-124

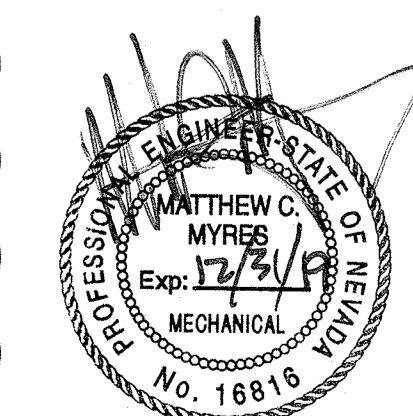

SPARKS POLICE DEPARTMENT
HVAC UPGRADE PHASE 1
1701 EAST PRATER WAY
SPARKS, NEVADA 89434

SHEET TITLE
MECHANICAL SCHEDULES (3)


REVISIONS

1	PLAN REVIEW COMMENTS (04/09/18)
2	OWNER REVISIONS (10/31/18)
3	OWNER REVISIONS (06/04/19)

DATE: CITY OF SPARKS
COMMUNITY SERVICES BLDG. DIV.
MARCH 26, 2018
SHEET NUMBER: JUN 07 2019


REVISED
MO.4

MMI ENGINEERING
385 GENTRY WAY
RENO, NV, 89502
(775) 499-5784
WWW.MMIENGINEERING.COM
MMI PROJECT #2016-19

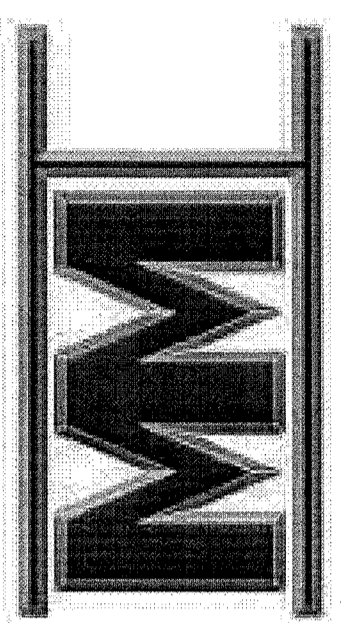


MMI ENGINEERING

BID DOCUMENTS

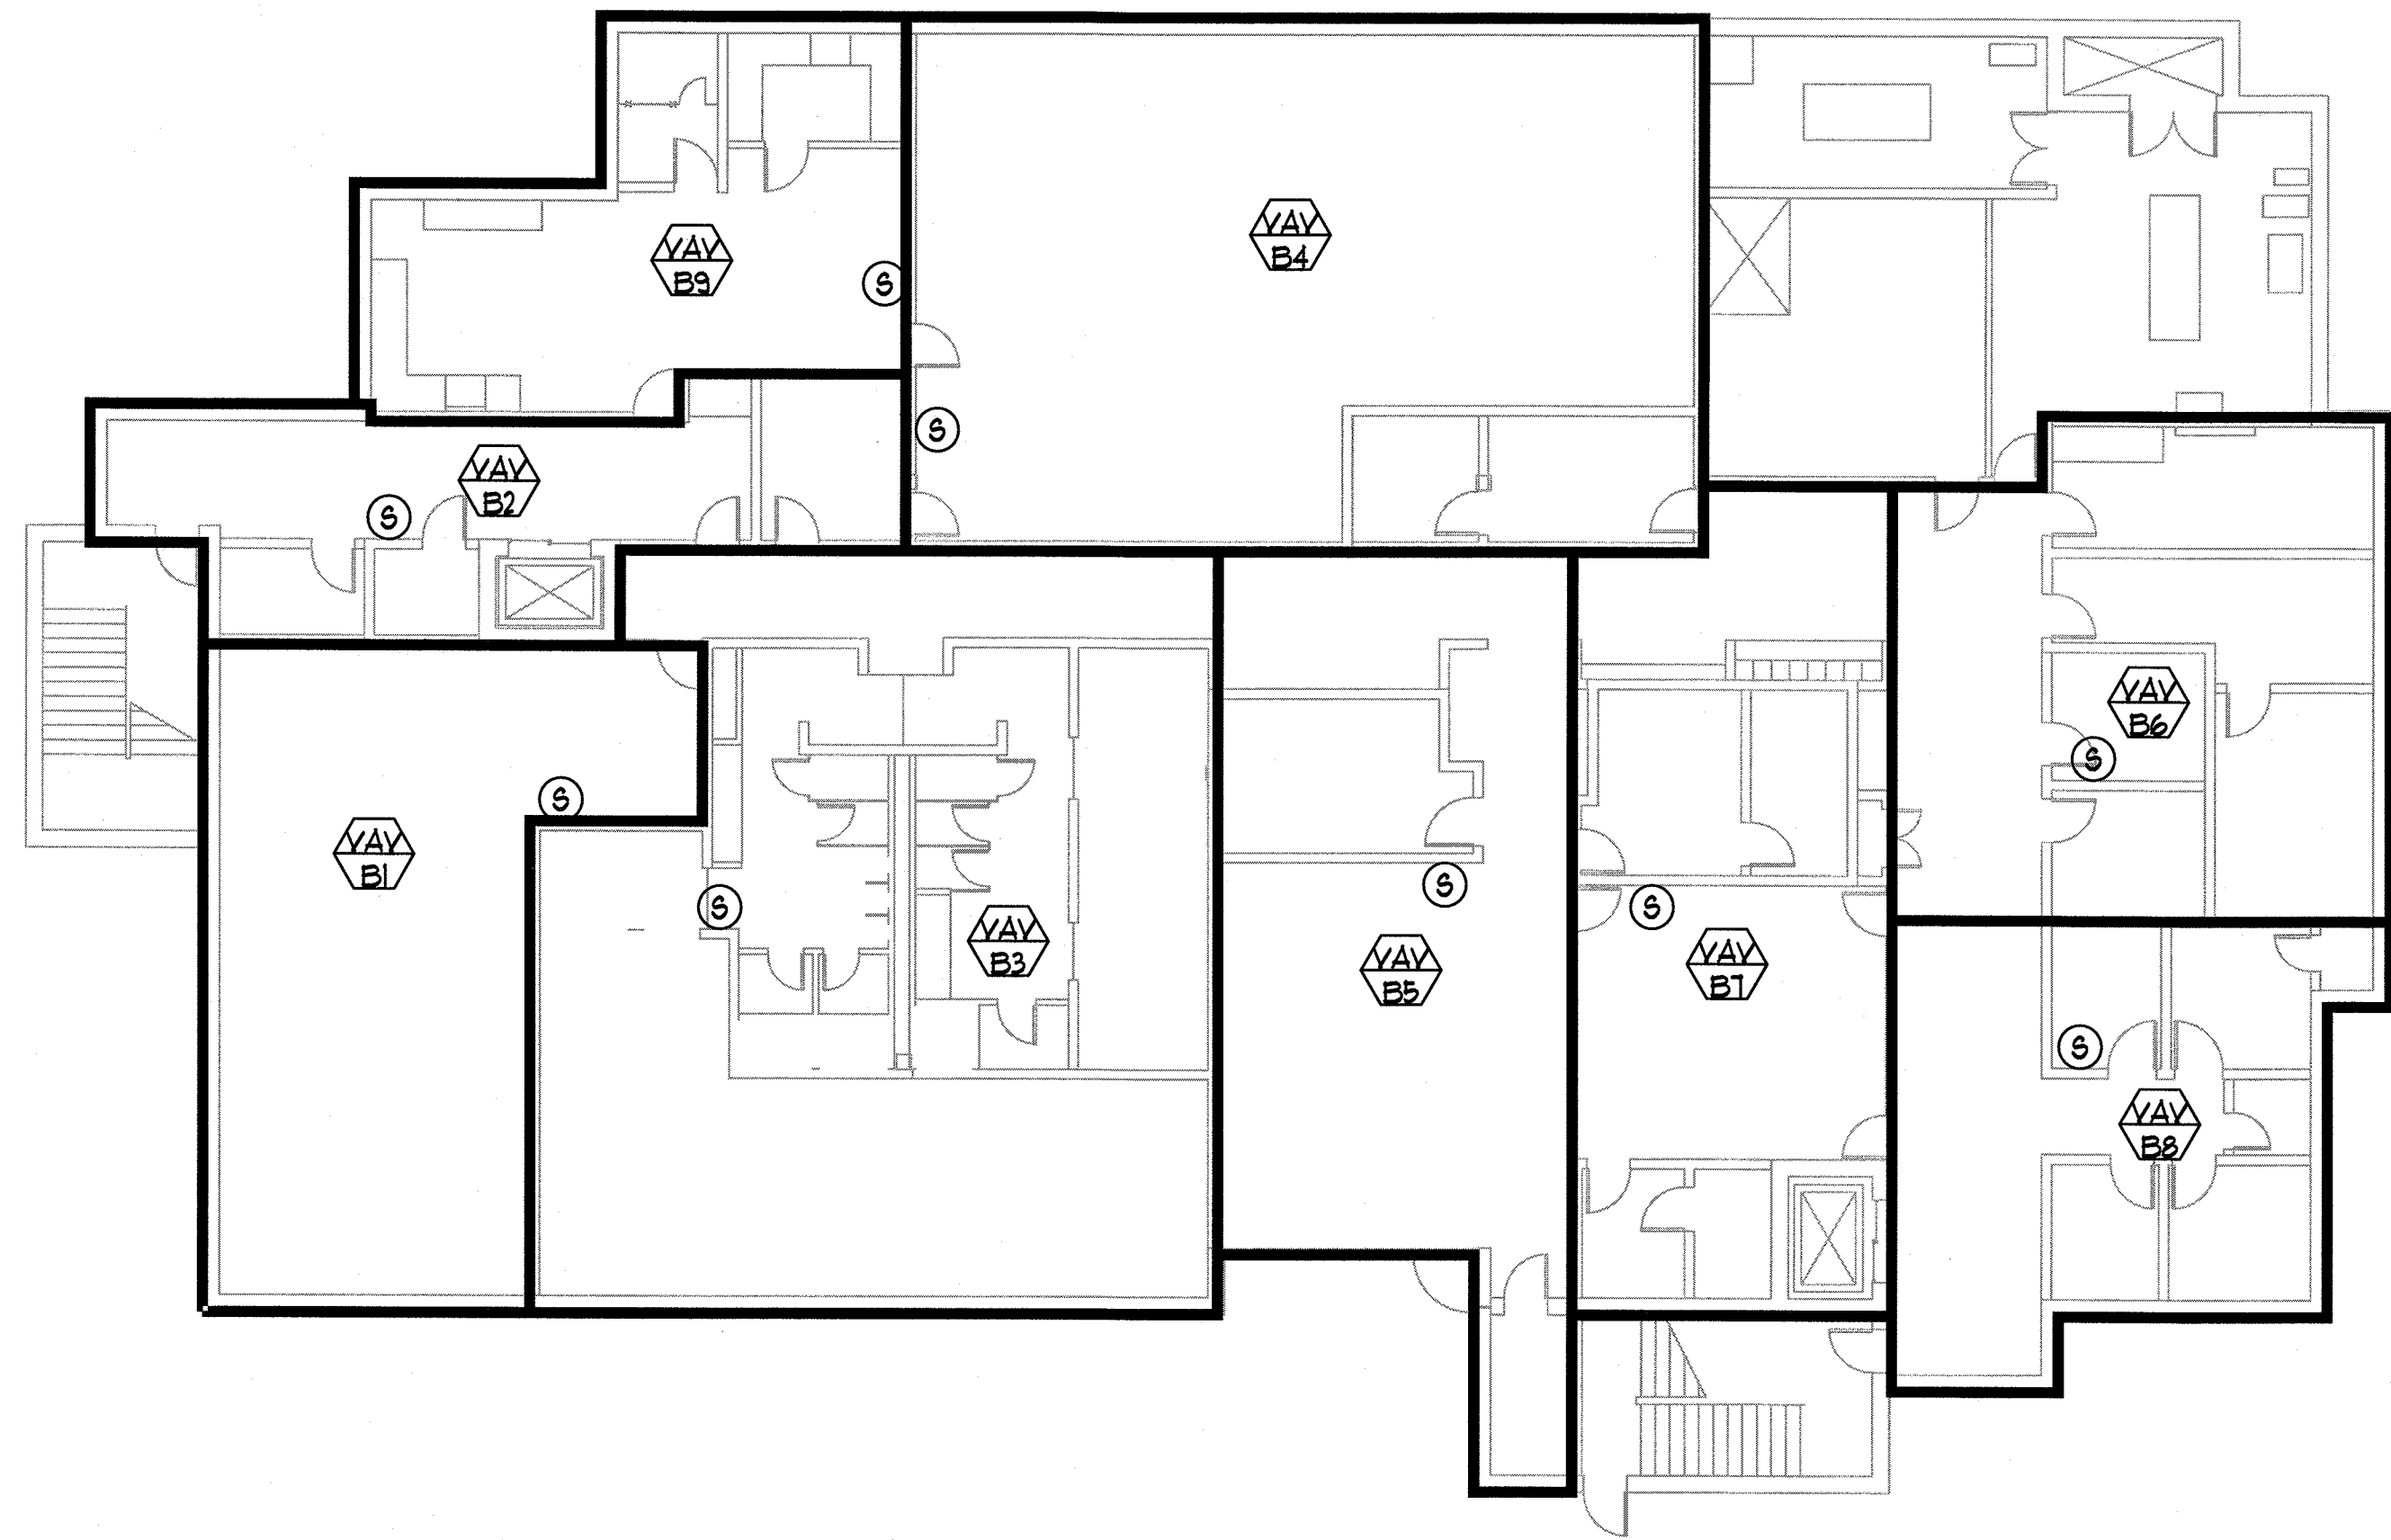


1 MECHANICAL ZONE PLAN - BASEMENT
MO.9 SCALE: NONE

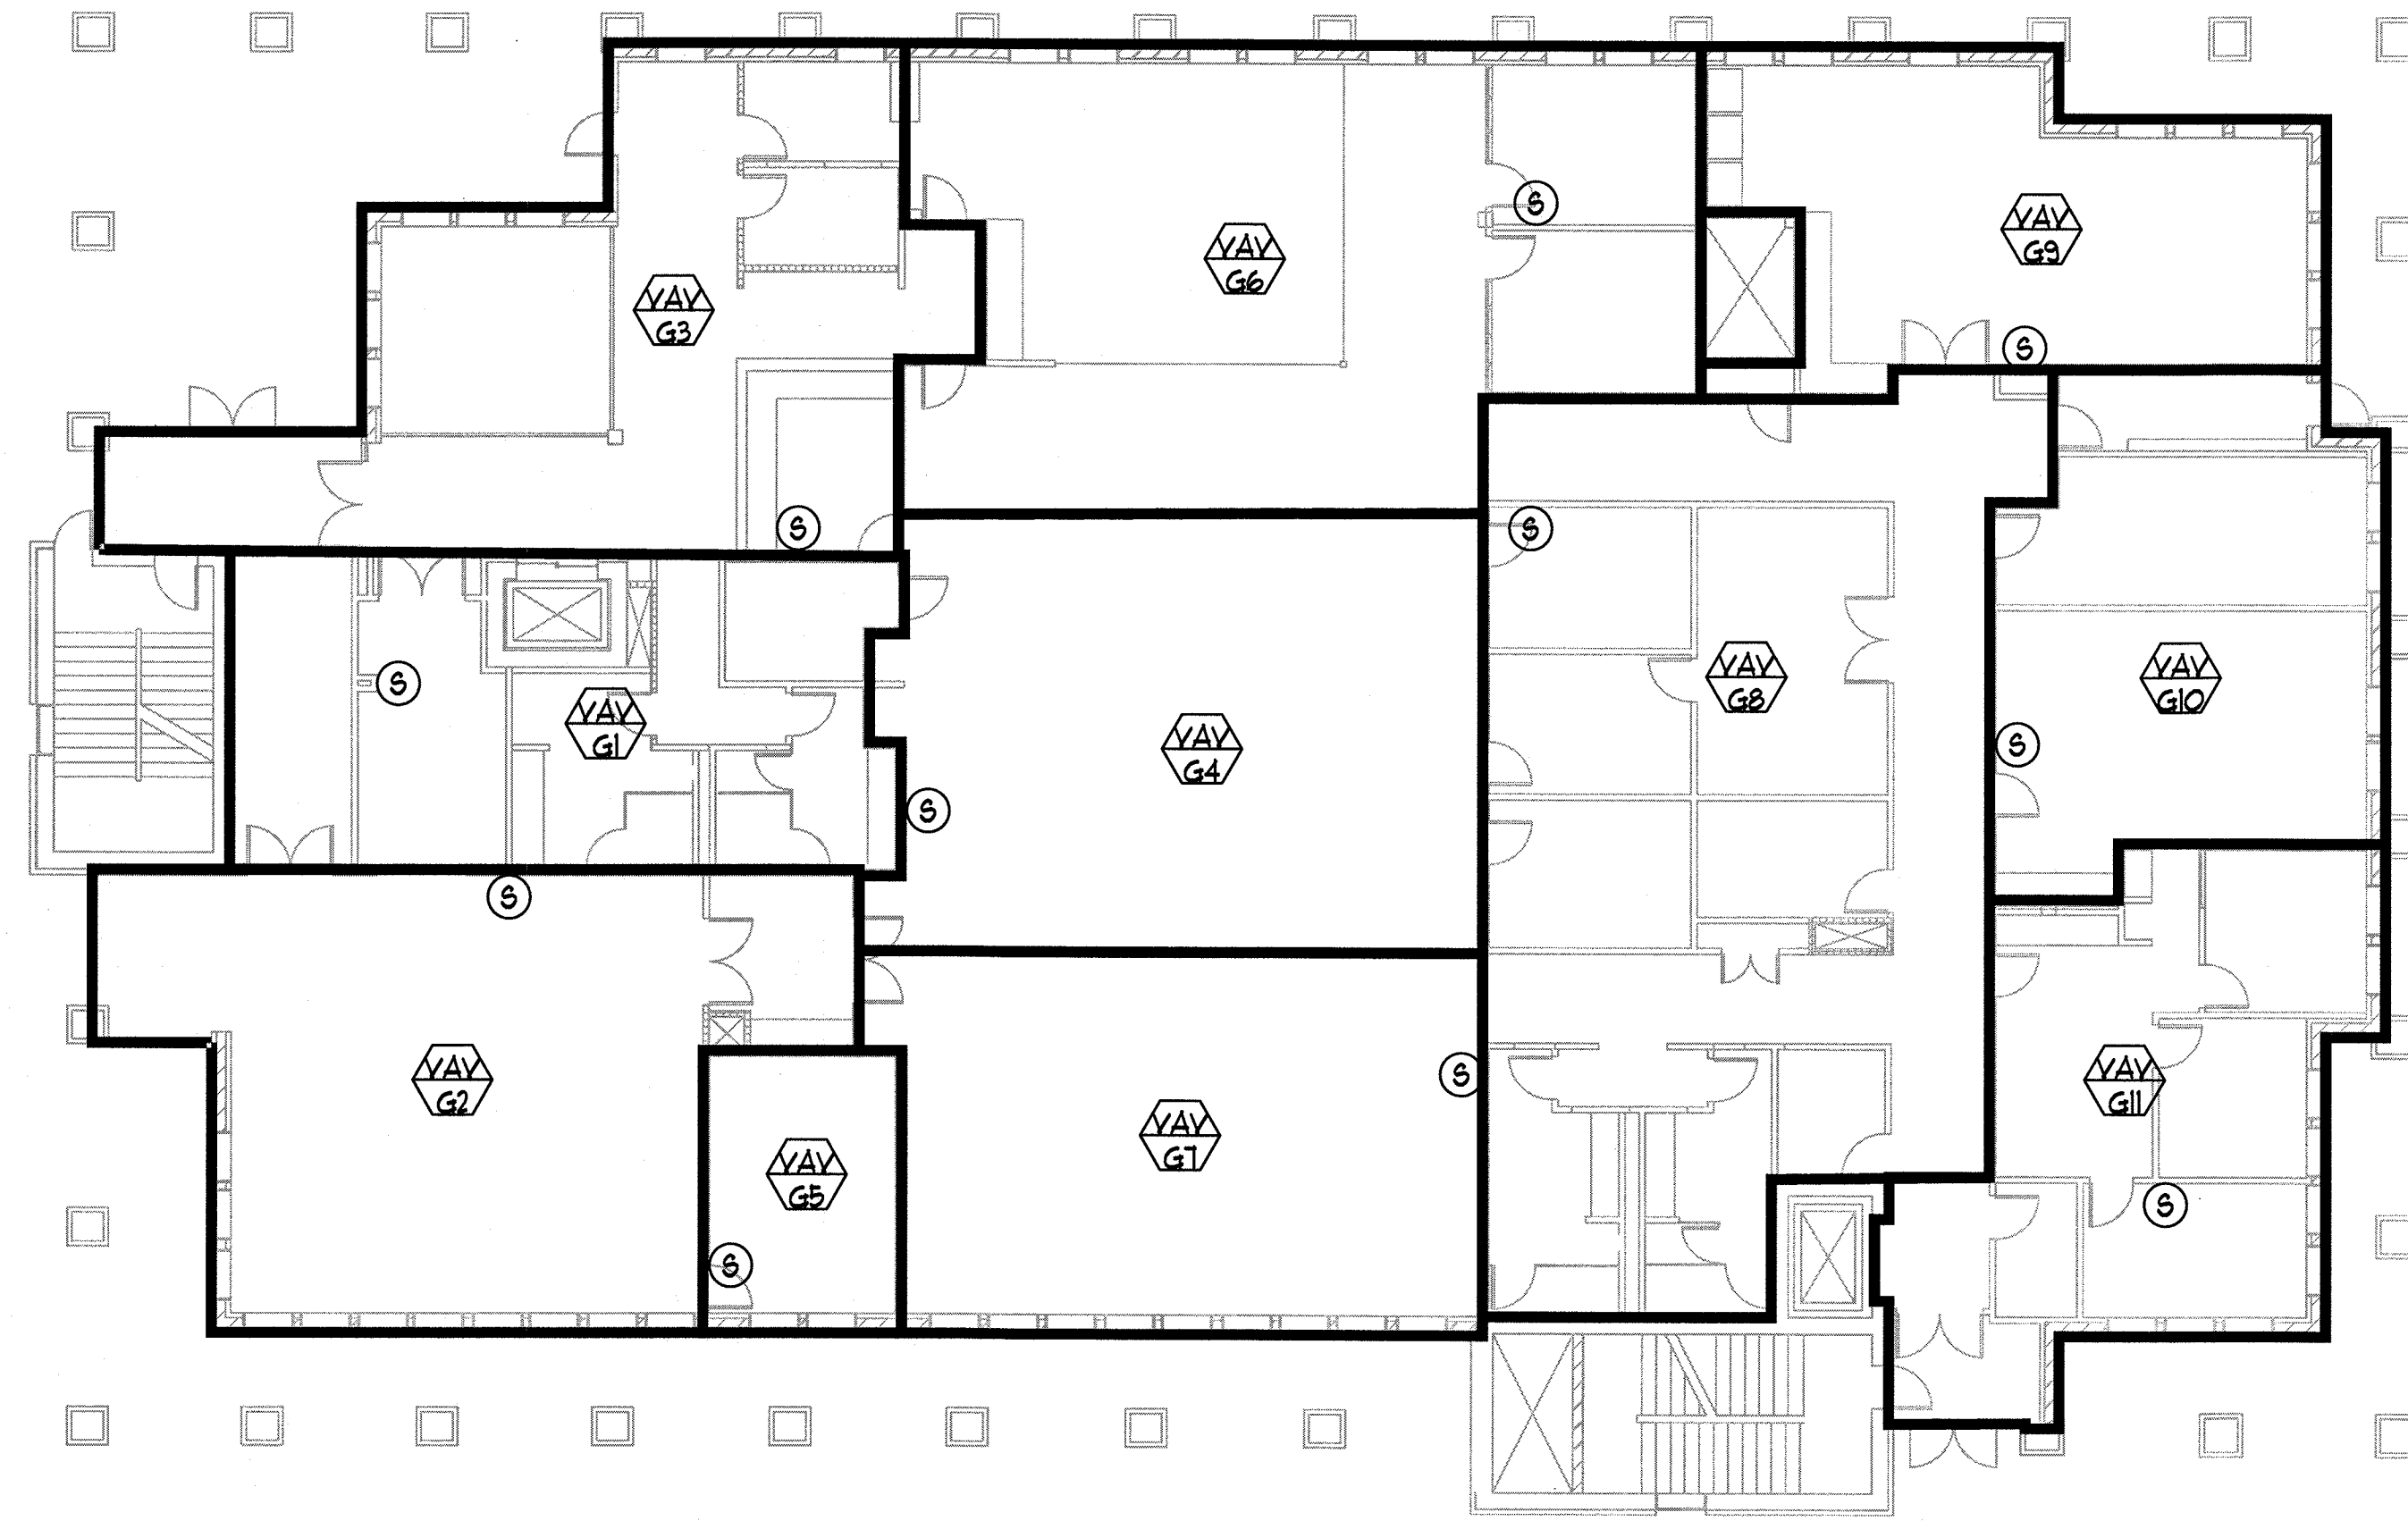


2 MECHANICAL ZONE PLAN - FIRST FLOOR
MO.9 SCALE: NONE

GENERAL NOTE:

1. ALL (E) ROOM TEMPERATURE SENSORS ARE TO REMAIN AND ARE TO BE CONNECTED TO (N) VAV'S. SEE CONTROL DRAWINGS FOR MORE INFORMATION.

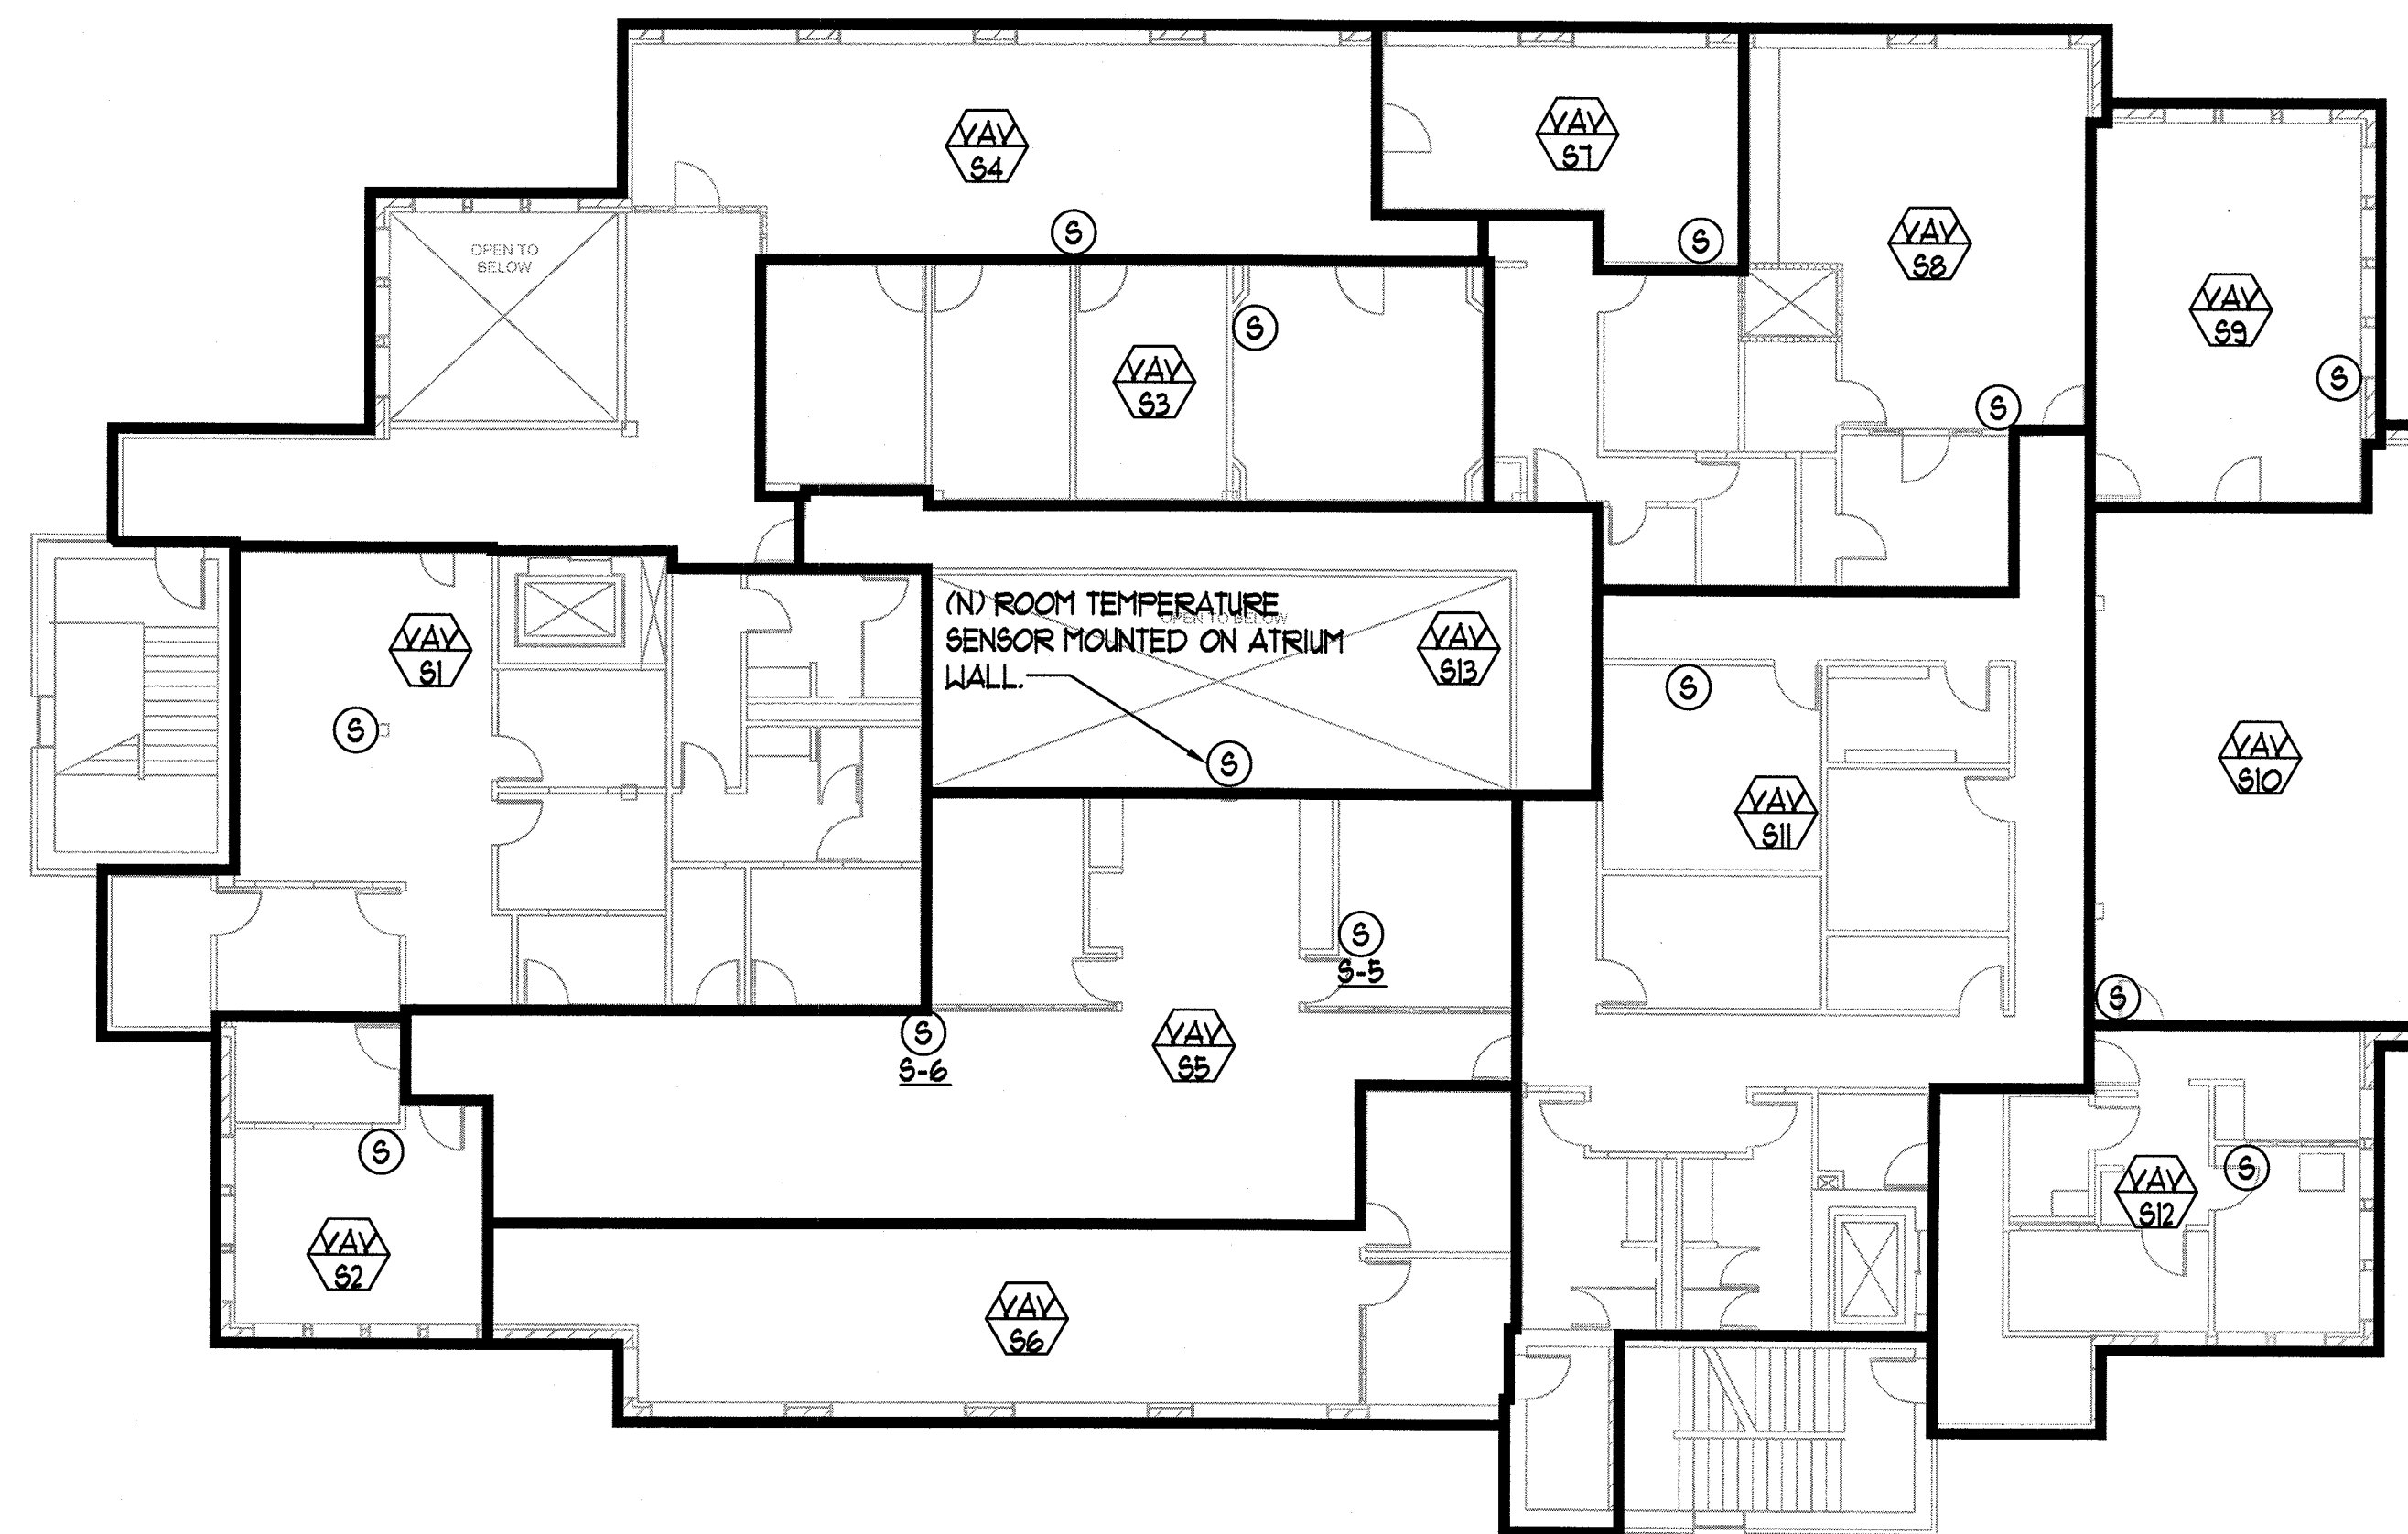


3 MECHANICAL ZONE PLAN - SECOND FLOOR
MO.9 SCALE: NONE

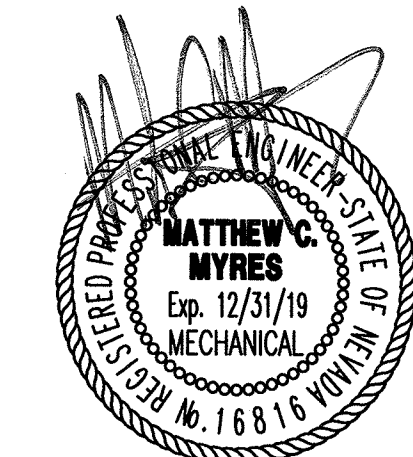

3/26/2018

MMI ENGINEERING
385 GENTRY WAY
RENO, NV. 89502
(775) 499-5784
WWW.MMI-DESIGNER.COM
MMI PROJECT #2016-19

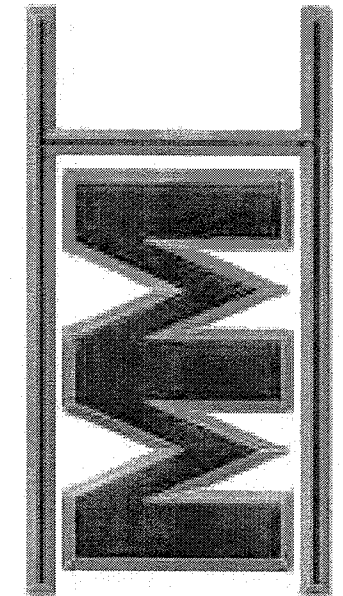

MMI ENGINEERING

SPARKS POLICE DEPARTMENT
HVAC UPGRADE PHASE 1
1701 EAST PRATER WAY
SPARKS, NEVADA 89434


SHEET TITLE
MECHANICAL ZONE PLAN

REVISIONS

BID DOCUMENTS

DATE: MARCH 26, 2018
SHEET NUMBER: M0.9
RECEIVED-CITY OF SPARKS
MAR 28 2018
COMMUNITY SERVICES
BUILDING DIVISION

M0.9

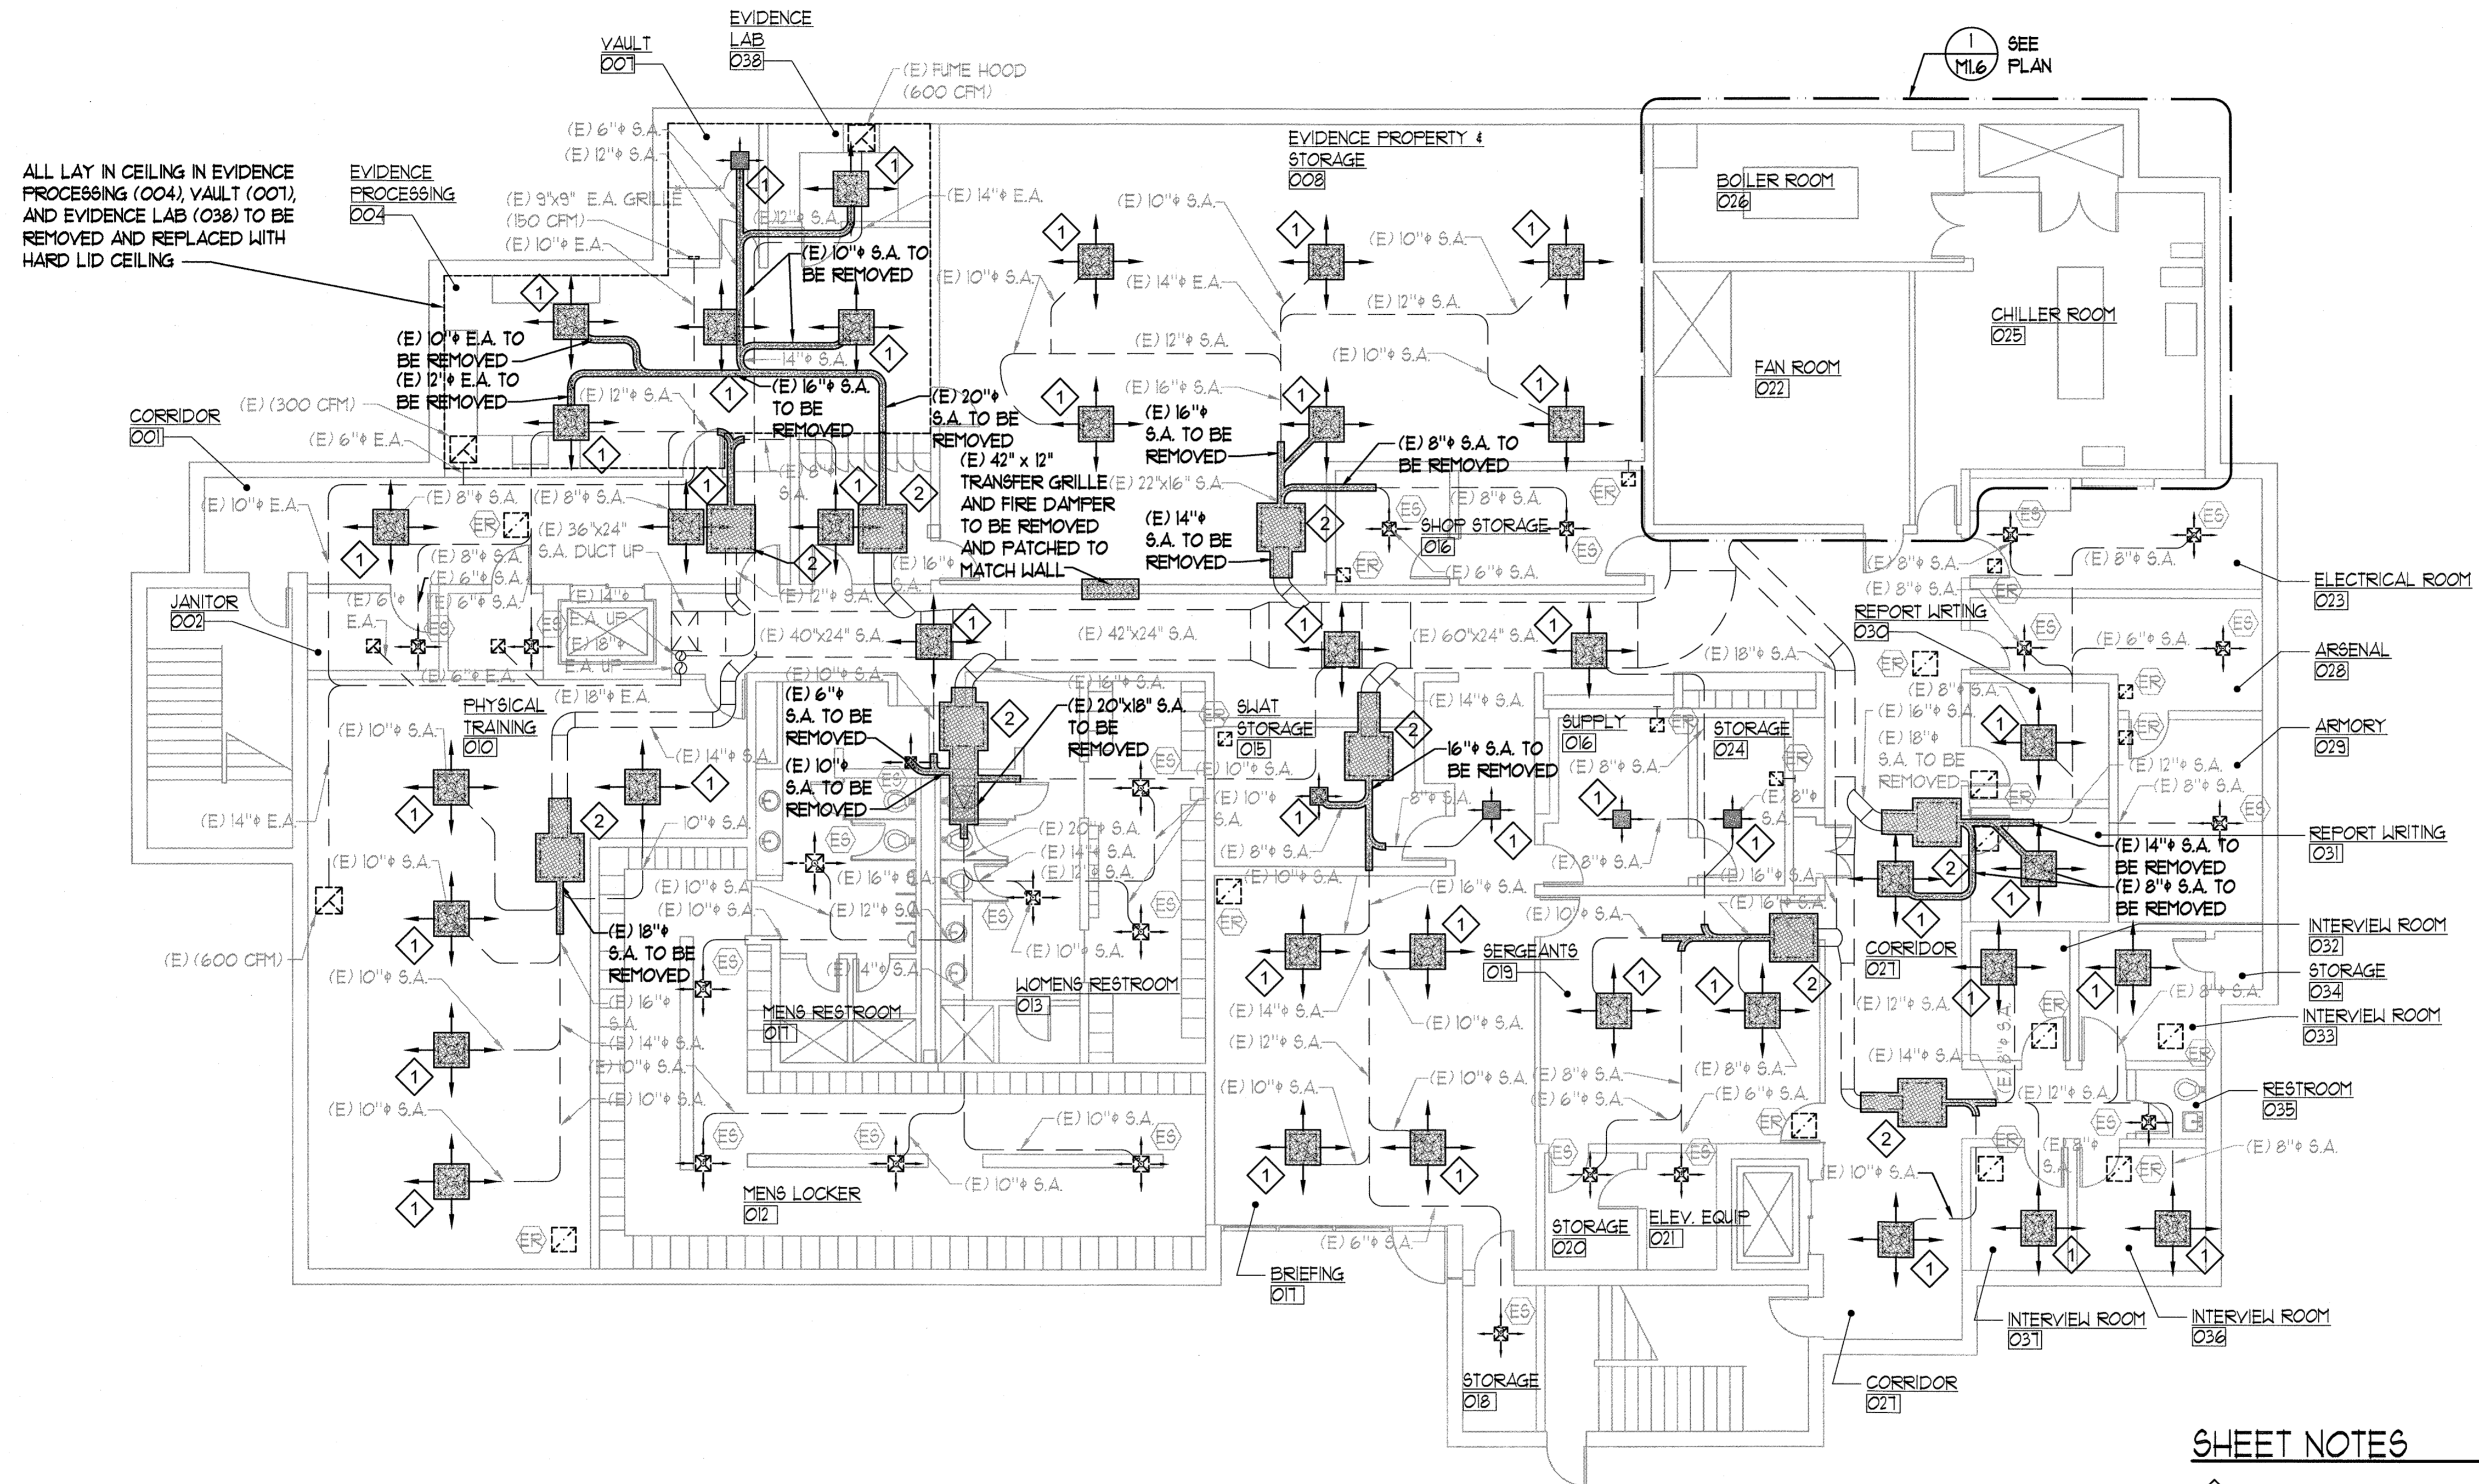


ALL LAY IN CEILING IN EVIDENCE PROCESSING (004), VAULT (001), AND EVIDENCE LAB (038) TO BE REMOVED AND REPLACED WITH HARD LID CEILING

1 MECHANICAL DEMOLITION FLOOR PLAN - BASEMENT
 M1.0 SCALE: 1/8" = 1'-0"

- SHEET NOTES**
- 1 SUPPLY AIR DIFFUSERS AND ASSOCIATED FLEX DUCTWORK TO BE REMOVED
 - 2 FAN POWER TERMINAL UNIT AND ASSOCIATED 3-WAY CONTROL VALVE PIPING PACKAGE TO BE REMOVED. ALERTON CONTROLLER TO BE REMOVED AND SAVED FOR REINSTALLATION ON NEW EQUIPMENT. PREP DUCTWORK FOR CONNECTION TO NEW EQUIPMENT.

MMI ENGINEERING
 385 GENTRY WAY
 RENO, NV. 89502
 (775) 499-5784
 WWW.MMI-DESIGNER.COM
 MMI PROJECT #2016-19

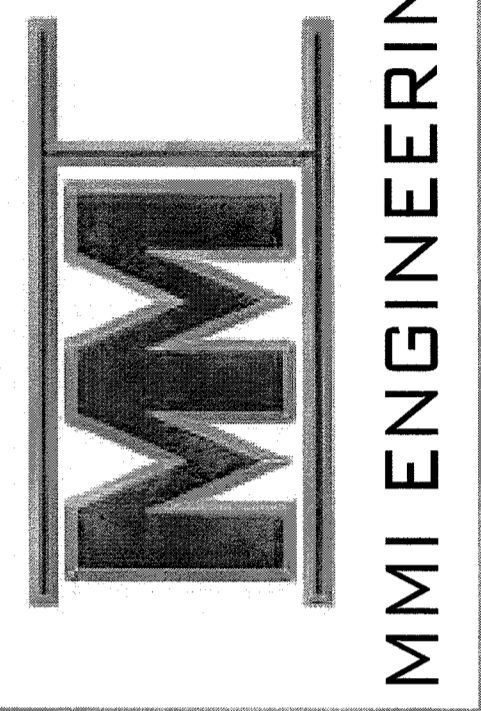


SPARKS POLICE DEPARTMENT
 HVAC UPGRADE PHASE 1
 1701 EAST PRATER WAY
 SPARKS, NEVADA 89434

SHEET TITLE
 MECHANICAL DEMOLITION
 FLOOR PLAN - BASEMENT

REVISIONS

NO.	DESCRIPTION

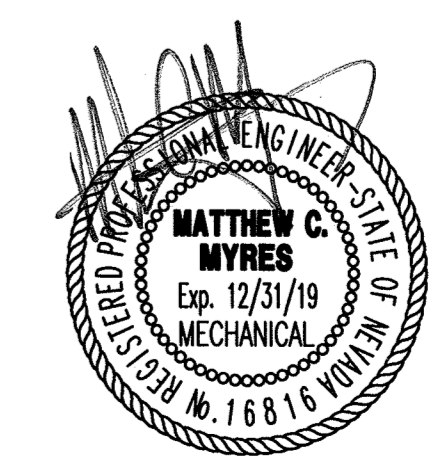


BID DOCUMENTS

DATE: MARCH 26, 2018 RECEIVED-CITY OF SPARKS
 SHEET NUMBER: M1.0 MAR 28 2018
 COMMUNITY SERVICES BUILDING DIVISION

M1.0


3/26/2018

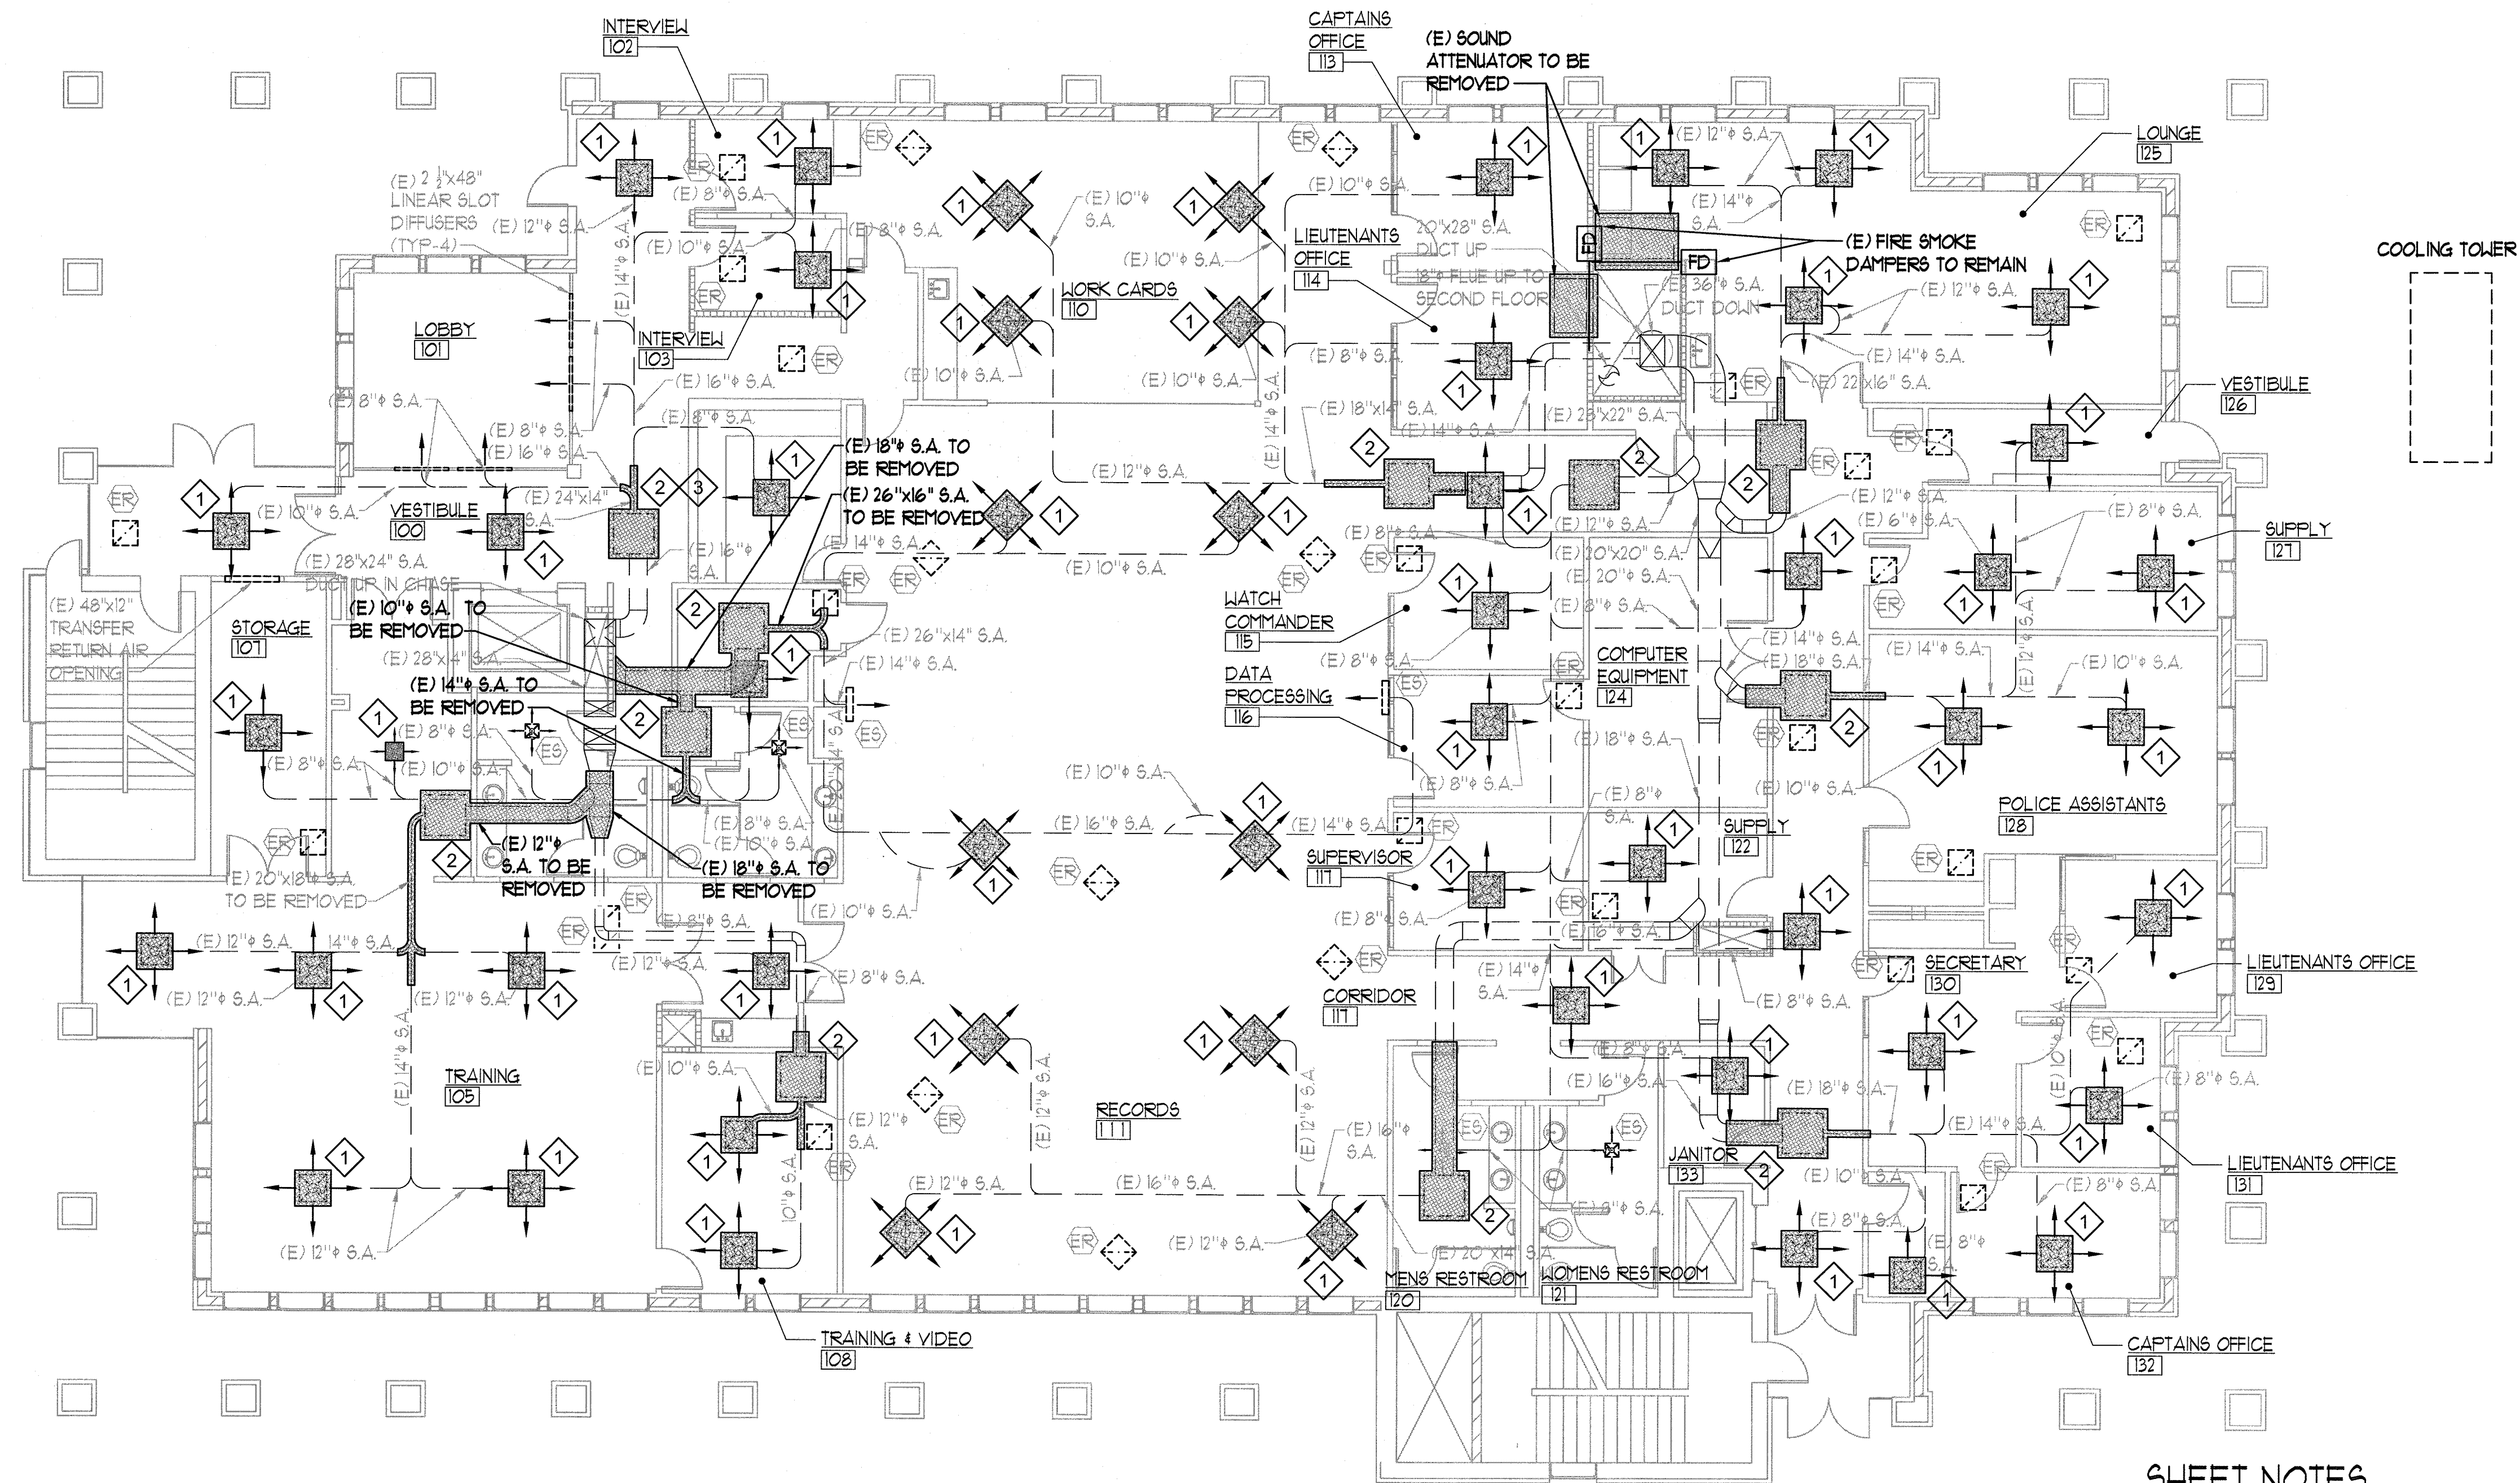

SHEET NOTES

- 1 SUPPLY AIR DIFFUSERS AND ASSOCIATED FLEX DUCTWORK TO BE REMOVED
- 2 FAN POWER TERMINAL UNIT AND ASSOCIATED 3-WAY CONTROL VALVE PIPING PACKAGE TO BE REMOVED. ALERTON CONTROLLER TO BE REMOVED AND SAVED FOR REINSTALLATION ON NEW EQUIPMENT. PREP DUCTWORK FOR CONNECTION TO NEW EQUIPMENT.
- 3 UNABLE TO VERIFY EXACT LOCATION OF THIS FAN POWER TERMINAL UNIT. CONTRACTOR TO VERIFY LOCATION AND COORDINATION REMOVAL WITH THE ENGINEER

1
M.I.1
MECHANICAL DEMOLITION FLOOR PLAN - GROUND FLOOR
SCALE: 1/8" = 1'-0"

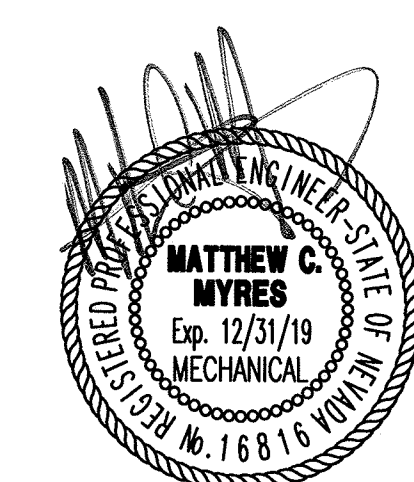

BID DOCUMENTS


MMI ENGINEERING
385 GENTRY WAY
RENO, NV. 89502
(775) 499-5784
WWW.MMIE-DESIGNER.COM
MMI PROJECT #2016-19

**SPARKS POLICE DEPARTMENT
HVAC UPGRADE PHASE 1
1701 EAST PRATER WAY
SPARKS, NEVADA 89434**

SHEET TITLE
MECHANICAL DEMOLITION
FLOOR PLAN - GROUND
FLOOR


REVISIONS

DATE: MARCH 26, 2018
RECEIVED-CITY OF SPARKS
SHEET NUMBER: MAR 28 2018
COMMUNITY SERVICES
BUILDING DIVISION
M1.1

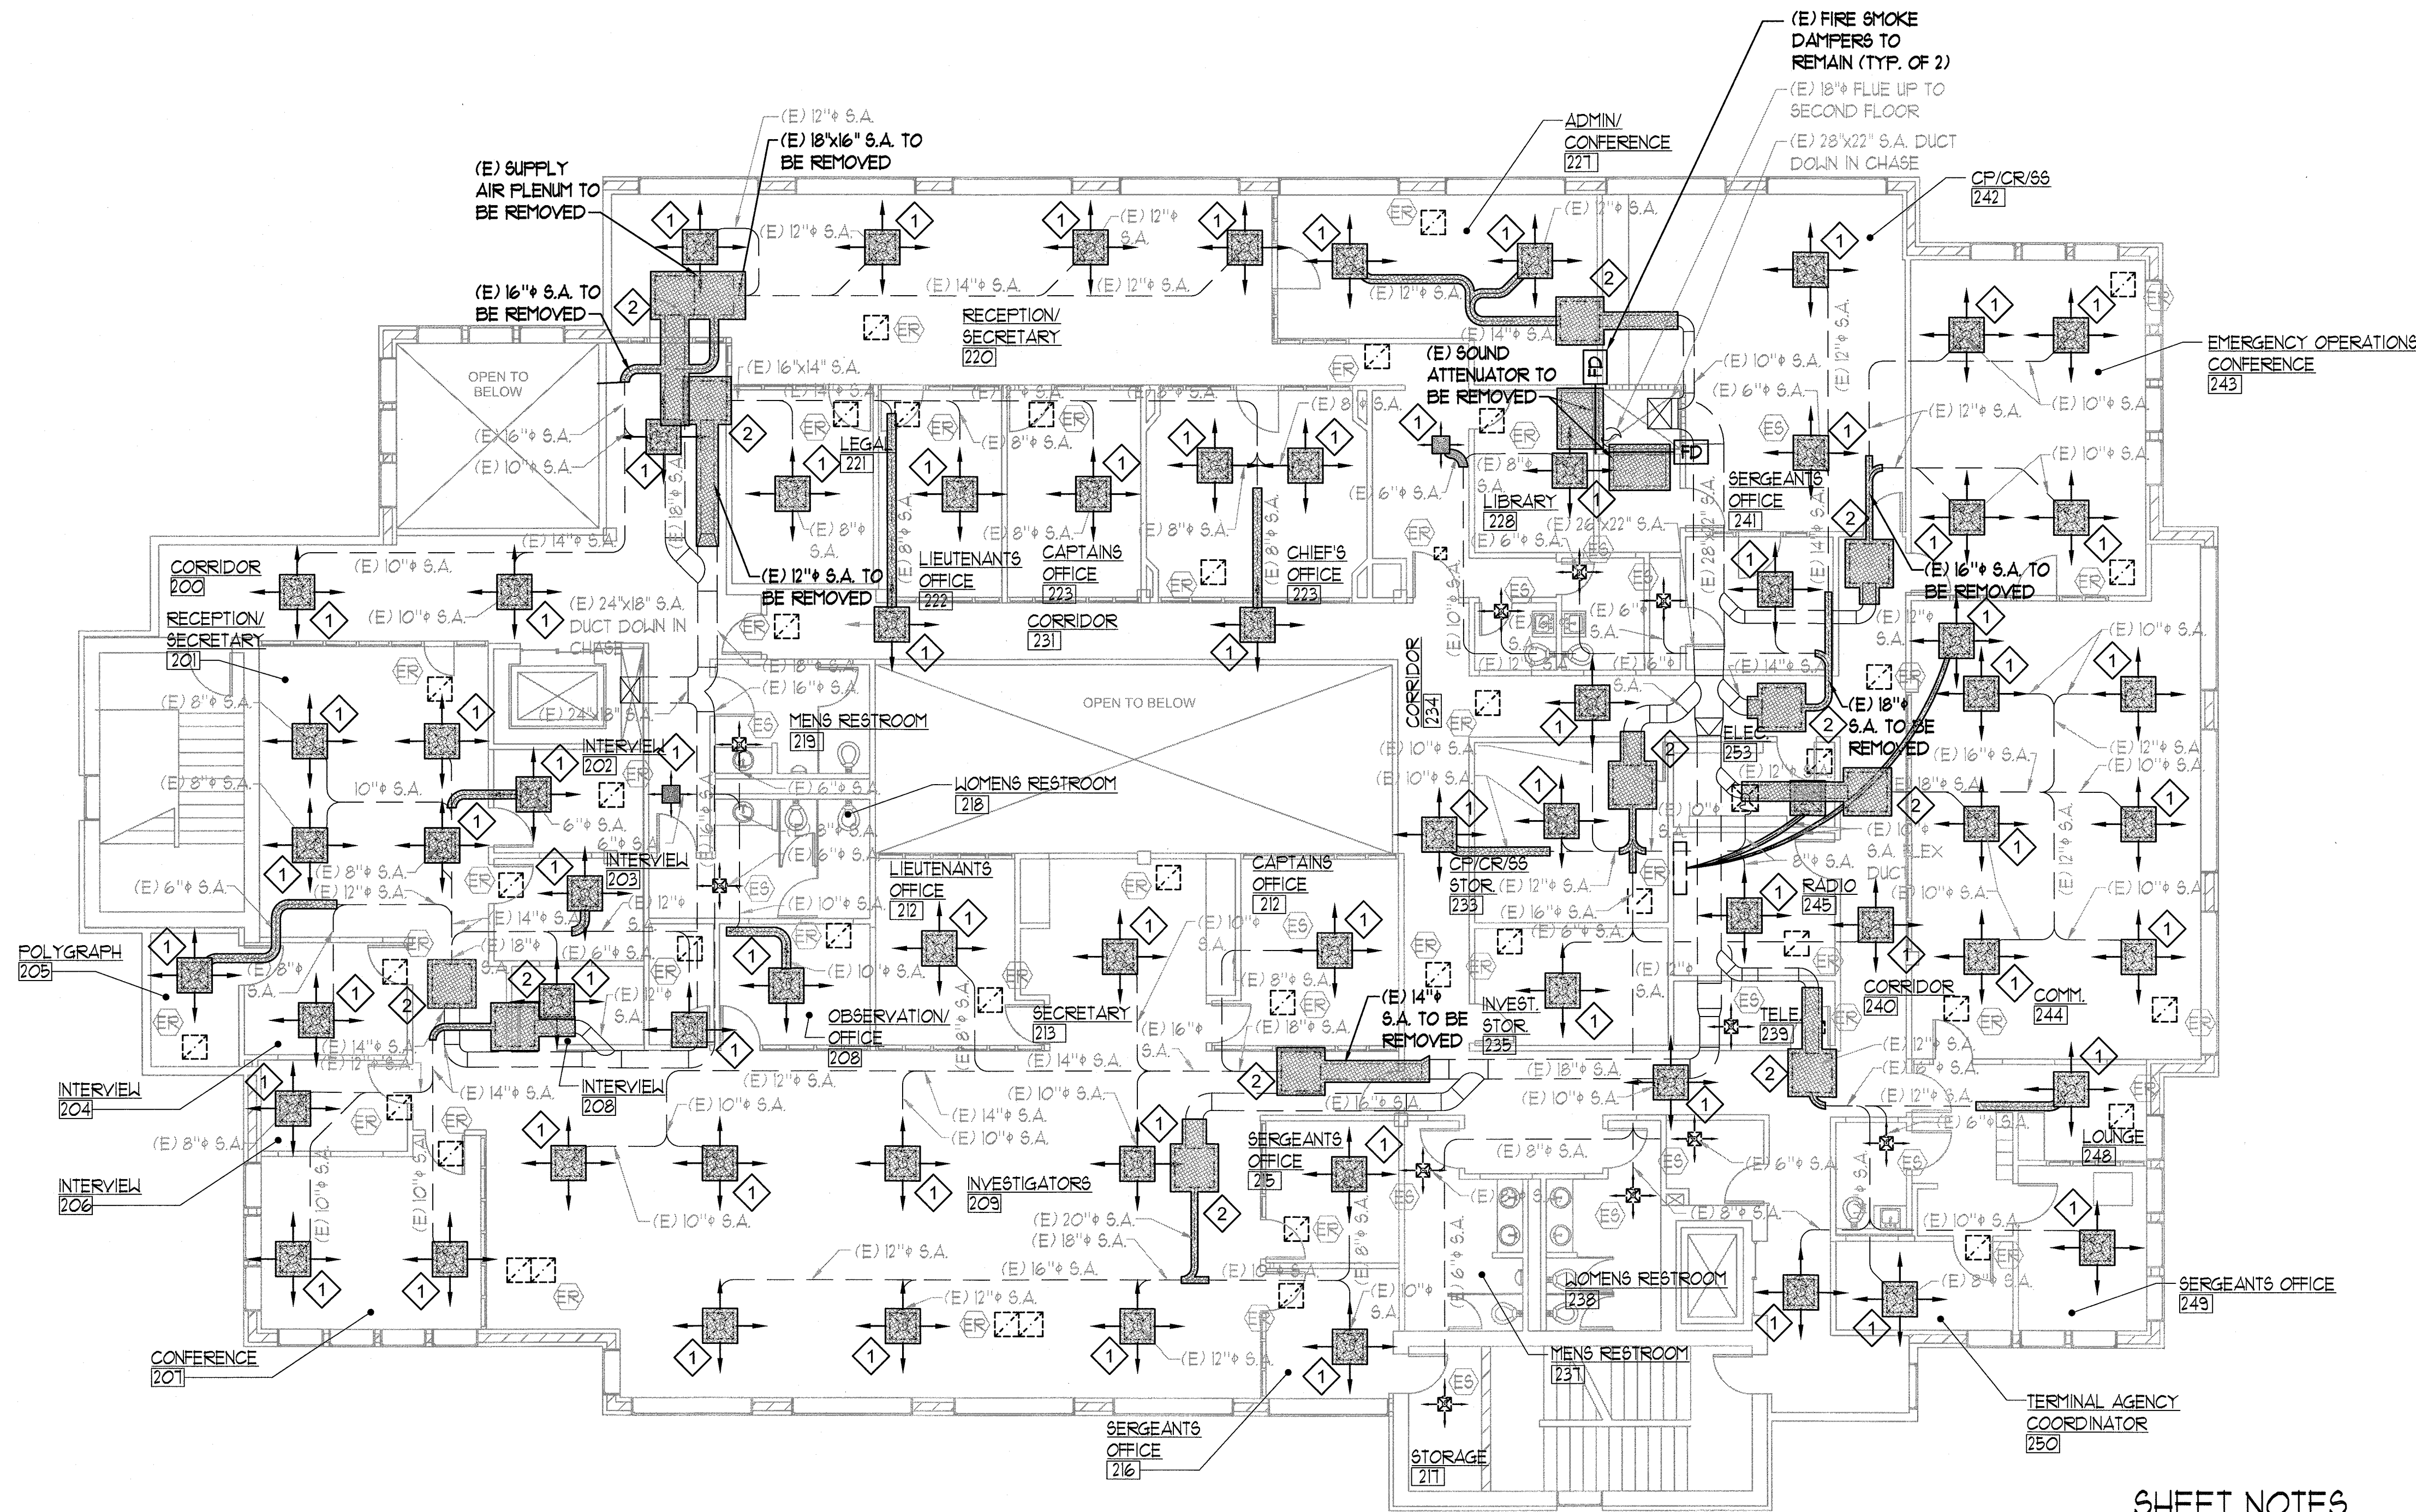


- SHEET NOTES**
- 1 SUPPLY AIR DIFFUSERS AND ASSOCIATED FLEX DUCTWORK TO BE REMOVED
 - 2 FAN POWER TERMINAL UNIT AND ASSOCIATED 3-WAY CONTROL VALVE PIPING PACKAGE TO BE REMOVED. ALERTON CONTROLLER TO BE REMOVED AND SAVED FOR REINSTALLATION ON NEW EQUIPMENT. PREP DUCTWORK FOR CONNECTION TO NEW EQUIPMENT.

1 M1.2 MECHANICAL DEMOLITION FLOOR PLAN - SECOND FLOOR
 SCALE: 1/8" = 1'-0"

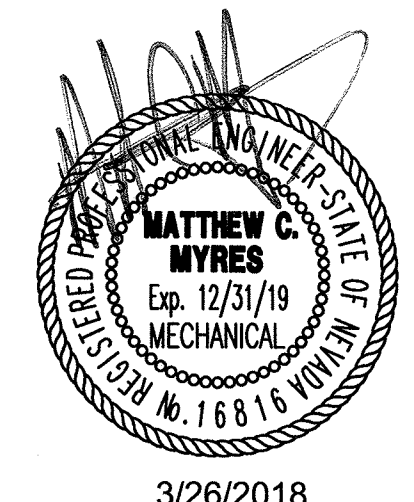

BID DOCUMENTS

MMI ENGINEERING
 385 GENTRY WAY
 RENO, NV. 89502
 (775) 499-5784
 WWW.MMI-ENGINEER.COM
 MMI PROJECT #2016-19

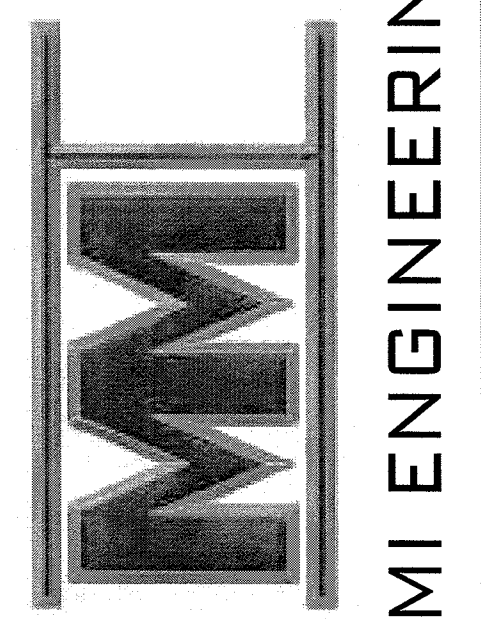


SPARKS POLICE DEPARTMENT
 HVAC UPGRADE PHASE 1
 1701 EAST PRATER WAY
 SPARKS, NEVADA 89434

SHEET TITLE
 MECHANICAL DEMOLITION
 FLOOR PLAN - SECOND
 FLOOR

REVISIONS


DATE: MARCH 26, 2018
 SHEET NUMBER: M1.2
 COMMUNITY SERVICES
 BUILDING DIVISION

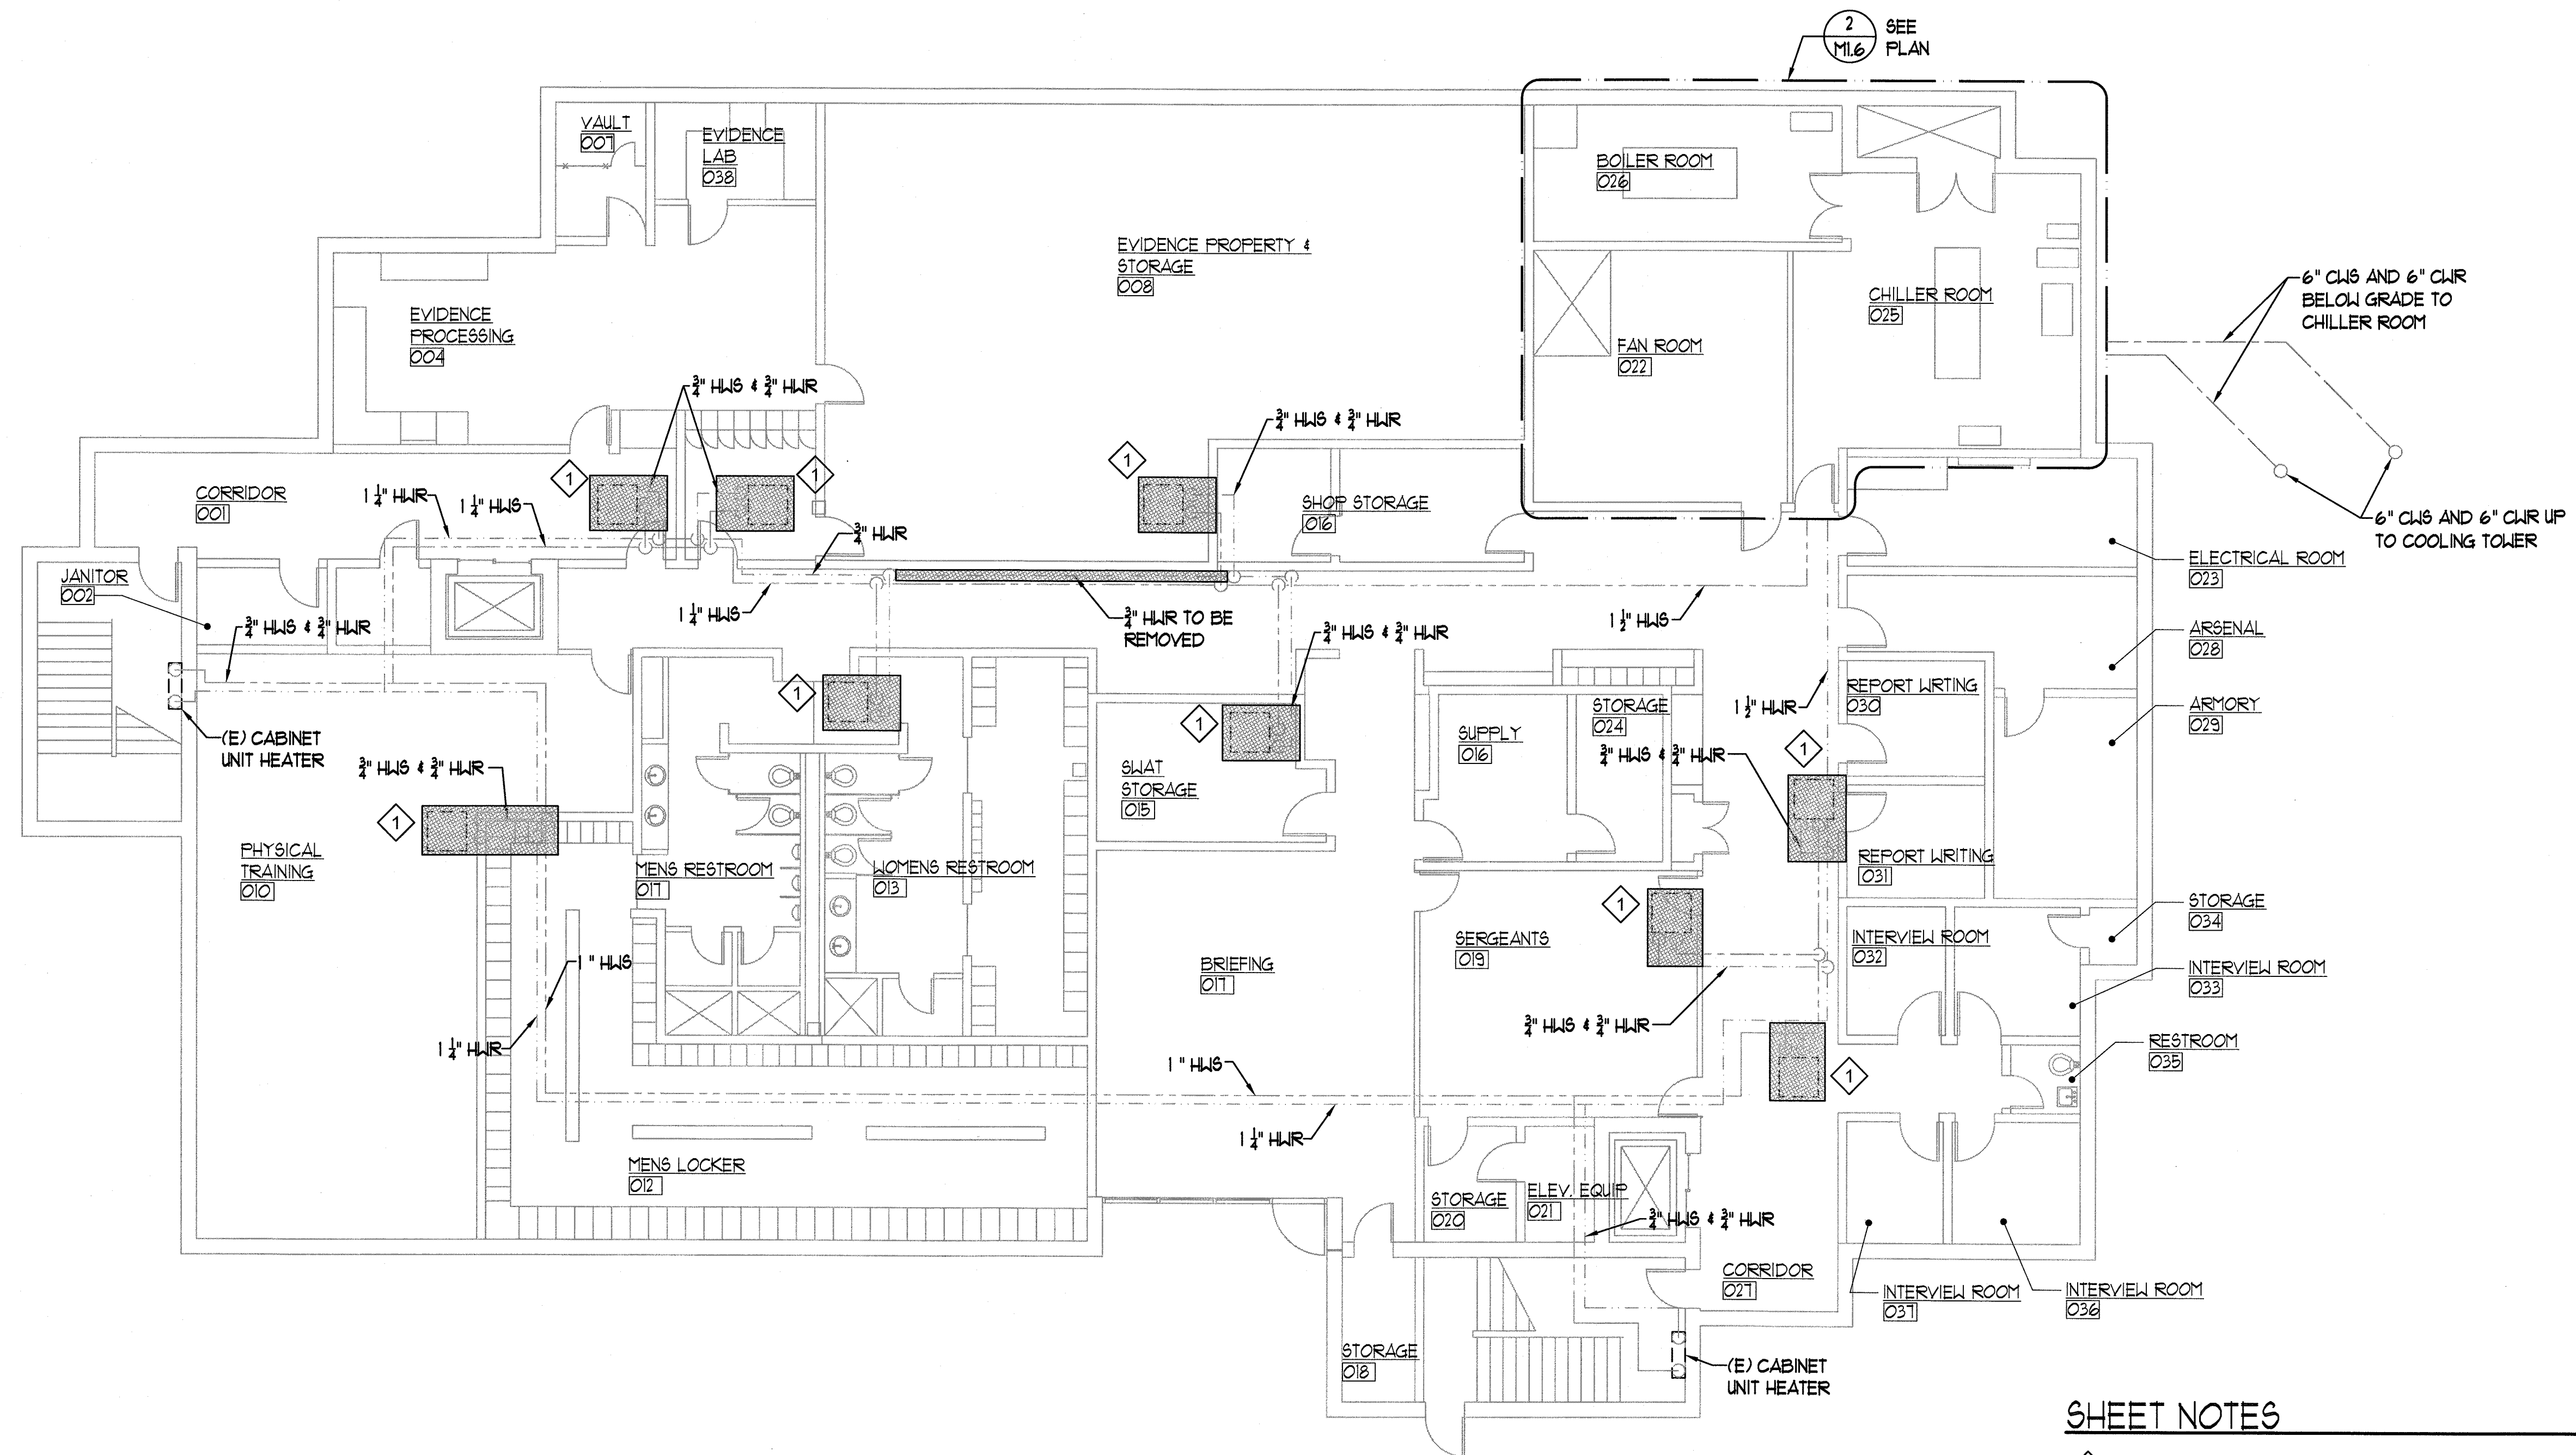

SHEET NOTES

1 FAN POWER TERMINAL UNIT AND ASSOCIATED 3-WAY CONTROL VALVE PIPING PACKAGE TO BE REMOVED. ALERTON CONTROLLER TO BE REMOVED AND SAVED FOR REINSTALLATION ON NEW EQUIPMENT. PREP PIPING FOR CONNECTION TO NEW EQUIPMENT.

1
M1.3
MECHANICAL PIPING DEMOLITION FLOOR PLAN - BASEMENT
SCALE: 1/8" = 1'-0"

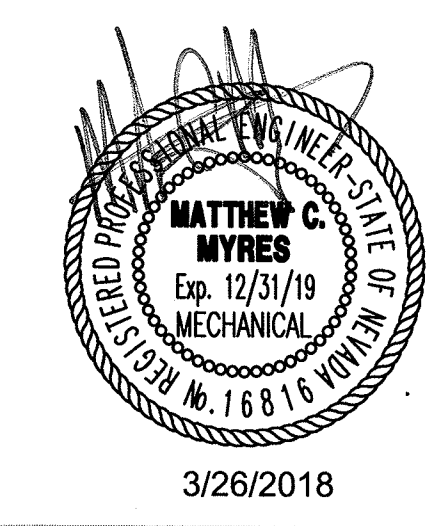

BID DOCUMENTS

MMI ENGINEERING
385 GENTRY WAY
RENO, NV. 89502
(775) 499-5784
WWW.MMIE-DESIGNER.COM
MMI PROJECT #2016-19



**SPARKS POLICE DEPARTMENT
HVAC UPGRADE PHASE 1
1701 EAST PRATER WAY
SPARKS, NEVADA 89434**

SHEET TITLE
MECHANICAL PIPING
DEMOLITION FLOOR PLAN
- BASEMENT

REVISIONS

NO.	DESCRIPTION


DATE: MARCH 26, 2018
SHEET NUMBER: M1.3
RECEIVED-CITY OF SPARKS
MAR 28 2018
COMMUNITY SERVICES
BUILDING DIVISION

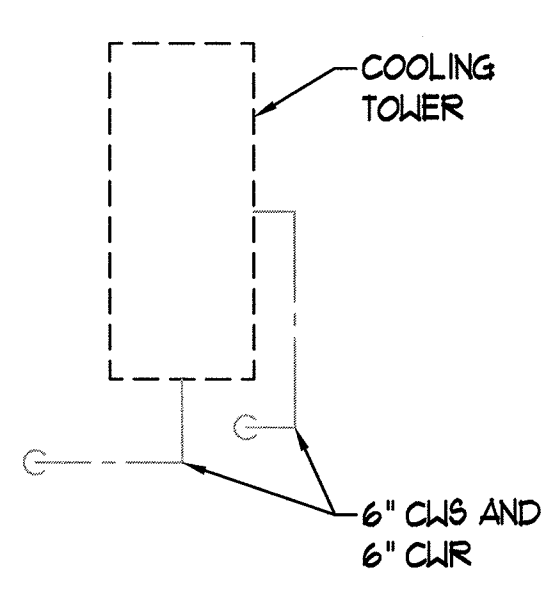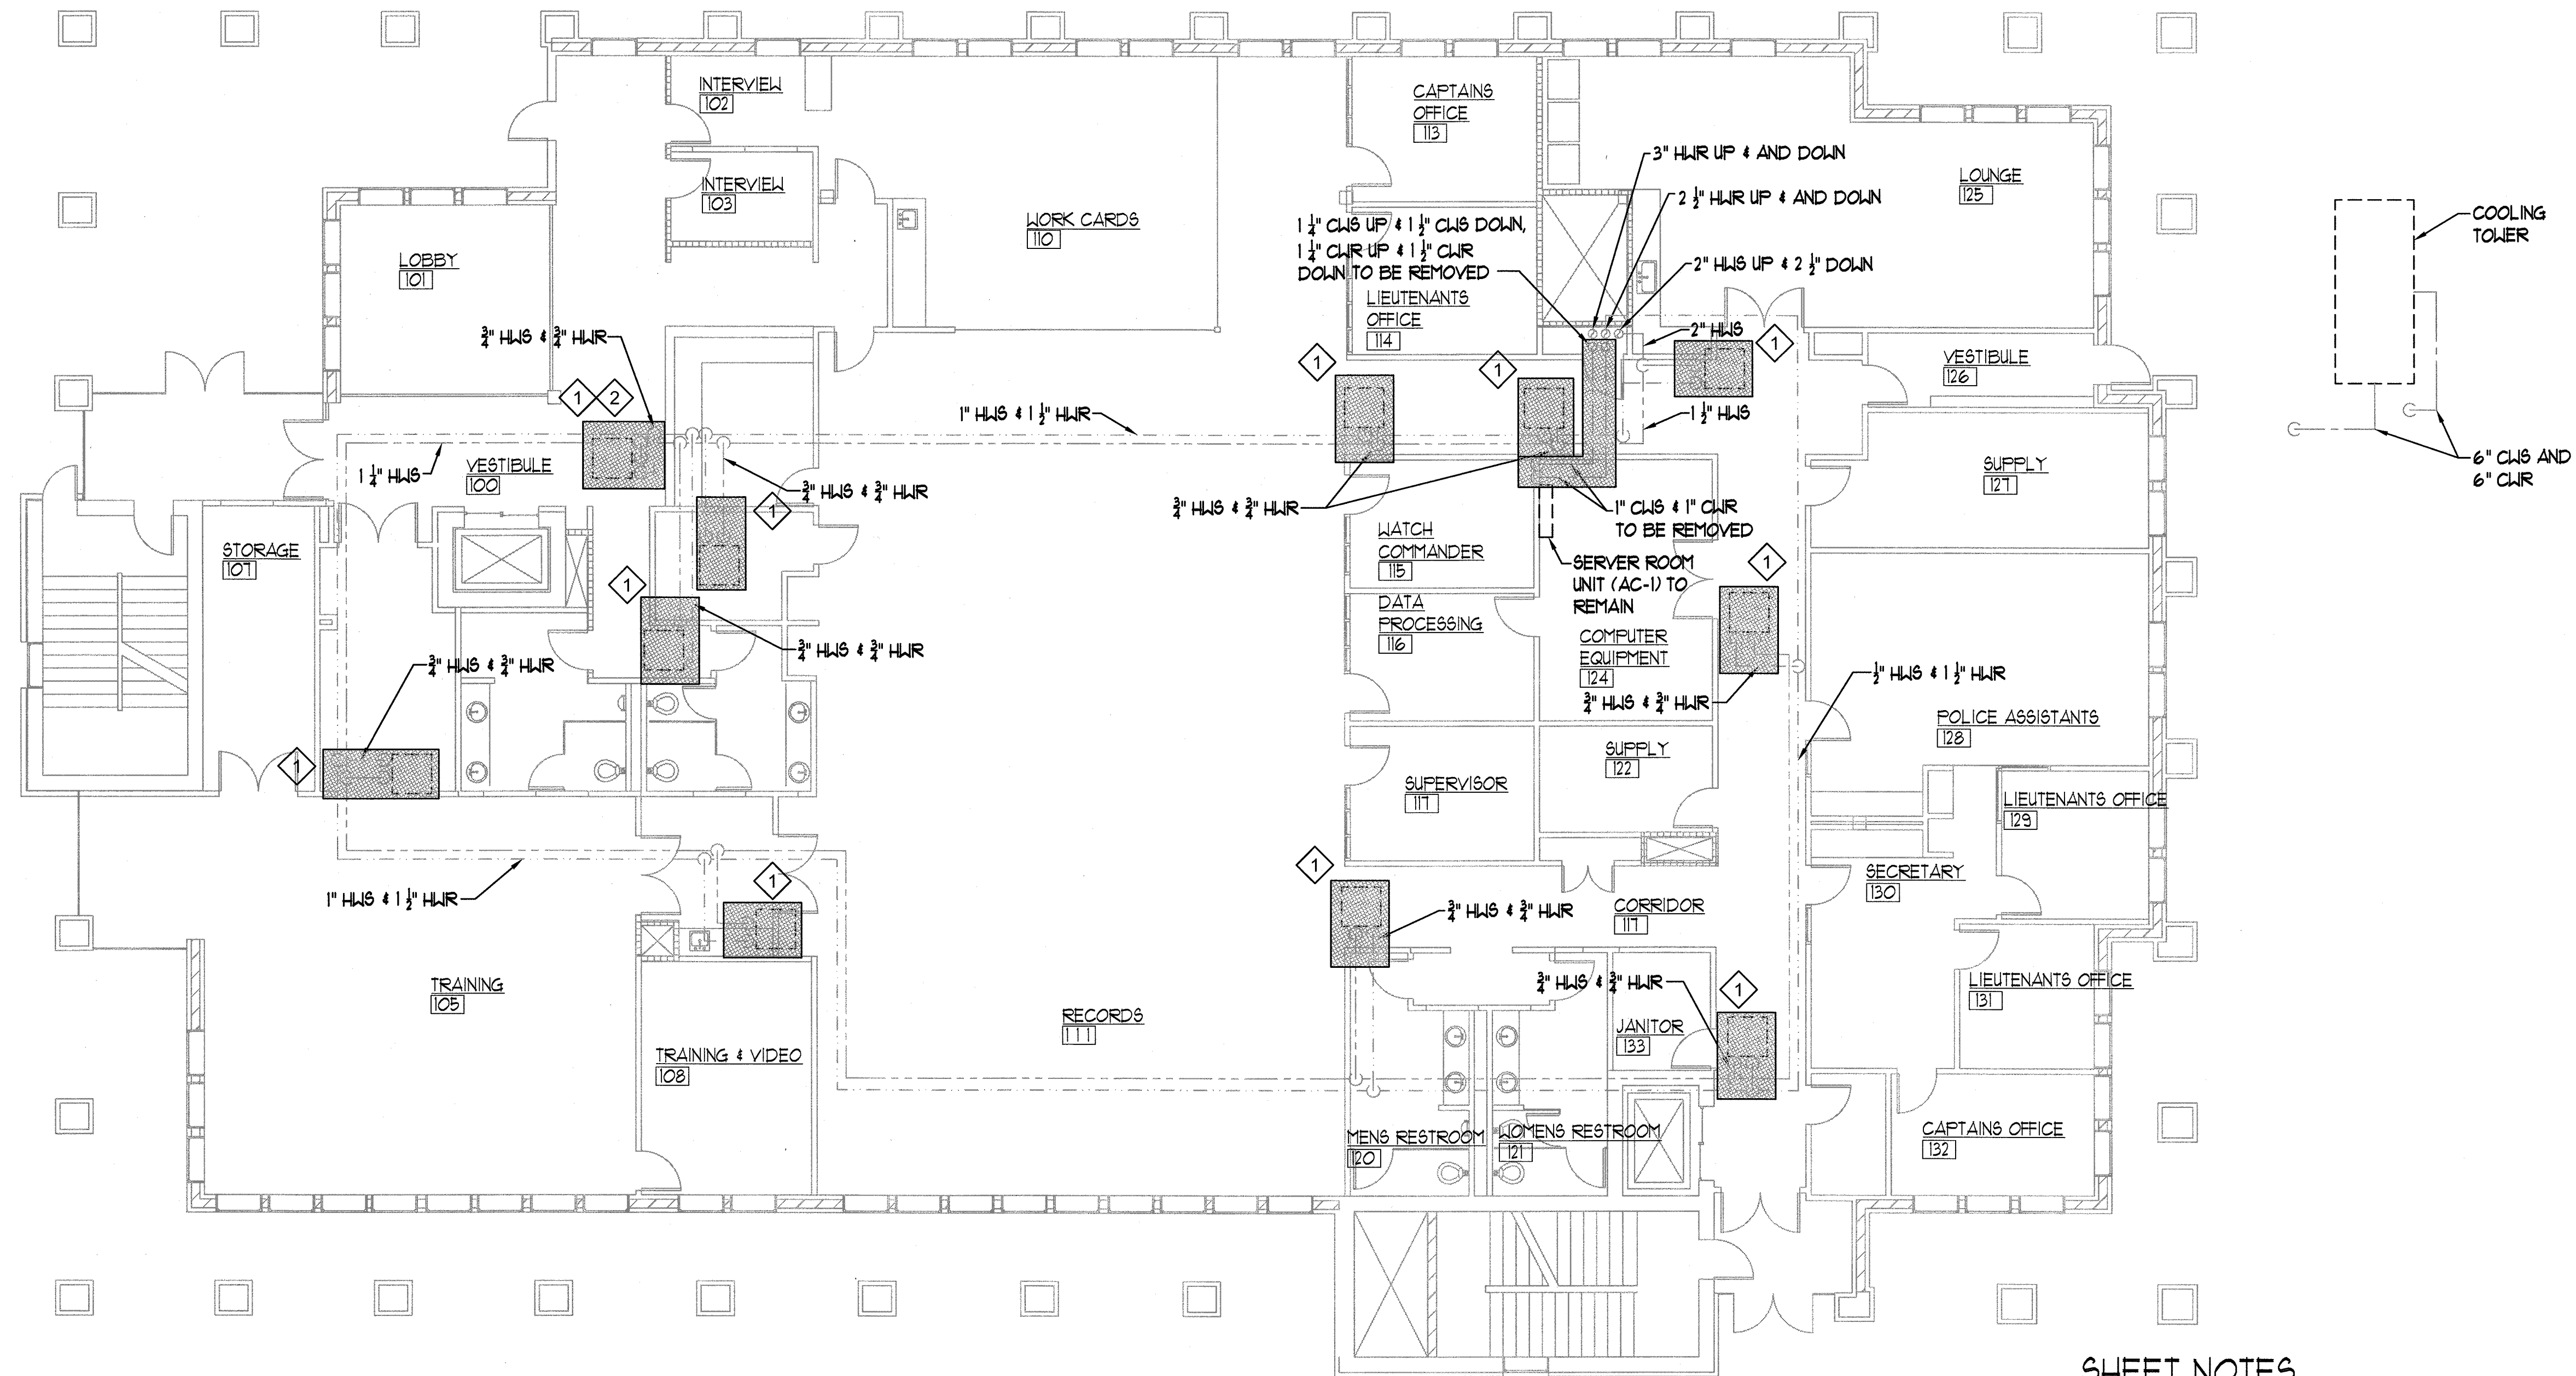

SHEET NOTES

- ① FAN POWER TERMINAL UNIT AND ASSOCIATED 3-WAY CONTROL VALVE PIPING PACKAGE TO BE REMOVED. ALERTON CONTROLLER TO BE REMOVED AND SAVED FOR REINSTALLATION ON NEW EQUIPMENT. PREP PIPING FOR CONNECTION TO NEW EQUIPMENT.
- ② UNABLE TO VERIFY EXACT LOCATION OF THIS FAN POWER TERMINAL UNIT. CONTRACTOR TO VERIFY LOCATION AND COORDINATION REMOVAL WITH THE ENGINEER.


① M1.4 MECHANICAL PIPING DEMOLITION FLOOR PLAN - GROUND FLOOR
SCALE: 1/8" = 1'-0"

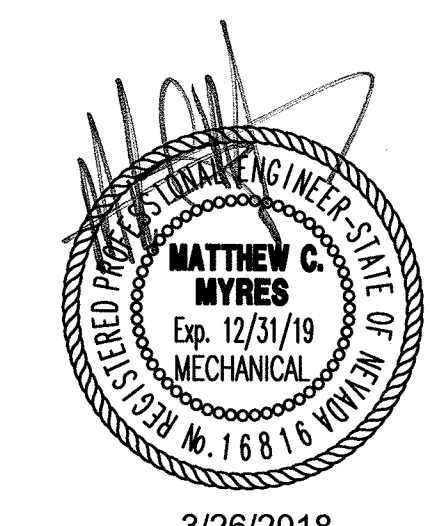

3/26/2018

BID DOCUMENTS

MMI ENGINEERING
385 GENTRY WAY
RENO, NV. 89502
(775) 499-5784
WWW.MMI-ENGINEER.COM
MMI PROJECT #2016-19

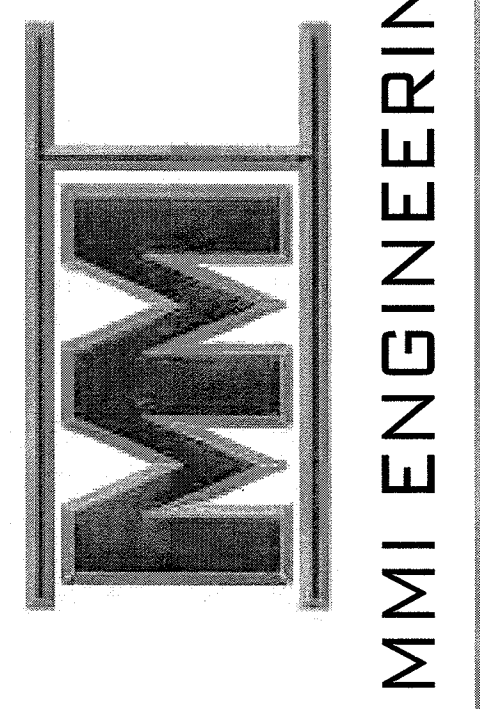


**SPARKS POLICE DEPARTMENT
HVAC UPGRADE PHASE 1
1701 EAST PRATER WAY
SPARKS, NEVADA 89434**

SHEET TITLE
MECHANICAL PIPING
DEMOLITION FLOOR PLAN
- GROUND FLOOR

REVISIONS


DATE: MARCH 26, 2018
RECEIVED BY: CITY OF SPARKS
SHEET NUMBER: M1.4
COMMUNITY SERVICES
BUILDING DIVISION

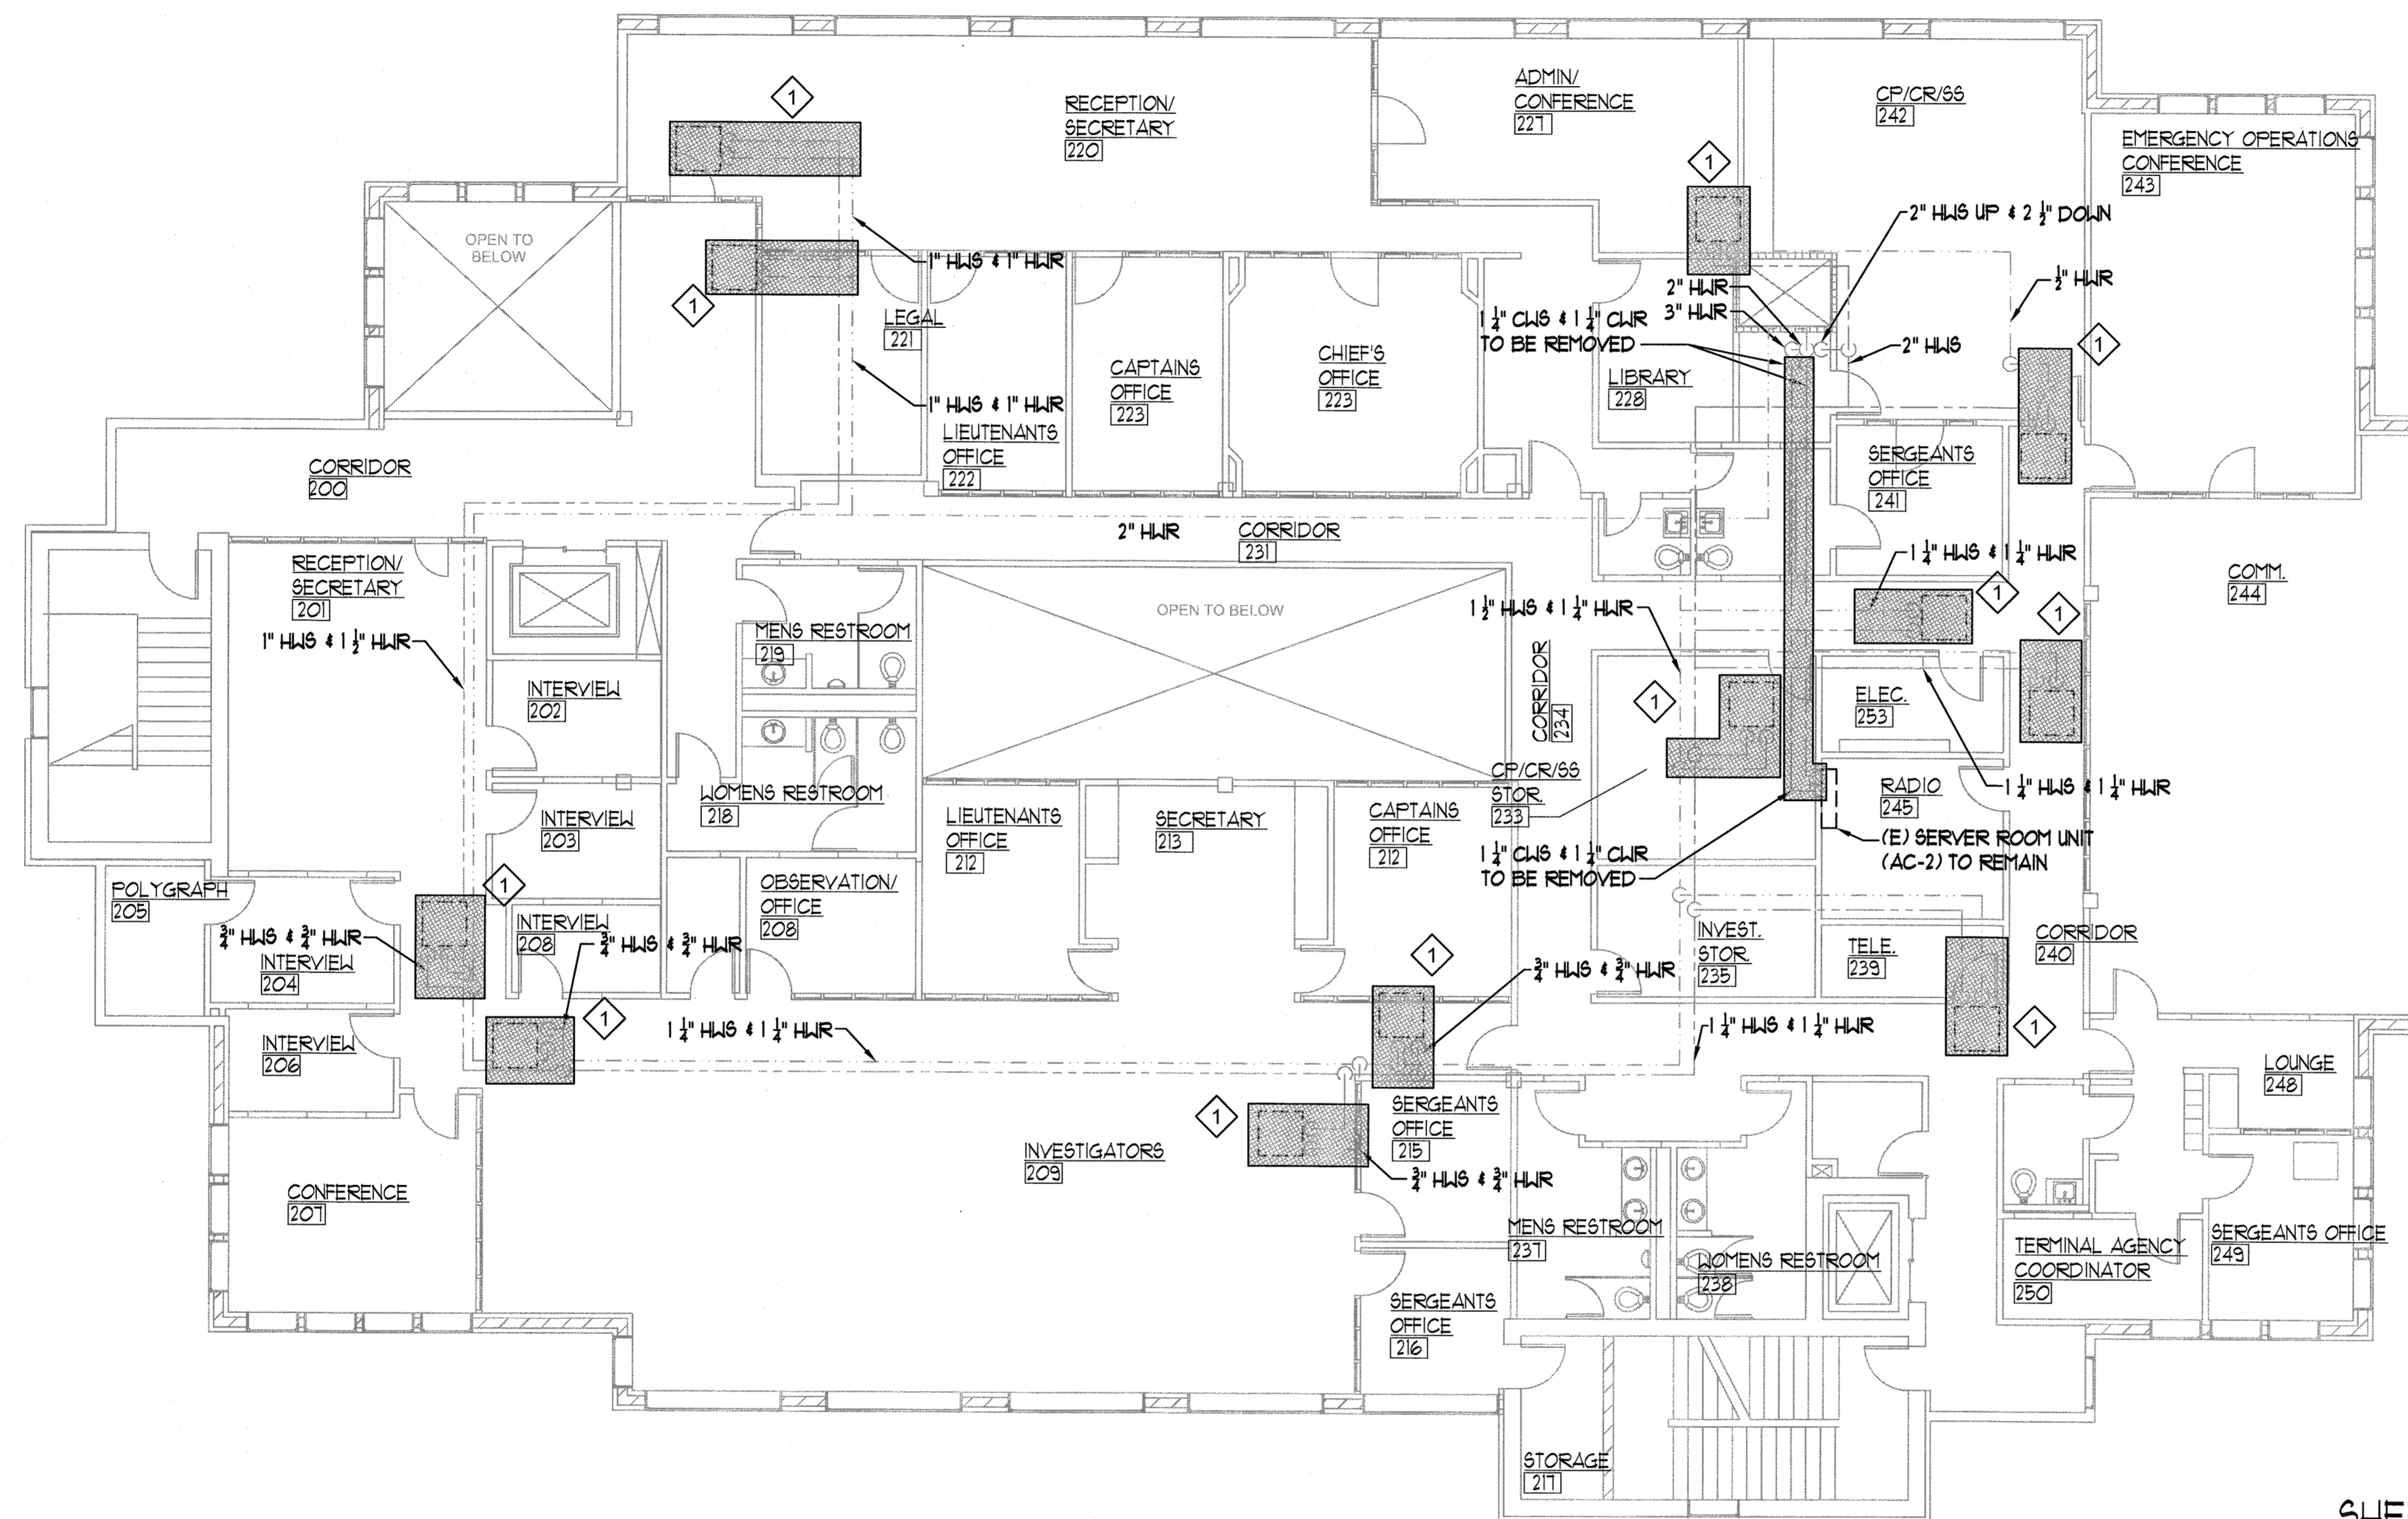

SHEET NOTES

- 1 FAN POWER TERMINAL UNIT AND ASSOCIATED 3-WAY CONTROL VALVE PIPING PACKAGE TO BE REMOVED. ALERTON CONTROLLER TO BE REMOVED AND SAVED FOR REINSTALLATION ON NEW EQUIPMENT. PREP PIPING FOR CONNECTION TO NEW EQUIPMENT.


1
M1.5
MECHANICAL PIPING DEMOLITION FLOOR PLAN - SECOND FLOOR
SCALE: 1/8" = 1'-0"

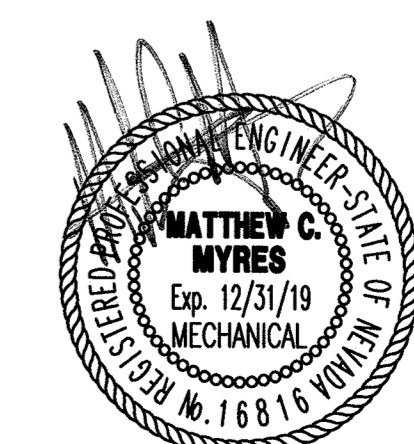

3/26/2018

BID DOCUMENTS

MMI ENGINEERING
385 GENTRY WAY,
RENO, NV. 89502
(775) 499-5784
WWW.MMI-DESIGNER.COM
MMI PROJECT #2016-19

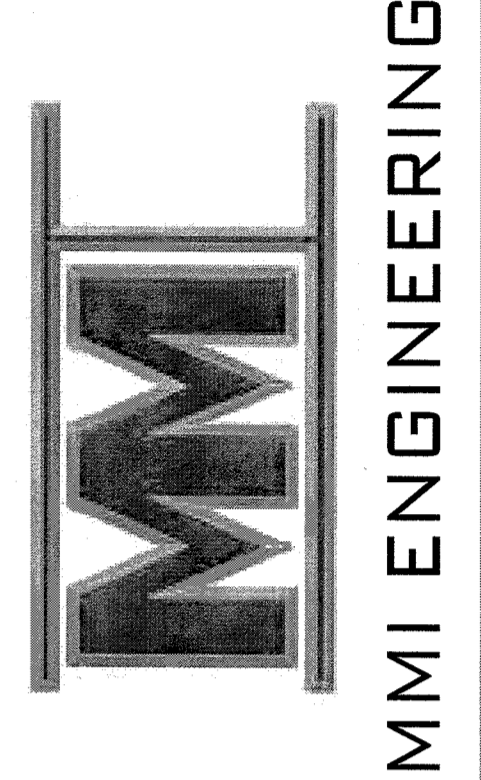


**SPARKS POLICE DEPARTMENT
HVAC UPGRADE PHASE 1
1701 EAST PRATER WAY
SPARKS, NEVADA 89434**


SHEET TITLE
MECHANICAL PIPING
DEMOLITION FLOOR PLAN
- SECOND FLOOR

REVISIONS

DATE : MARCH 26, 2018
SHEET NUMBER : M1.5
RECEIVED-CITY OF SPARKS
MAR 28 2018
COMMUNITY SERVICES
FIRE DIVISION

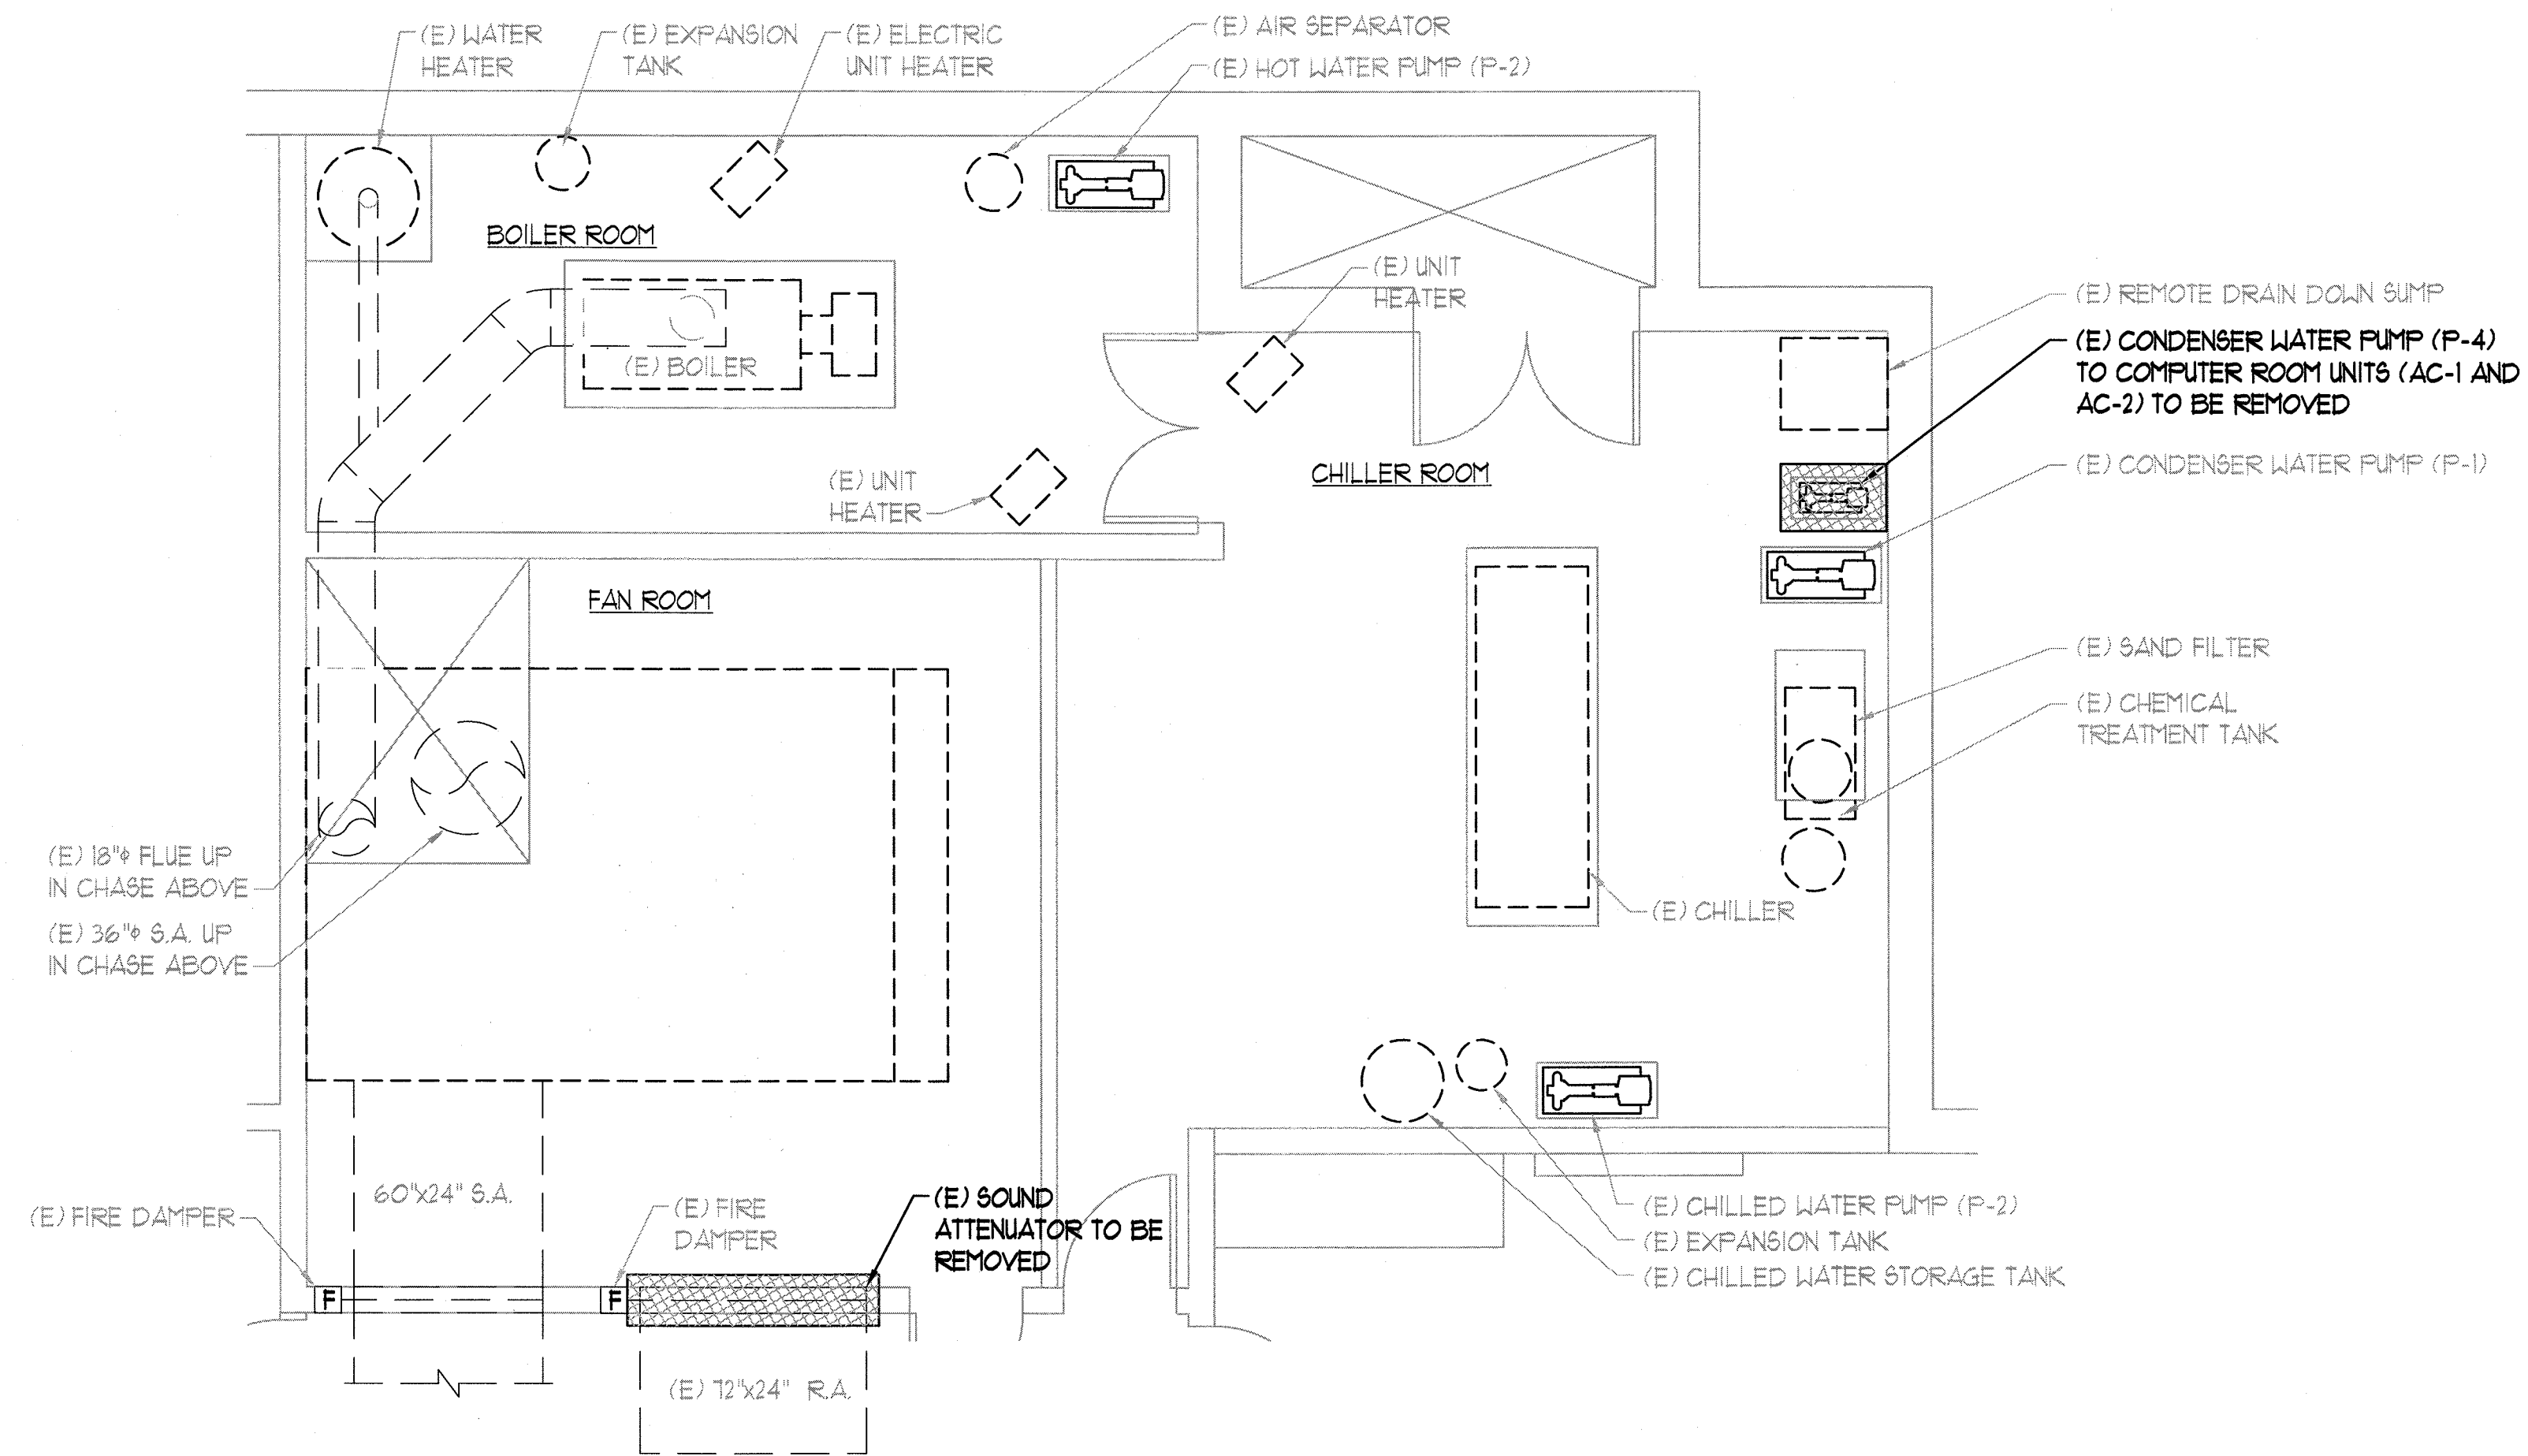


1 MECHANICAL DEMOLITION ENLARGED PLAN
 M1.6 SCALE: 1/4" = 1'-0"

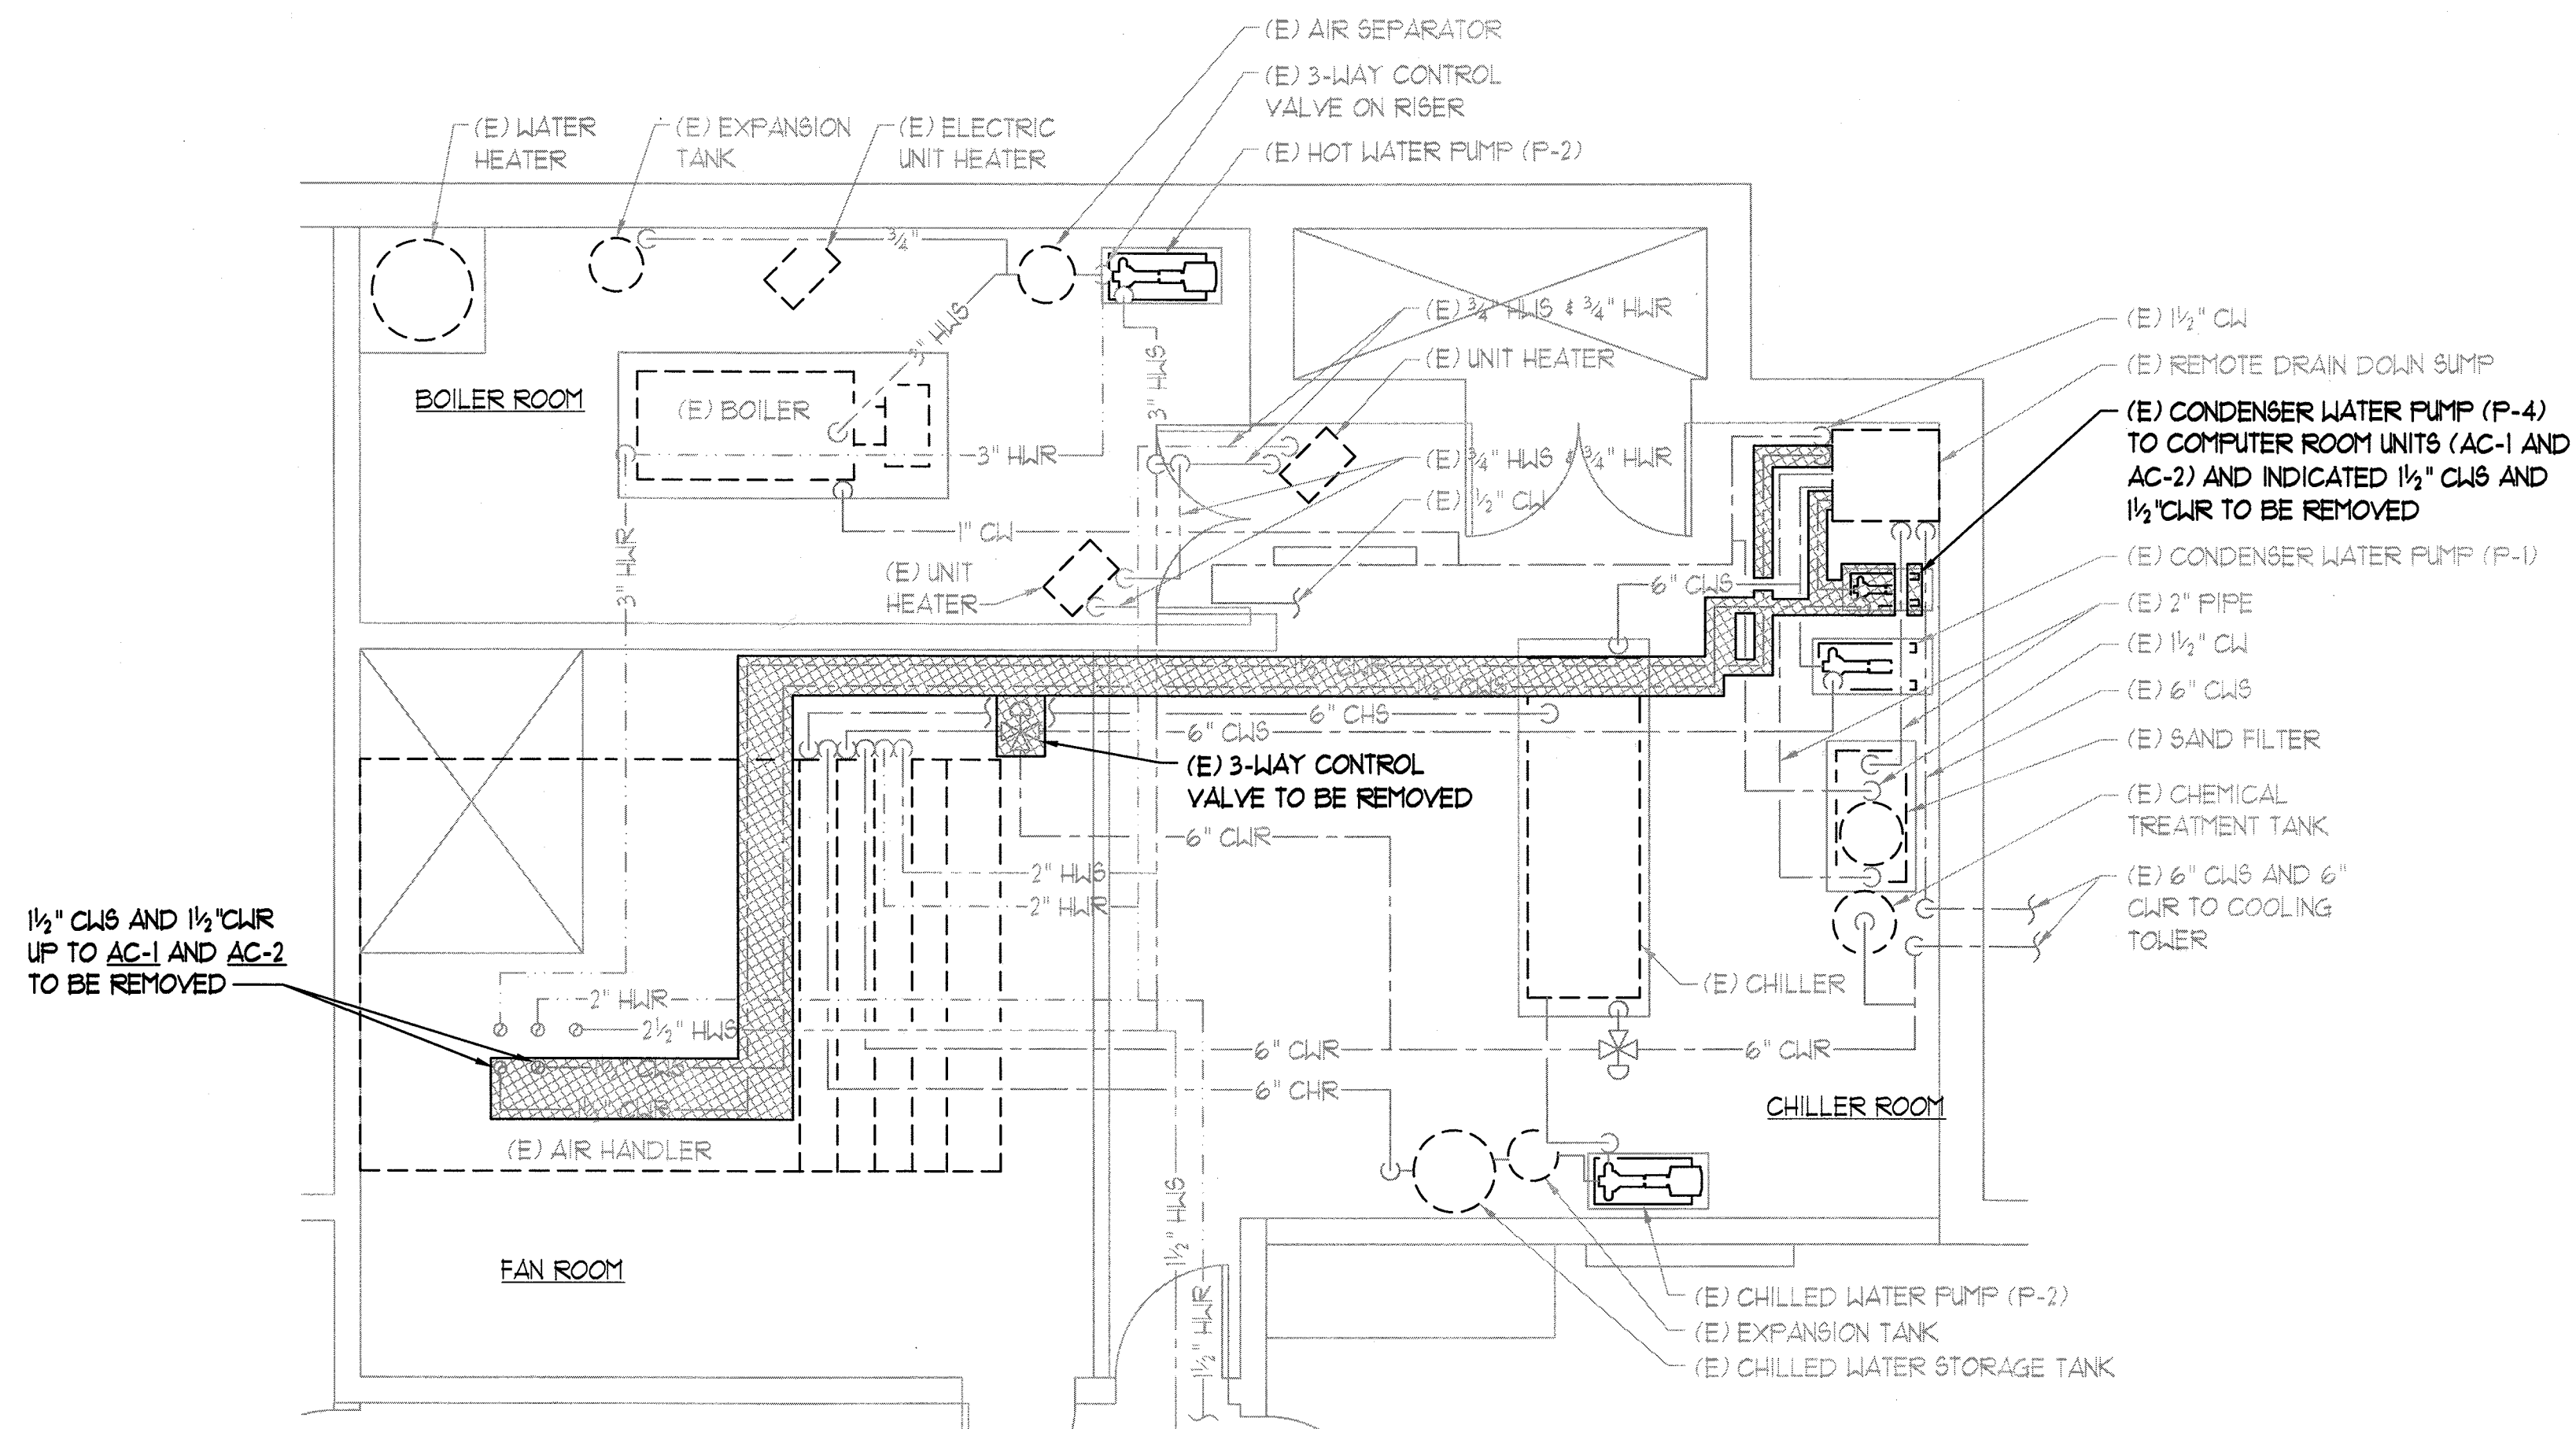

2 MECHANICAL PIPING DEMOLITION ENLARGED PLAN
 M1.6 SCALE: 1/4" = 1'-0"

MMI ENGINEERING
 385 GENTRY WAY
 RENO, NV. 89502
 (775) 499-5784
 WWW.MMIE-DESIGNER.COM
 MMI PROJECT #2016-19

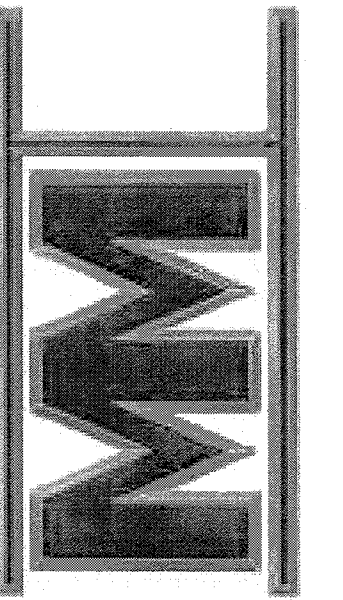

MMI ENGINEERING

SPARKS POLICE DEPARTMENT
 HVAC UPGRADE PHASE 1
 1701 EAST PRATER WAY
 SPARKS, NEVADA 89434

SHEET TITLE

MECHANICAL DEMOLITION
 ENLARGED PLANS

REVISIONS




3/26/2018

BID DOCUMENTS

DATE: MARCH 26, 2018 RECEIVED-CITY OF SPARKS
 SHEET NUMBER: M1.6 MAR 28 2018
 COMMUNITY SERVICES
 BUILDING DIVISION

M1.6

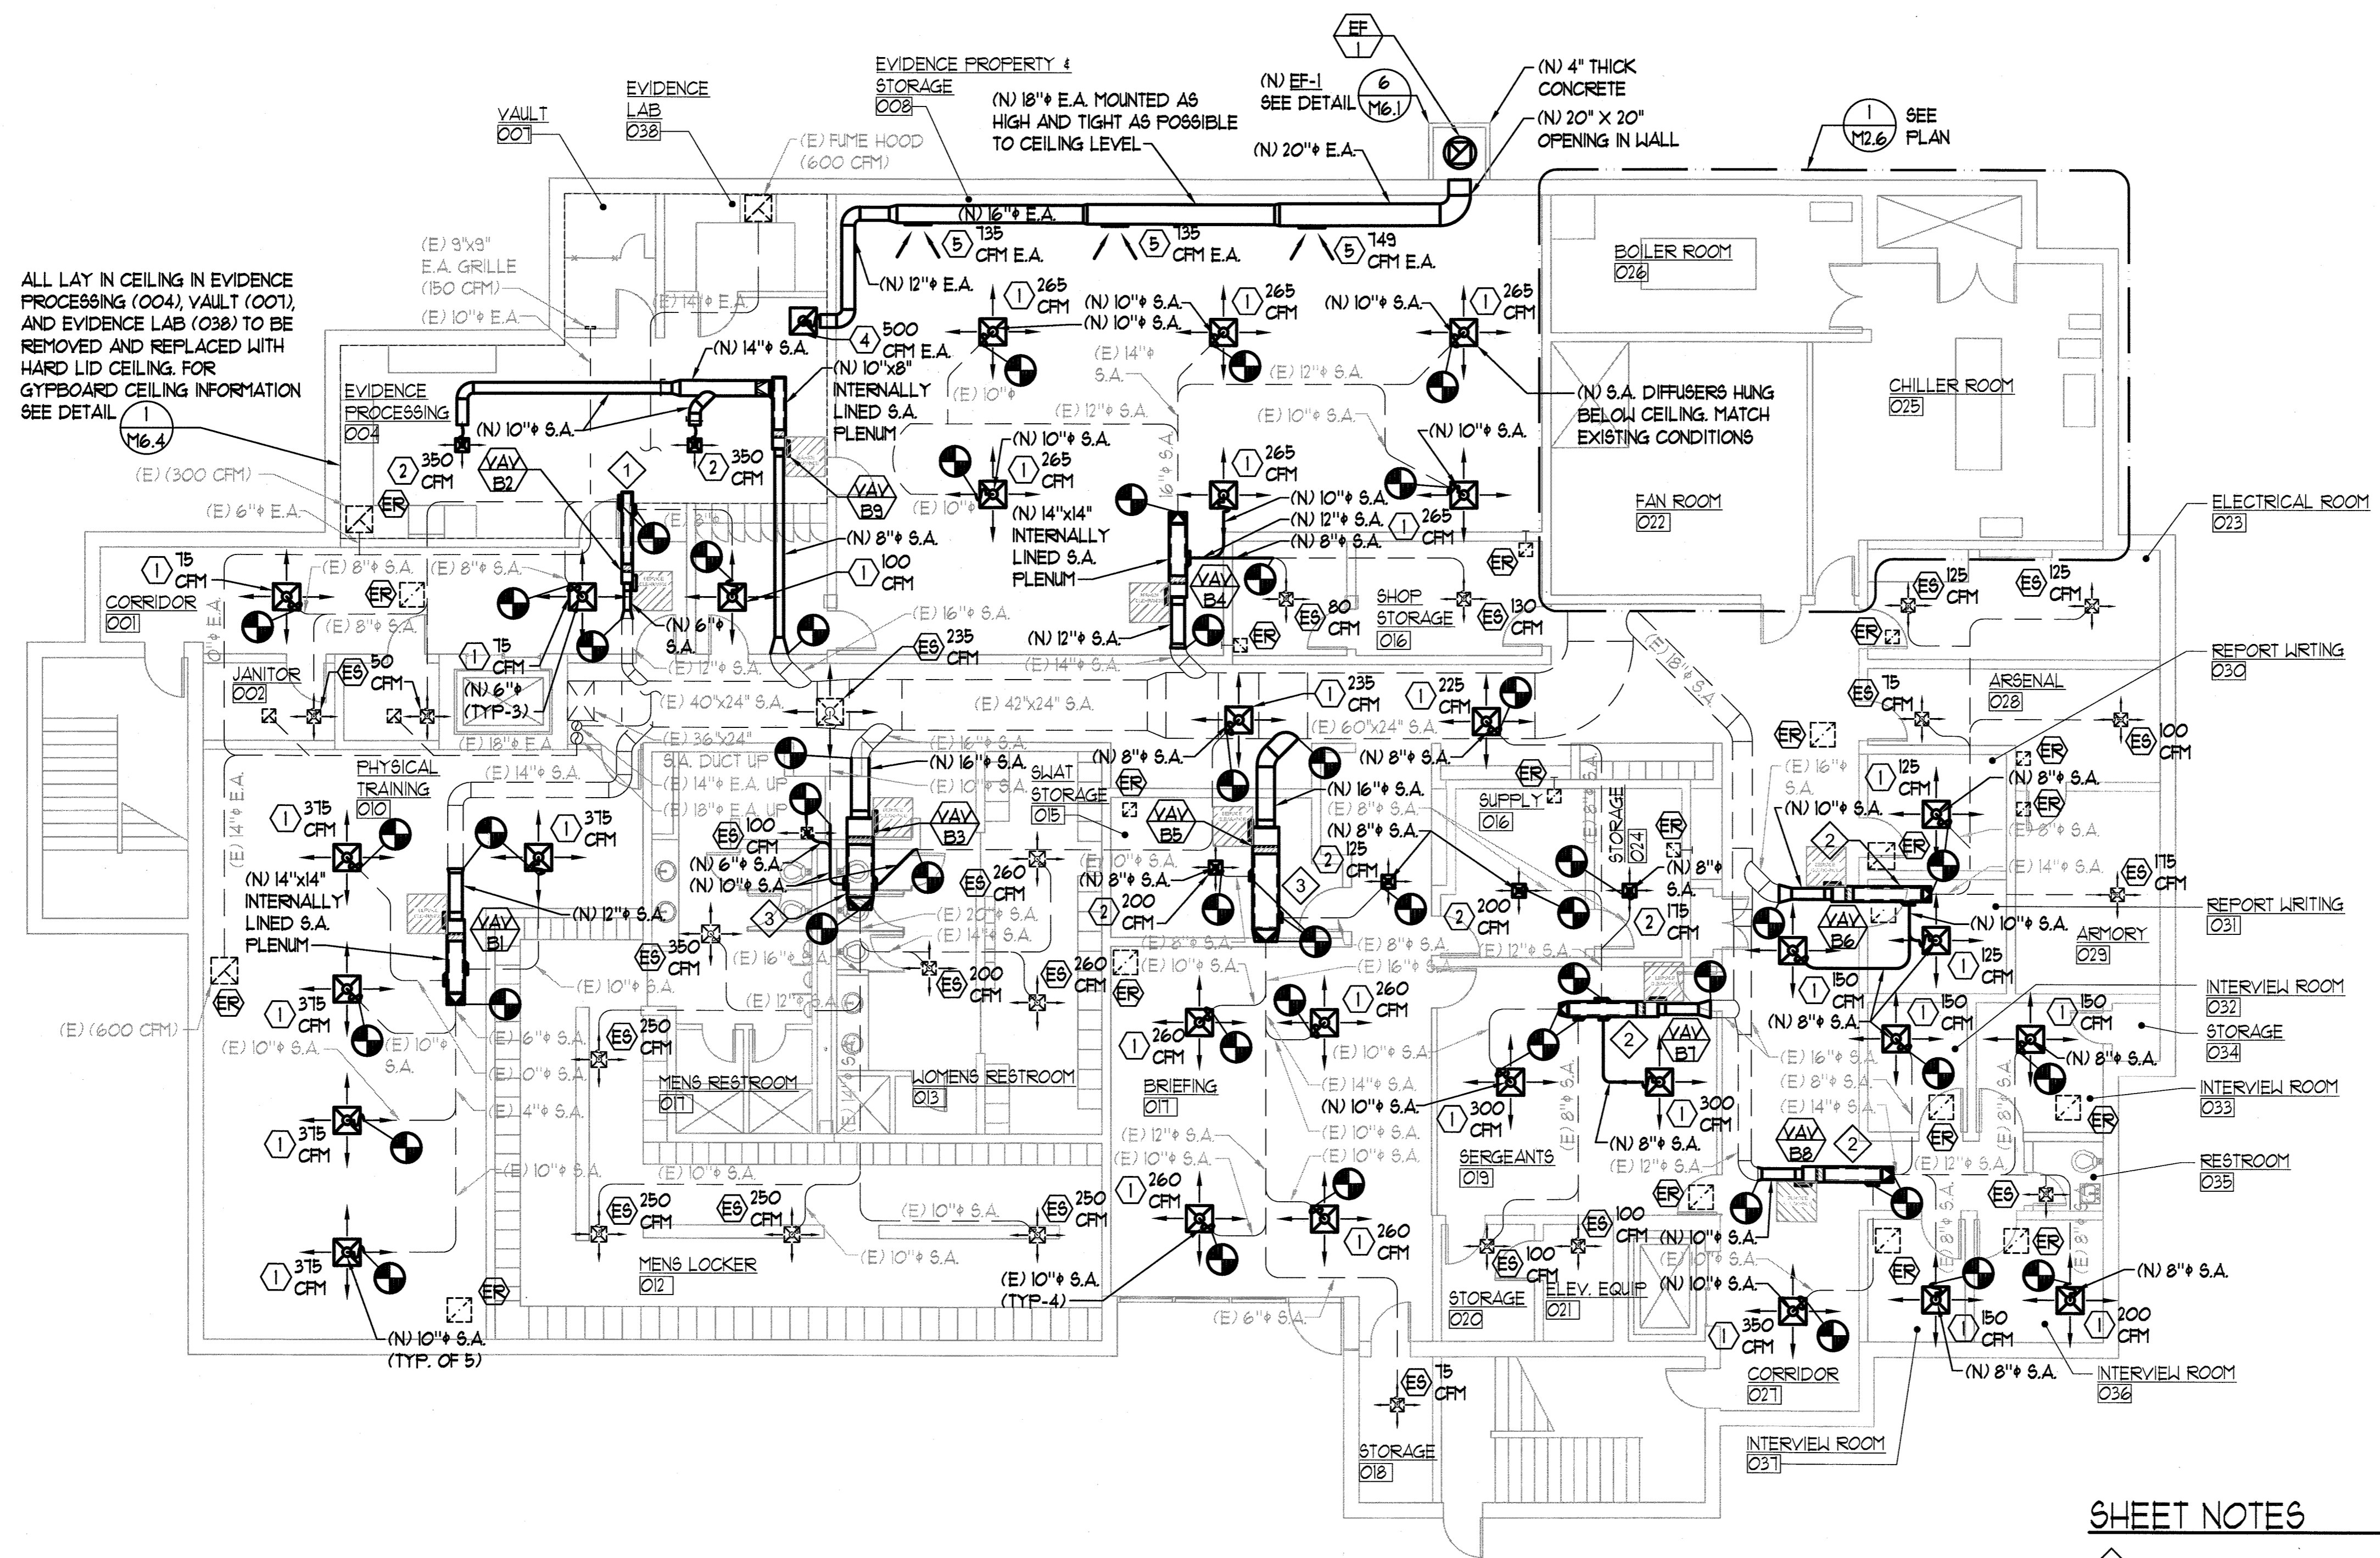


ALL LAY IN CEILING IN EVIDENCE PROCESSING (004), VAULT (001), AND EVIDENCE LAB (038) TO BE REMOVED AND REPLACED WITH HARD LID CEILING. FOR GYPSBOARD CEILING INFORMATION SEE DETAIL.

1 MECHANICAL FLOOR PLAN - BASEMENT
 M2.0 SCALE: 1/8" = 1'-0"

- SHEET NOTES**
- 1 (N) 8"x8" INTERNALLY LINED S.A. PLENUM
 - 2 (N) 12"x12" INTERNALLY LINED S.A. PLENUM
 - 3 (N) 22"x16" INTERNALLY LINED S.A. PLENUM

GENERAL NOTE:
 1. CONTRACTOR IS TO BALANCE ALL NEW AND EXISTING SUPPLY DIFFUSERS TO CFMs INDICATED ON ALL PLANS

MMI ENGINEERING
 385 GENTRY WAY
 RENO, NV. 89502
 (775) 499-5784
 WWW.MMIENGINEERING.COM
 MMI PROJECT #2016-19

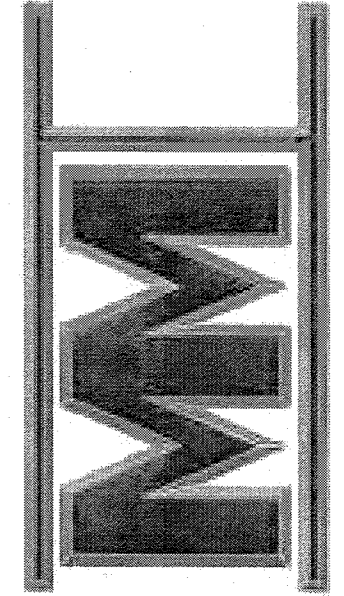


MMI ENGINEERING

SPARKS POLICE DEPARTMENT
 HVAC UPGRADE PHASE 1
 1701 EAST PRATER WAY
 SPARKS, NEVADA 89434

SHEET TITLE
 MECHANICAL FLOOR PLAN - BASEMENT

REVISIONS


RECEIVED-CITY OF SPARKS
 DATE: MARCH 26, 2018 MAR 28 2018
 SHEET NUMBER: COMMUNITY SERVICES BUILDING DIVISION

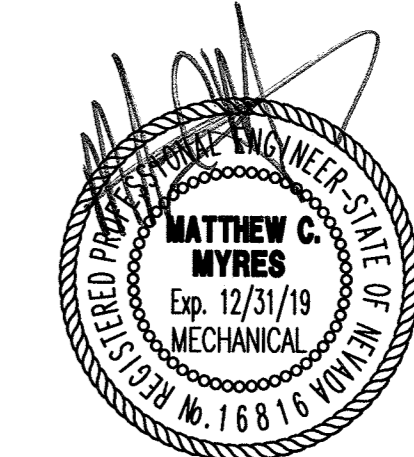

BID DOCUMENTS

M2.0

3/26/2018

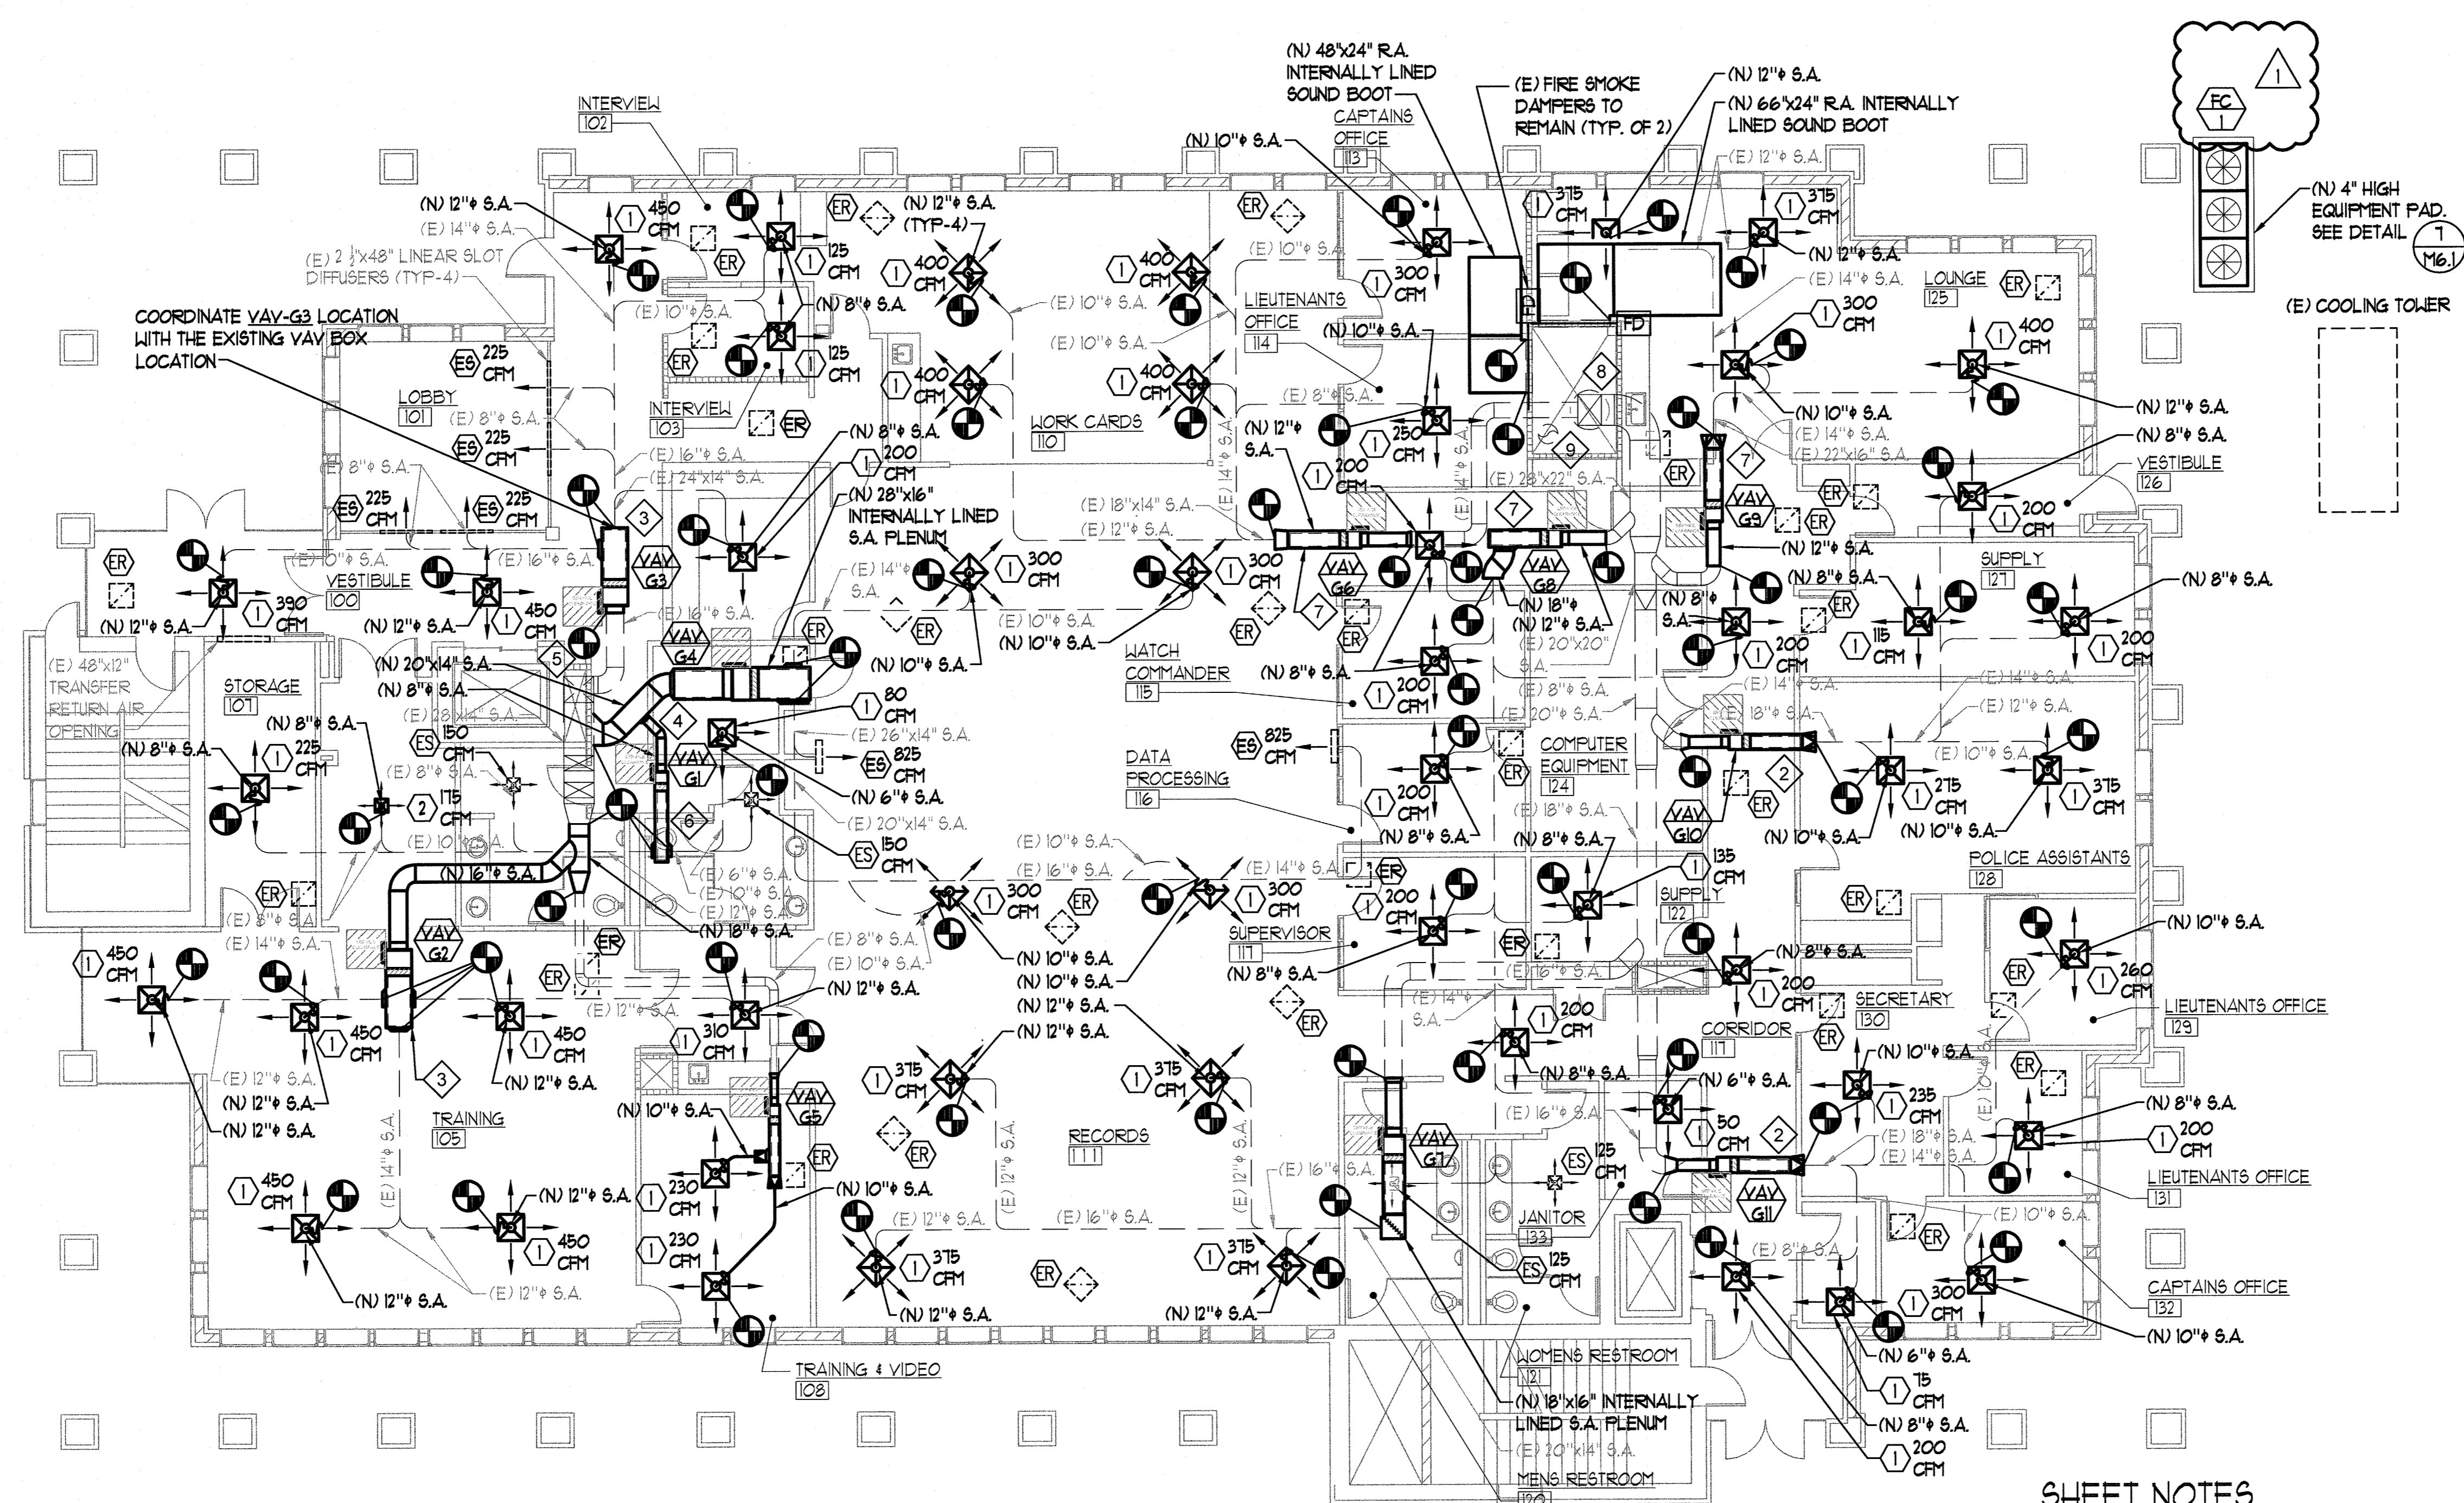

1
M2.1 MECHANICAL FLOOR PLAN - GROUND FLOOR
SCALE: 1/8" = 1'-0"

SHEET NOTES

- 1 (N) 8"x8" INTERNALLY LINED S.A. PLENUM
- 2 (N) 12"x12" INTERNALLY LINED S.A. PLENUM
- 3 (N) 22"x16" INTERNALLY LINED S.A. PLENUM
- 4 (N) 28"x14" INTERNALLY LINED S.A. PLENUM
- 5 (E) 28"x24" S.A. DUCT UP IN CHASE
- 6 (N) 10"x8" INTERNALLY LINED S.A. PLENUM
- 7 (N) 14"x14" INTERNALLY LINED S.A. PLENUM
- 8 (E) 36" S.A. DUCT DOWN TO BASEMENT AND (E) 20"x28" S.A. DUCT UP TO SECOND FLOOR
- 9 (E) 18" FLUE UP TO SECOND FLOOR

CITY OF SPARKS
COMMUNITY SERVICES-BLDG. DIV.
AUG 20 2018
REVISED

BID DOCUMENTS
MATTHEW C. MYRES
Exp. 12/31/19
MECHANICAL
No. 16816
3/26/2018


SHEET TITLE
MECHANICAL FLOOR PLAN - GROUND FLOOR

REVISIONS
PLAN REVIEW COMMENTS (04/09/18)

DATE : MARCH 26, 2018
SHEET NUMBER :


M2.1

MMI ENGINEERING
385 GENTRY WAY
RENO, NV. 89502
(775) 499-5784
WWW.MMI-DESIGNER.COM
MMI PROJECT #2016-19

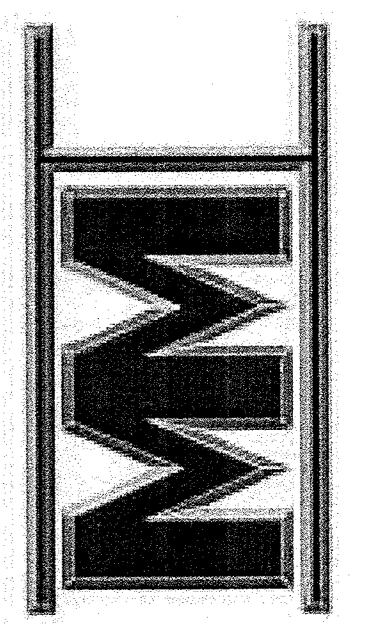

MMI ENGINEERING


SPARKS POLICE DEPARTMENT
HVAC UPGRADE PHASE 1
1701 EAST PRATER WAY
SPARKS, NEVADA 89434

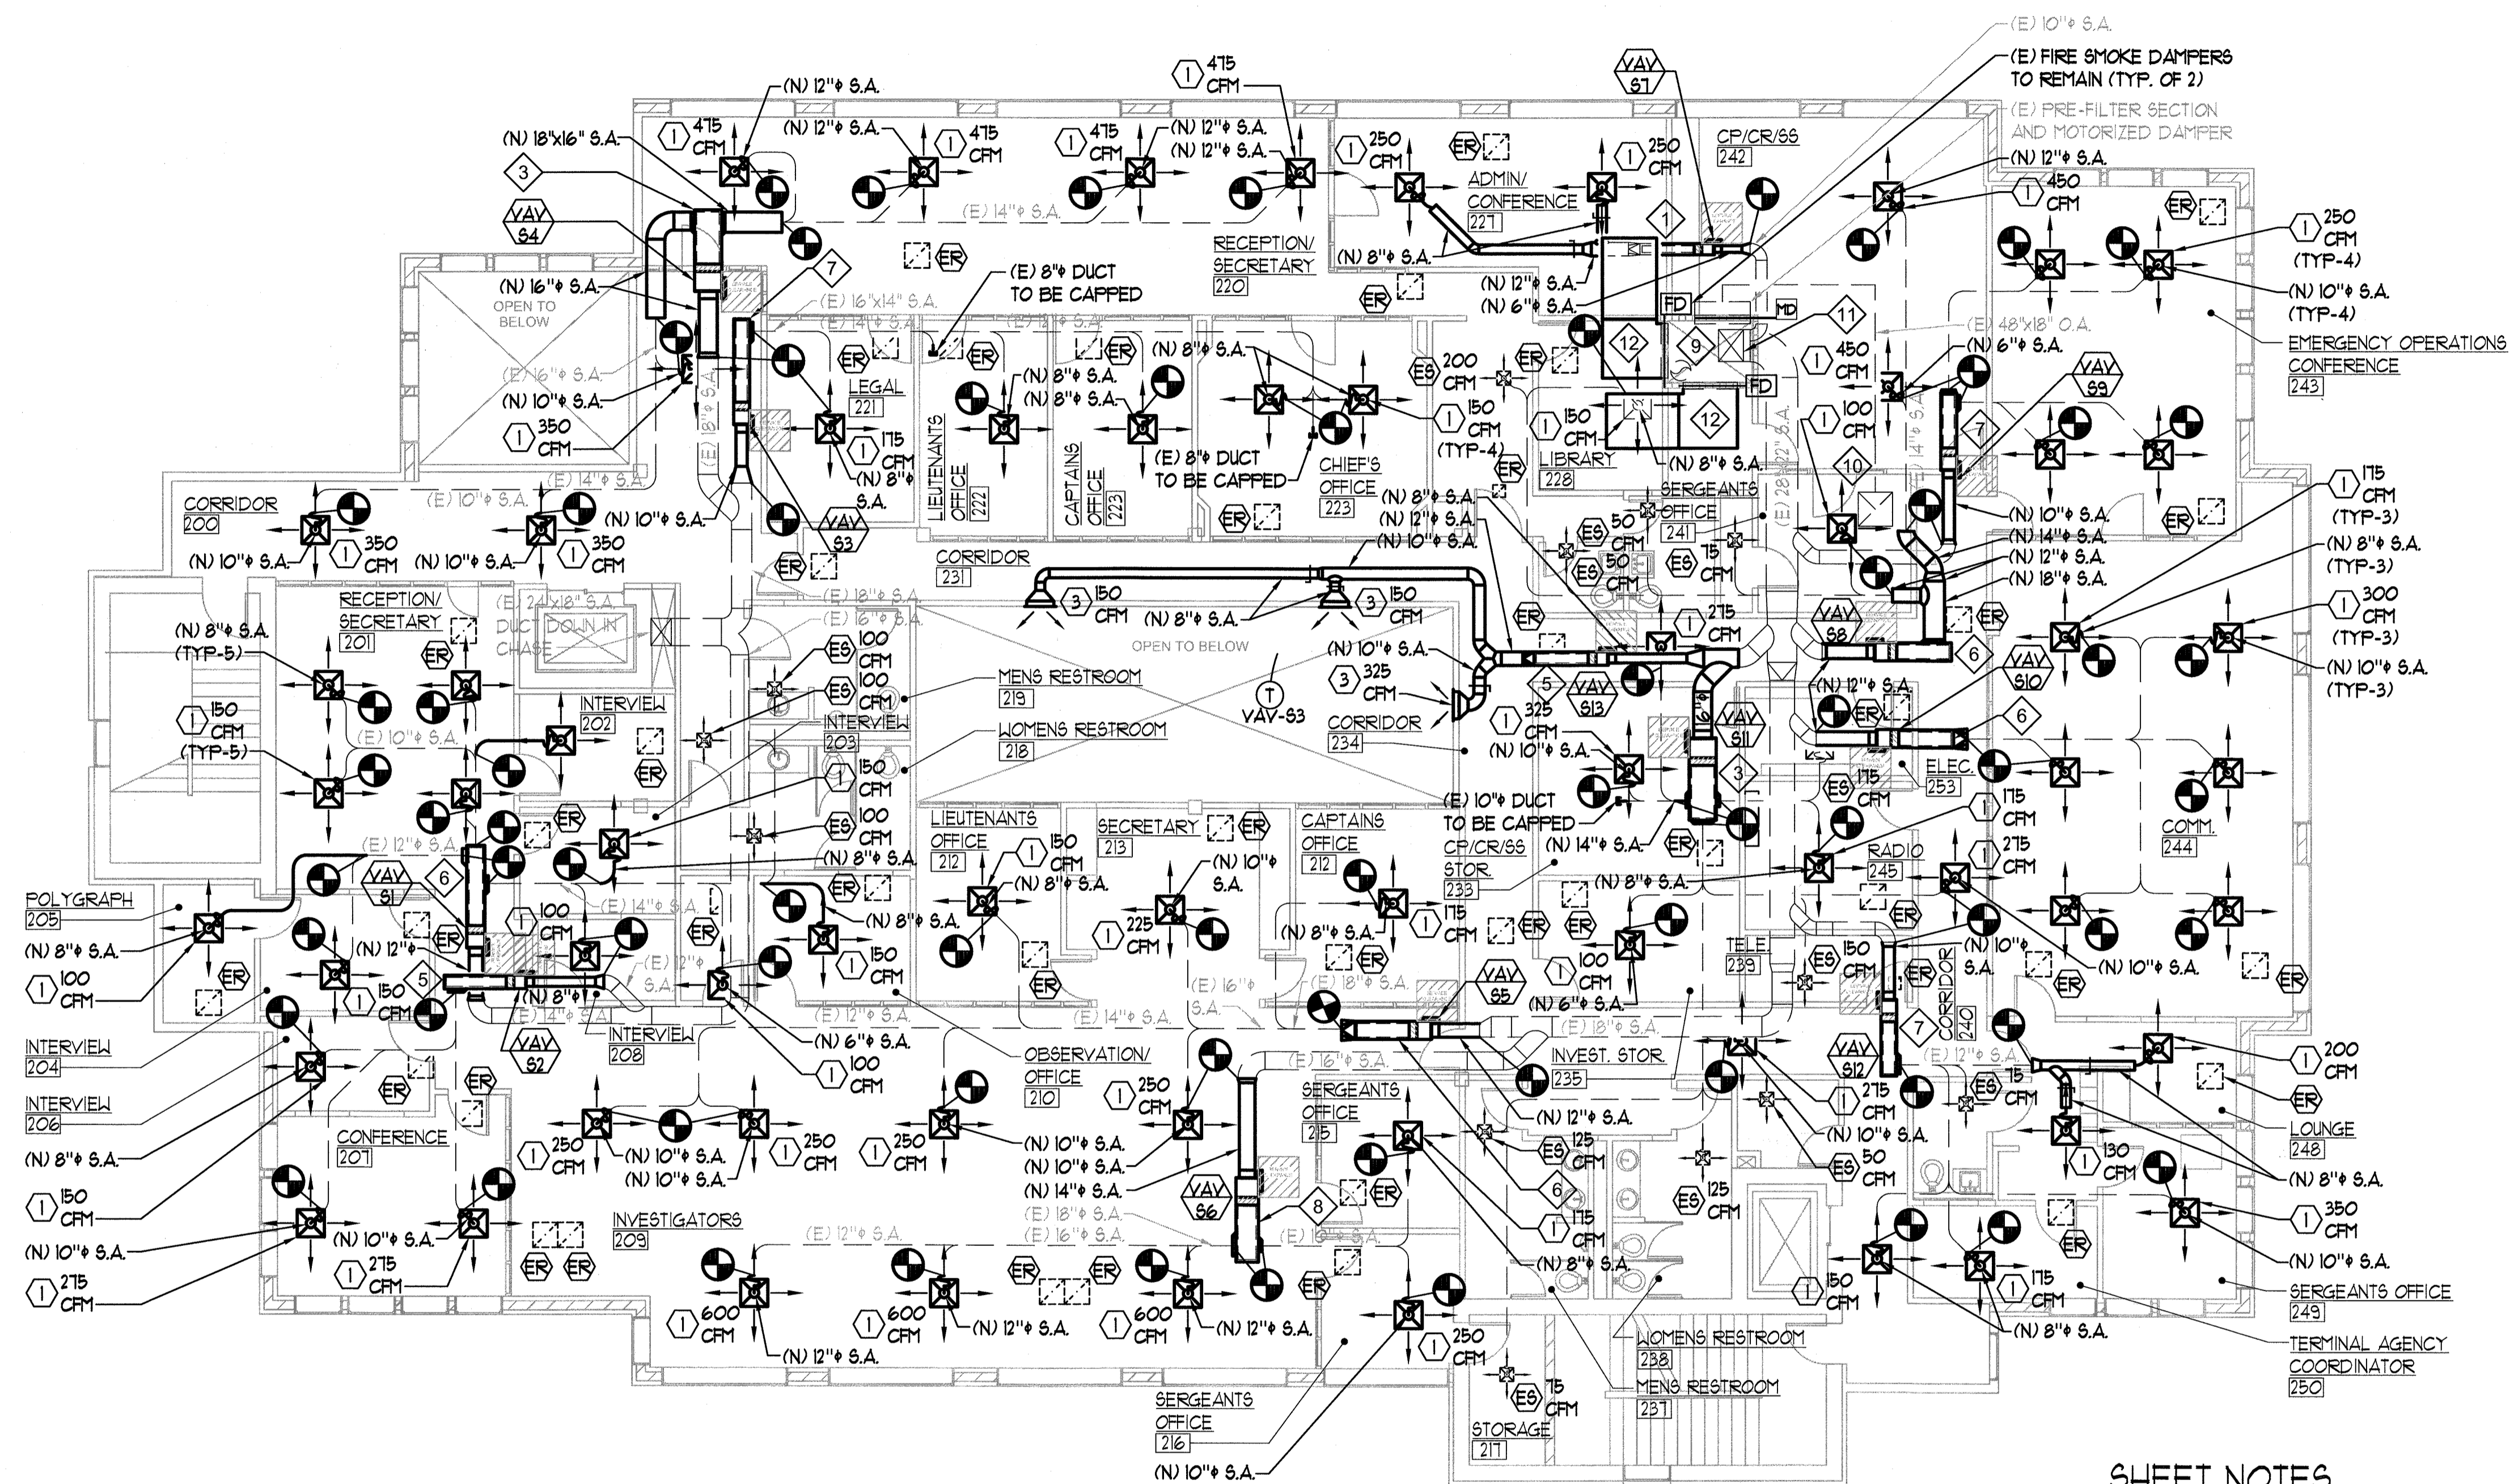

1 MECHANICAL FLOOR PLAN - SECOND FLOOR
 M2.2 SCALE: 1/8" = 1'-0"

SHEET NOTES


- 1 (N) 8"x8" INTERNALLY LINED S.A. PLENUM
- 2 (N) 12"x12" INTERNALLY LINED S.A. PLENUM
- 3 (N) 22"x16" INTERNALLY LINED S.A. PLENUM
- 4 (N) 28"x14" INTERNALLY LINED S.A. PLENUM
- 5 (N) 10"x8" INTERNALLY LINED S.A. PLENUM
- 6 (N) 14"x14" INTERNALLY LINED S.A. PLENUM
- 7 (N) 12"x12" INTERNALLY LINED S.A. PLENUM
- 8 (N) 18"x16" INTERNALLY LINED S.A. PLENUM
- 9 (E) 28"x22" S.A. DUCT DOWN IN CHASE
- 10 (E) 30"x30" O.A. UP TO OUTSIDE AIR INTAKE
- 11 (E) 18" FLUE UP TO SECOND FLOOR
- 12 (N) 48"x24" R.A. INTERNALLY LINED SOUND BOOT

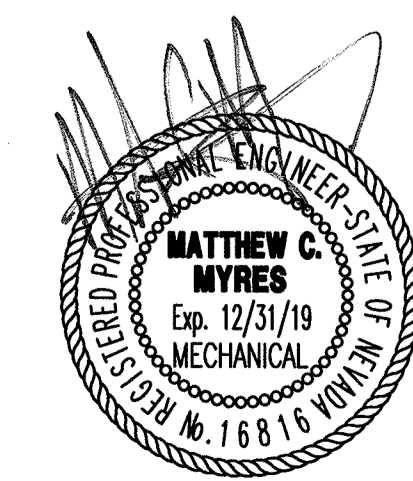

3/26/2018

BID DOCUMENTS

MMI ENGINEERING
 385 GENTRY WAY
 RENO, NV. 89502
 (775) 499-5784
 WWW.MMIENGINEERING.COM
 MMI PROJECT #2016-19

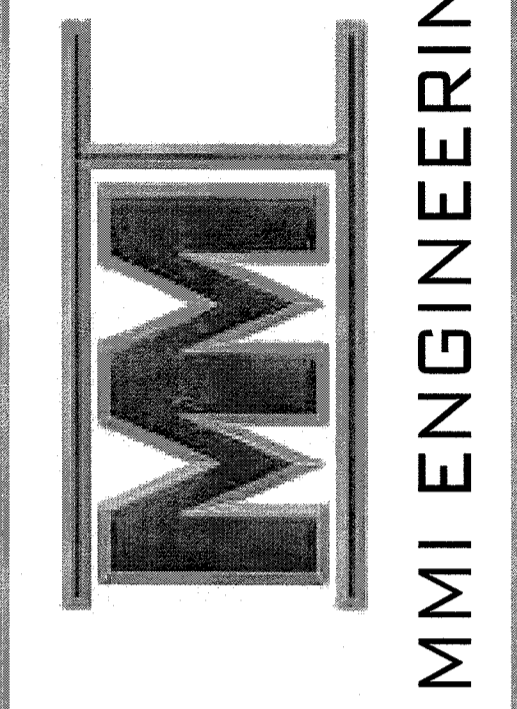


**SPARKS POLICE DEPARTMENT
 HVAC UPGRADE PHASE 1
 1701 EAST PRATER WAY
 SPARKS, NEVADA 89434**

SHEET TITLE
 MECHANICAL FLOOR PLAN
 - SECOND FLOOR

REVISIONS


DATE: MARCH 26, 2018
 SHEET NUMBER: M2.2
 RECEIVED-CITY OF SPARKS
 MAR 28 2018
 COMMUNITY SERVICES
 BUILDING DIVISION

M2.2

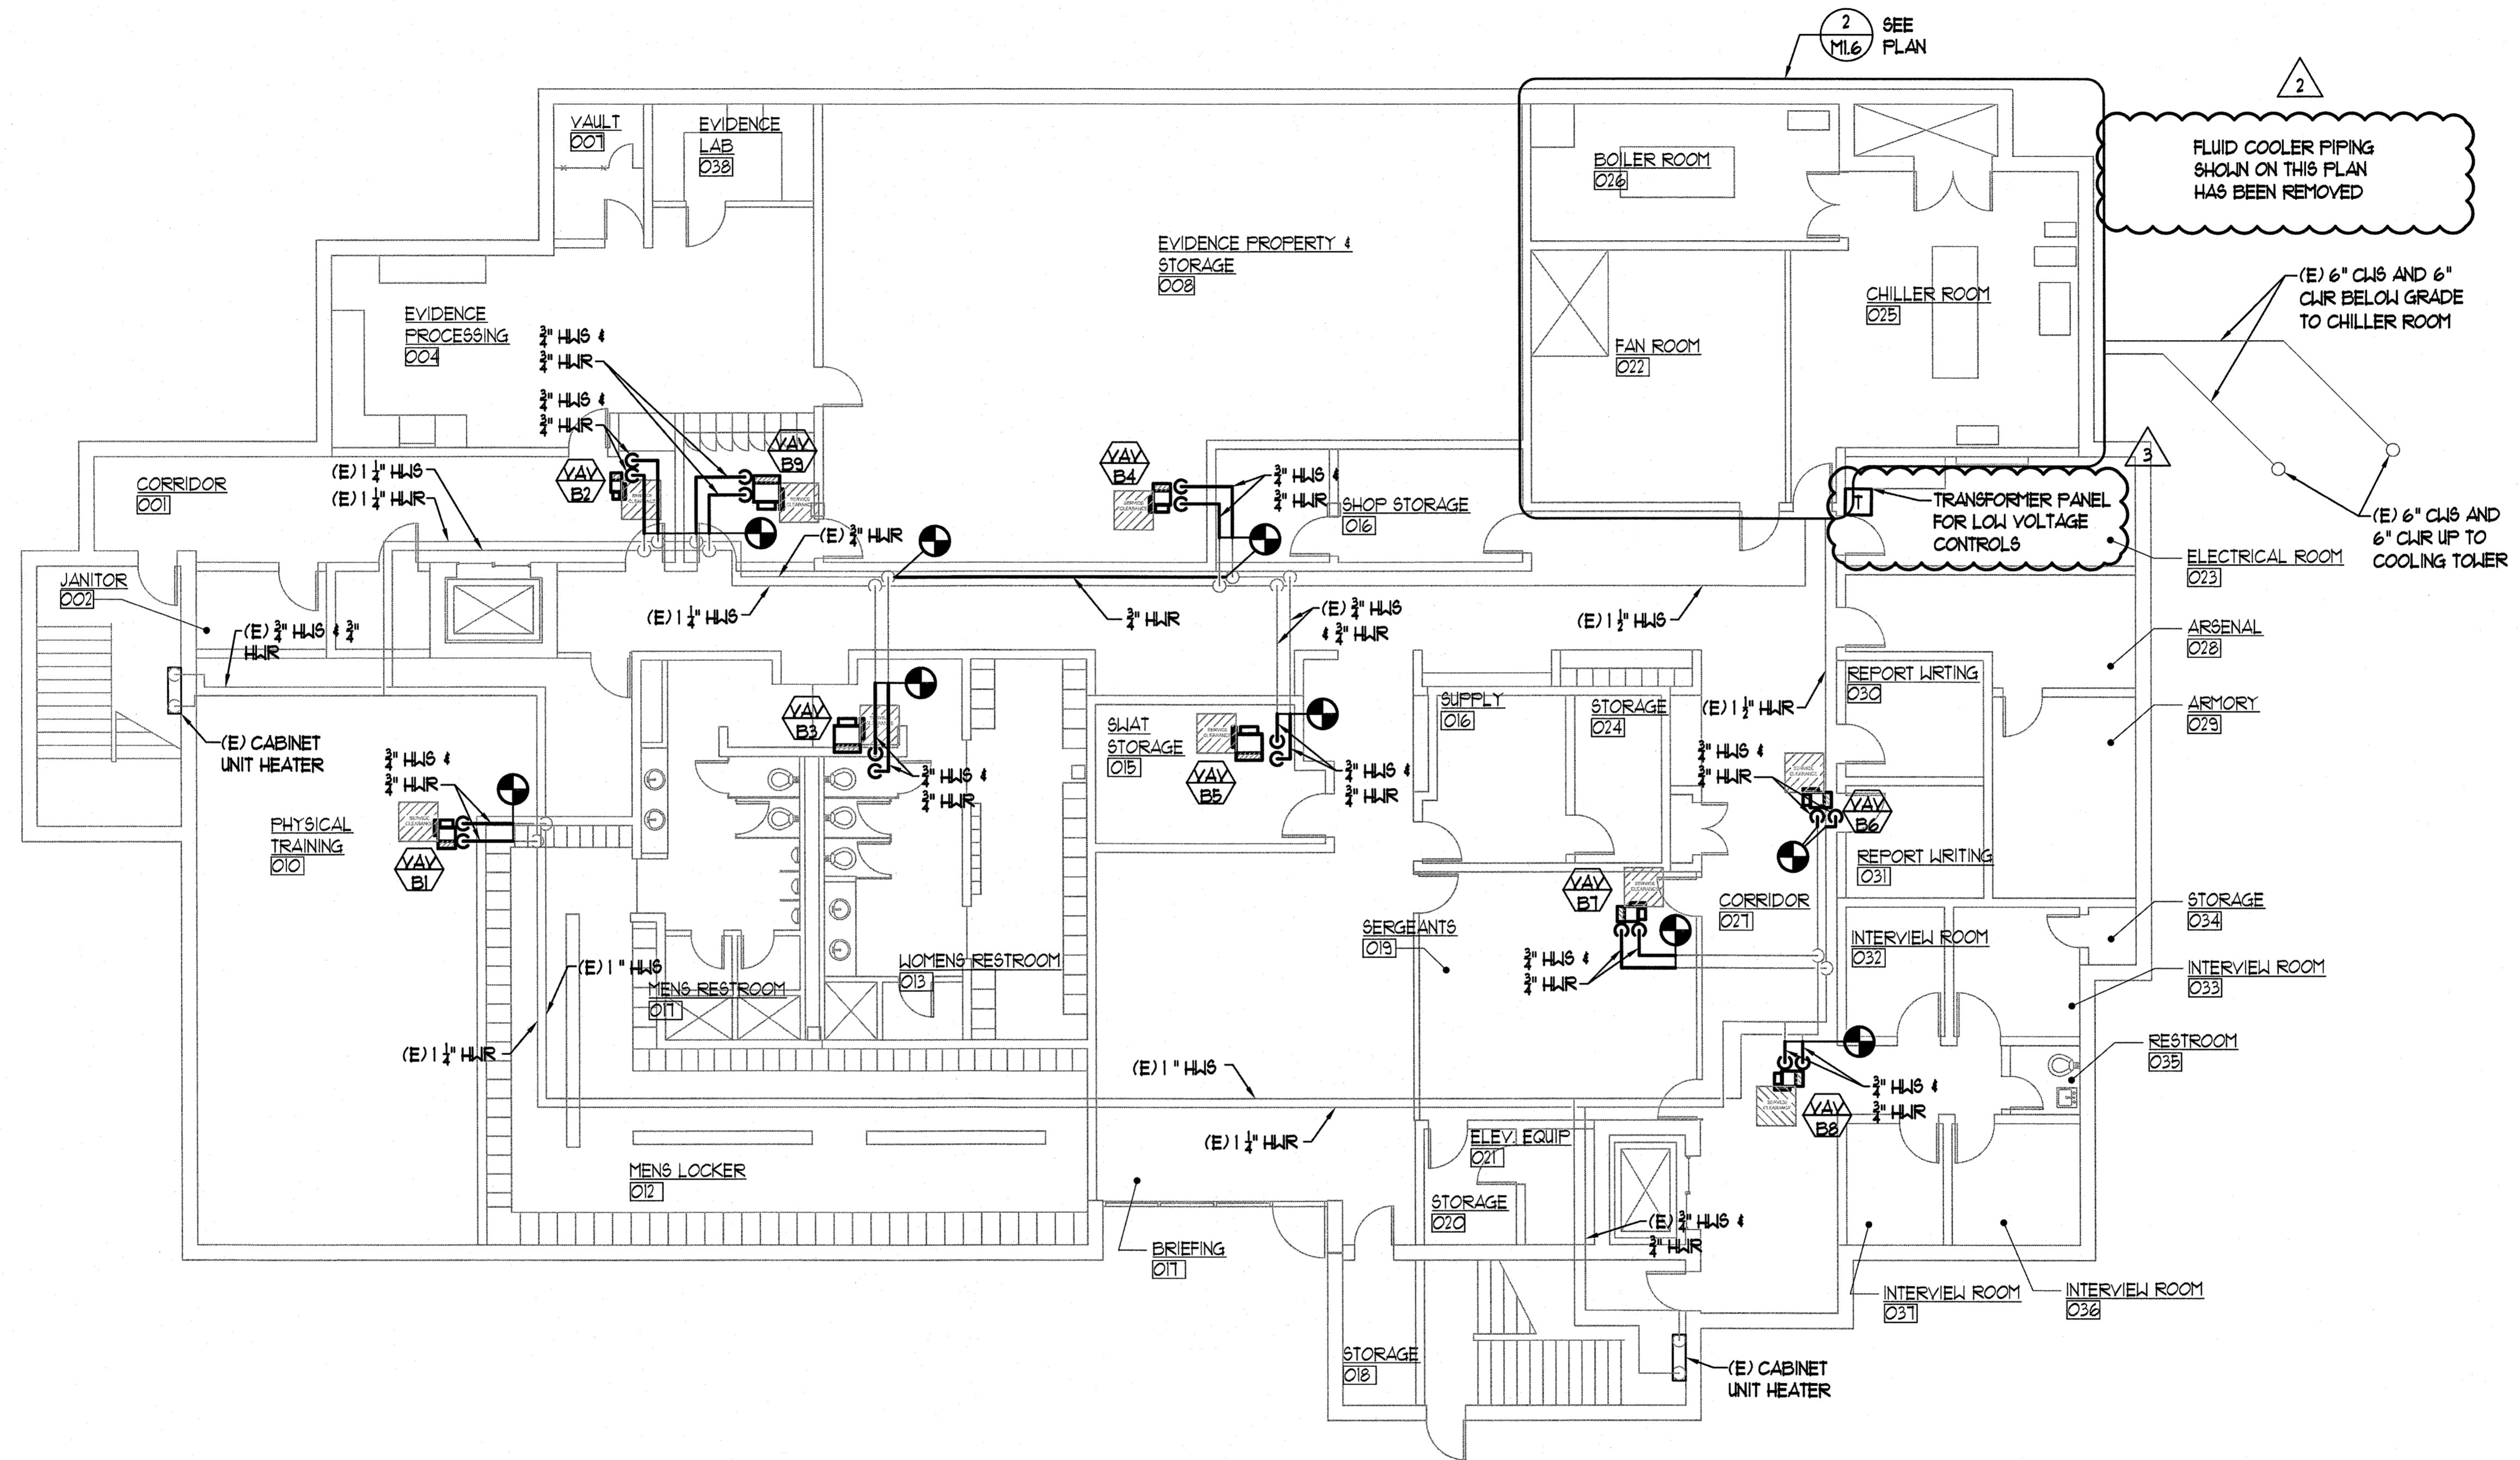

1 MECHANICAL PIPING FLOOR PLAN - BASEMENT
 M2.3 SCALE: 1/8" = 1'-0"

MMI ENGINEERING
 385 GENTRY WAY
 RENO, NV, 89502
 (775) 499-5784
 WWW.MMI-DESIGNER.COM
 MMI PROJECT #2016-19

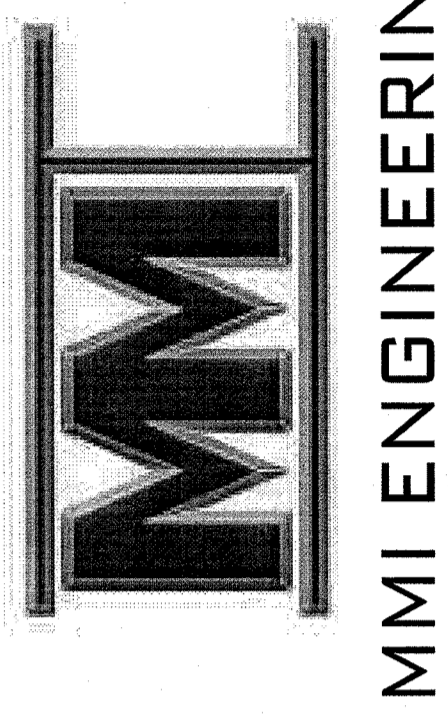


SPARKS POLICE DEPARTMENT
 HVAC UPGRADE PHASE 1
 1701 EAST PRATER WAY
 SPARKS, NEVADA 89434

SHEET TITLE
 MECHANICAL PIPING
 FLOOR PLAN
 - BASEMENT


REVISIONS

1	PLAN REVIEW COMMENTS (04/09/18)
2	OWNER REVISIONS (10/31/18)
3	OWNER REVISIONS (06/04/19)

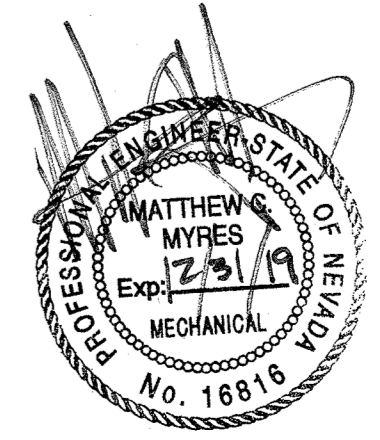


BID DOCUMENTS

DATE: 06/07/2018
 COMMUNITY SERVICES BLDG. DIV.
 SHEET NUMBER: M2.3
 JUN 07 2018

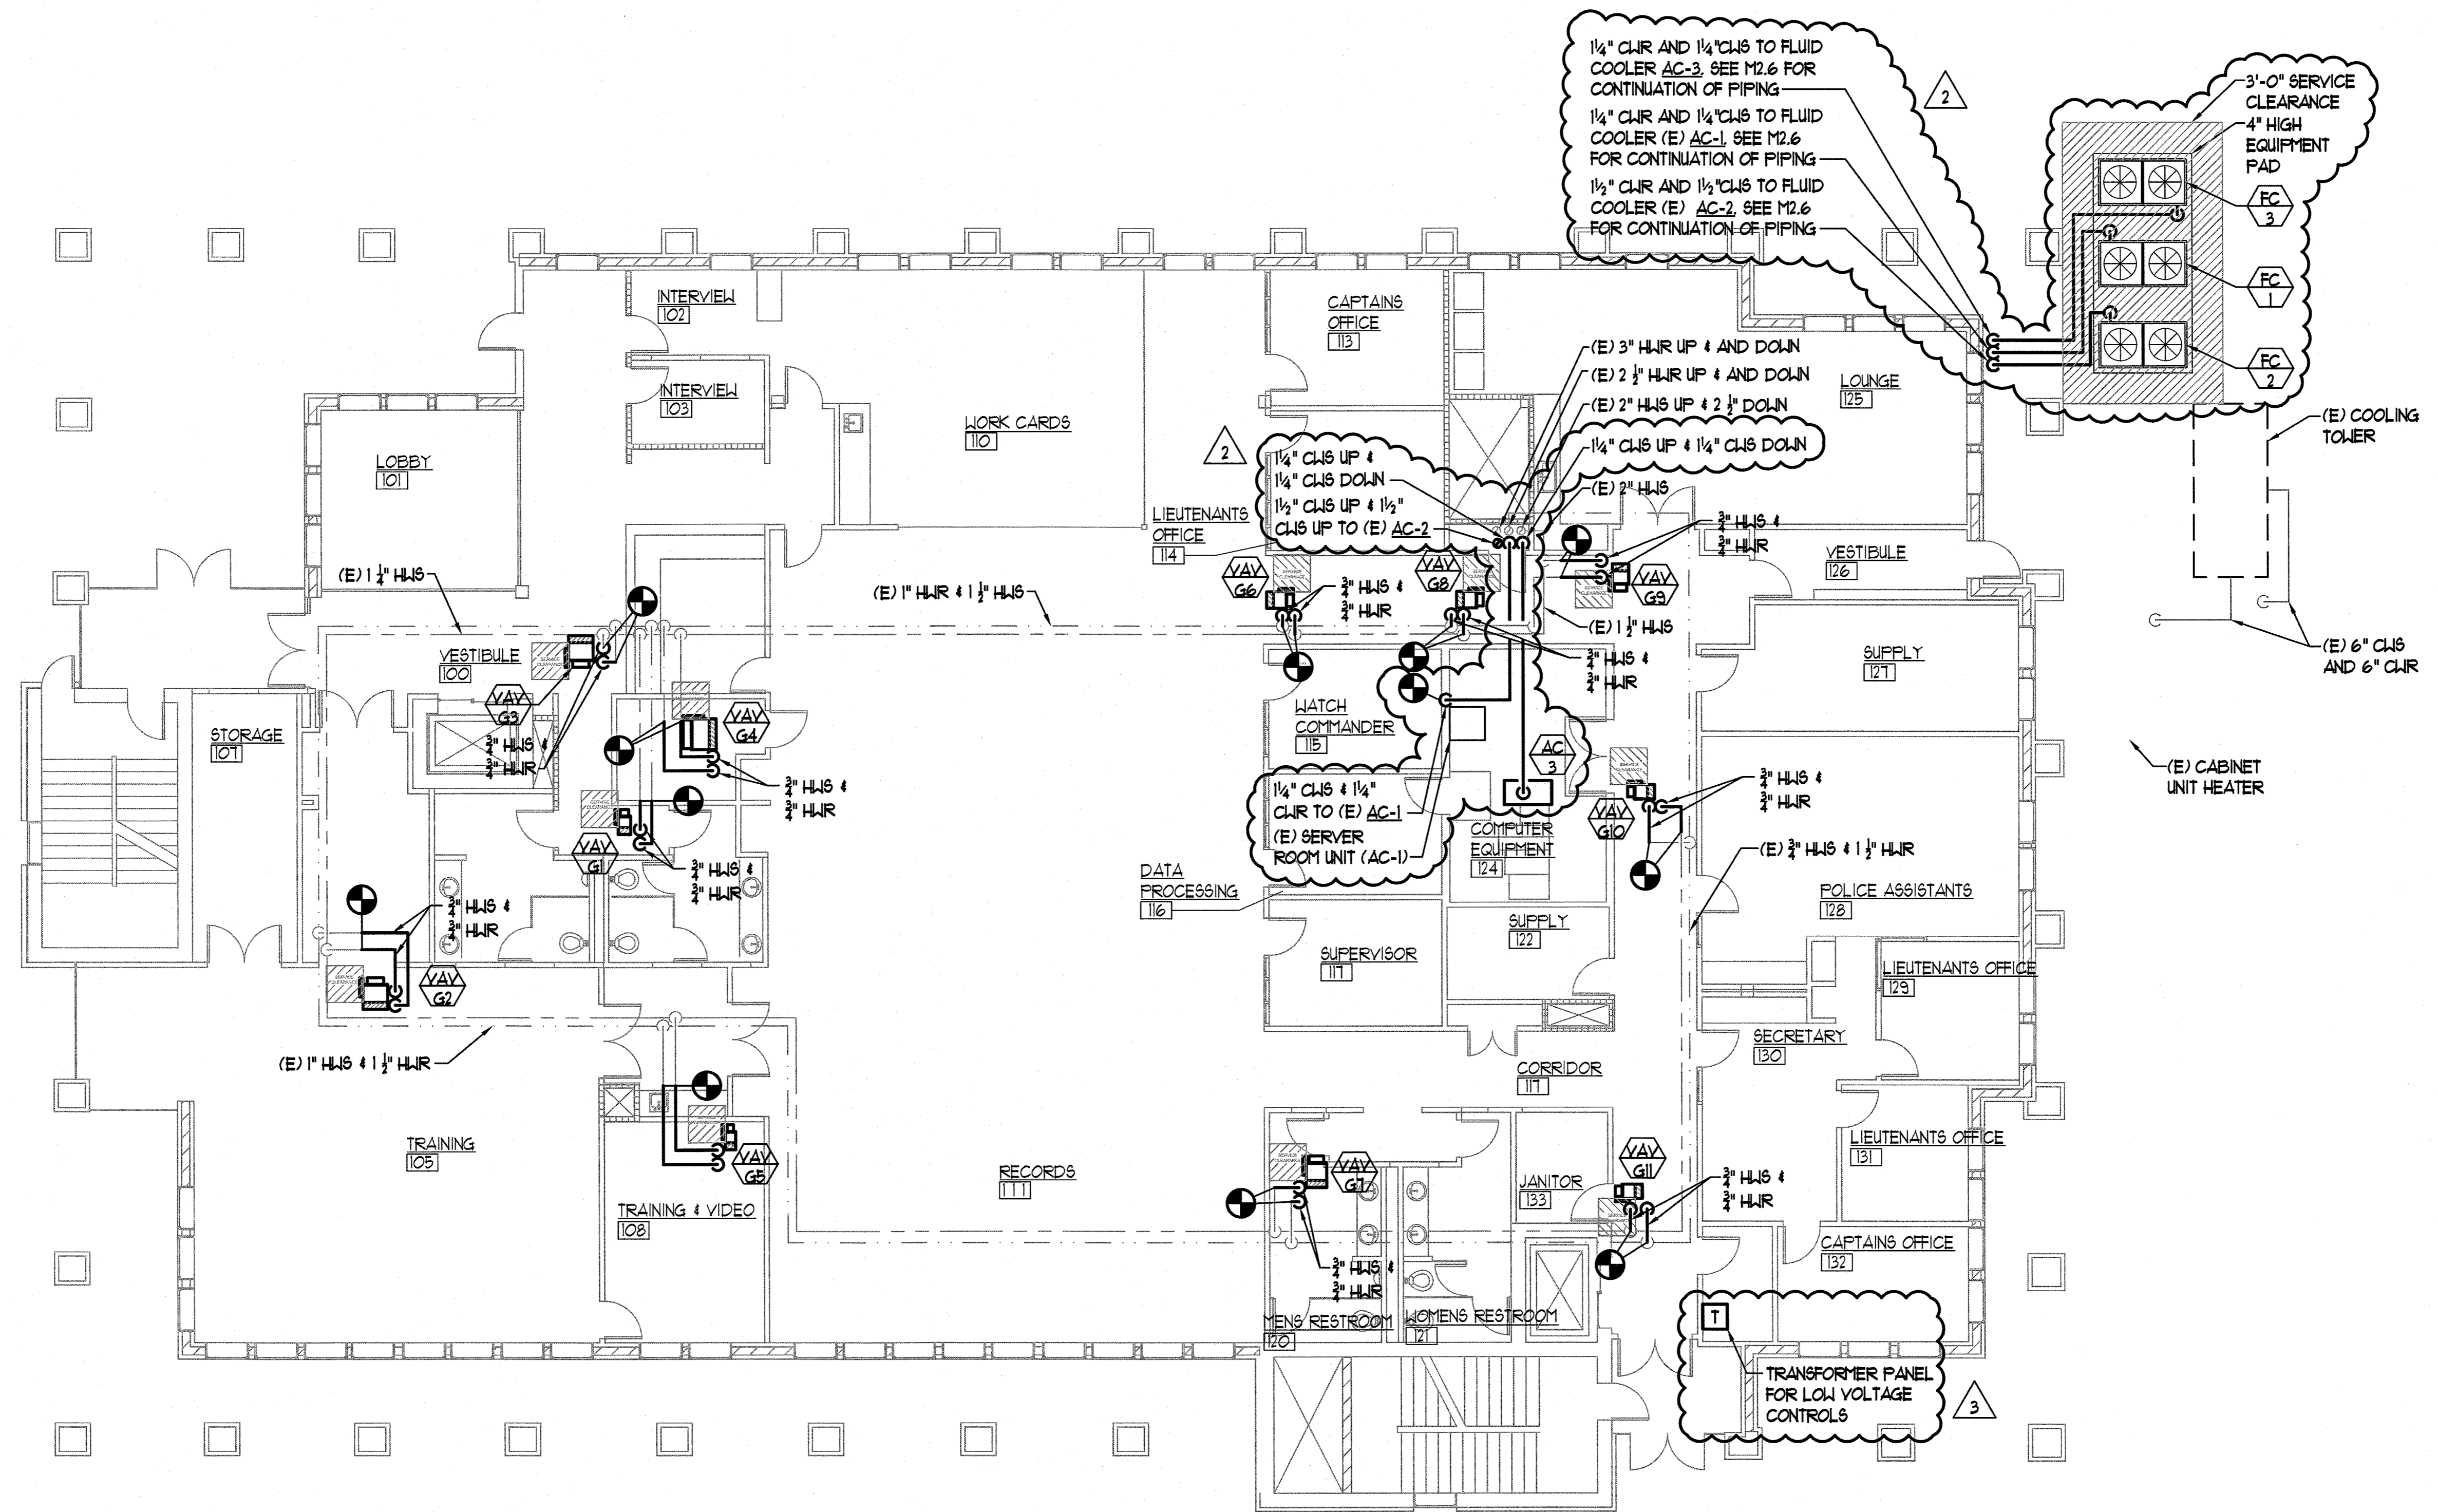

1
M2.4 MECHANICAL PIPING FLOOR PLAN - GROUND FLOOR
SCALE: 1/8" = 1'-0"

MMI ENGINEERING
385 GENTRY WAY
RENO, NV, 89502
(775) 499-5784
WWW.MMI-DESIGNER.COM
MMI PROJECT #2016-19

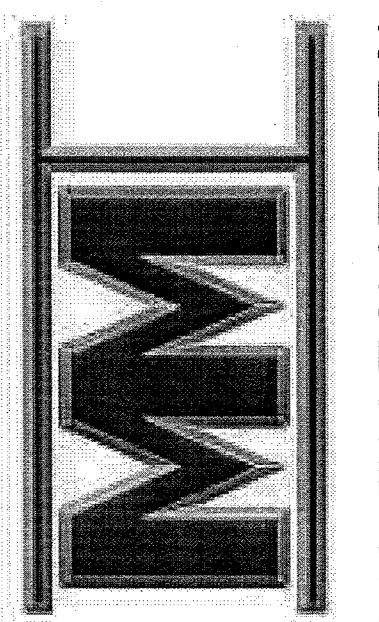


MMI ENGINEERING

SPARKS POLICE DEPARTMENT
HVAC UPGRADE PHASE 1
1701 EAST PRATER WAY
SPARKS, NEVADA 89434

SHEET TITLE
MECHANICAL PIPING
FLOOR PLAN
- GROUND FLOOR


REVISIONS

1	PLAN REVIEW COMMENTS (04/09/18)
2	OWNER REVISIONS (10/31/18)
3	OWNER REVISIONS (06/04/19)

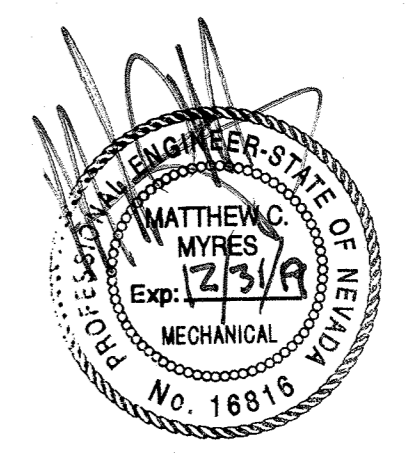


DATE: MARCH 26, 2018
CITY OF SPARKS
COMMUNITY SERVICES-BLDG. DIV.
JUN 07 2018
M2.4
REVISED

BID DOCUMENTS

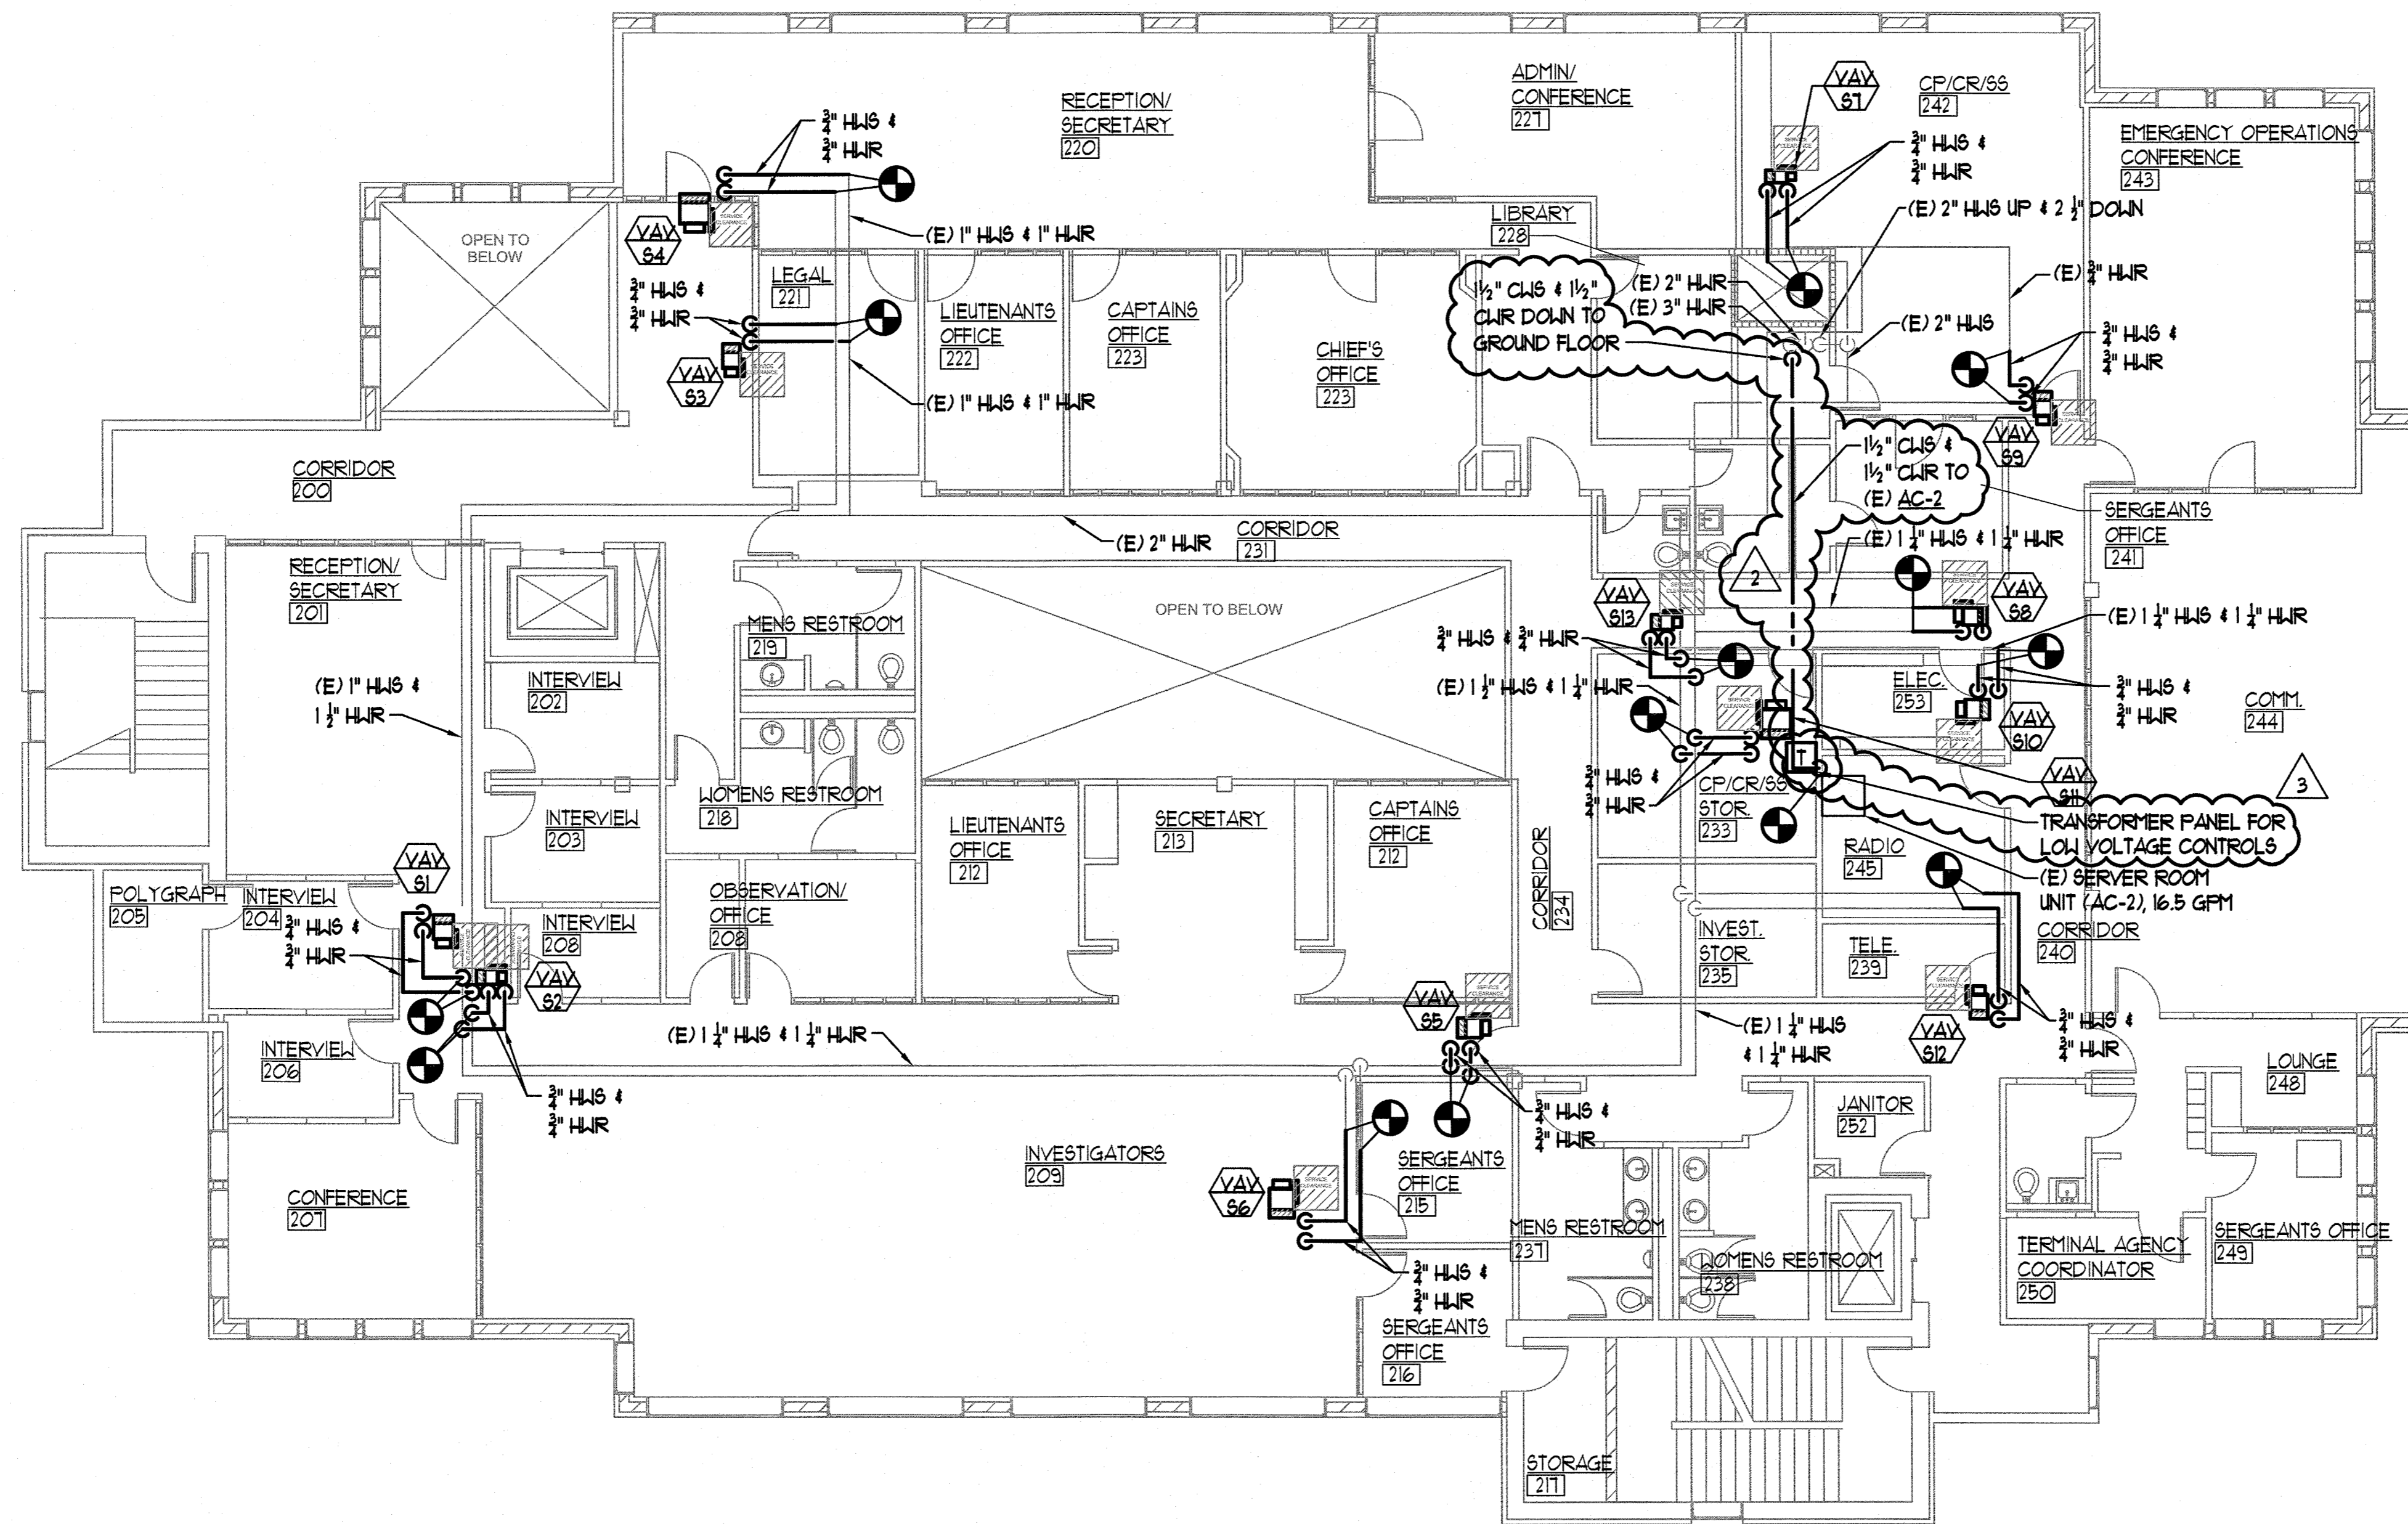

1 MECHANICAL PIPING FLOOR PLAN - SECOND FLOOR
 M2.5 SCALE: 1/8" = 1'-0"

MMI ENGINEERING
 385 GENTRY WAY
 RENO, NV. 89502
 (775) 499-5784
 WWW.MMI-ENGINEER.COM
 MMI PROJECT #2016-19

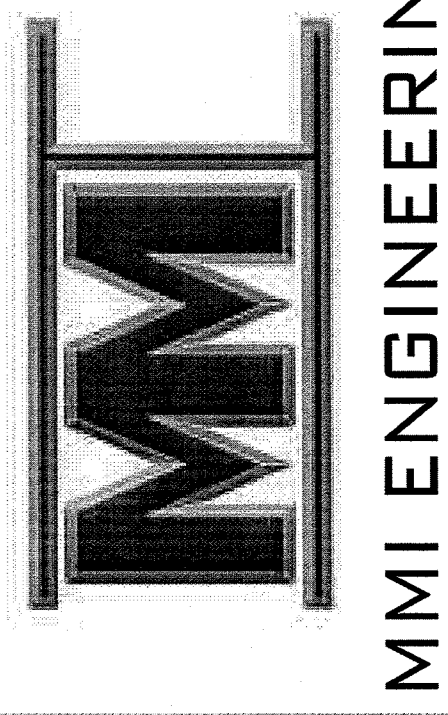


SPARKS POLICE DEPARTMENT
 HVAC UPGRADE PHASE 1
 1701 EAST PRATER WAY
 SPARKS, NEVADA 89434

SHEET TITLE
 MECHANICAL PIPING
 FLOOR PLAN
 - SECOND FLOOR


REVISIONS

1	PLAN REVIEW COMMENTS (04/09/18)
2	OWNER REVISIONS (10/31/18)
3	OWNER REVISIONS (06/04/19)

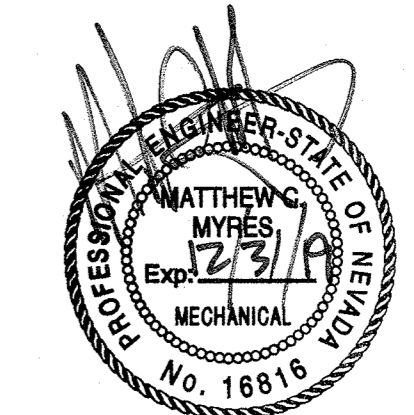


BID DOCUMENTS

CITY OF SPARKS
 COMMUNITY SERVICES BLDG. DIV.
 DATE: MARCH 26, 2018
 SHEET NUMBER: JUN 07 2019
 REVISED
 M2.5

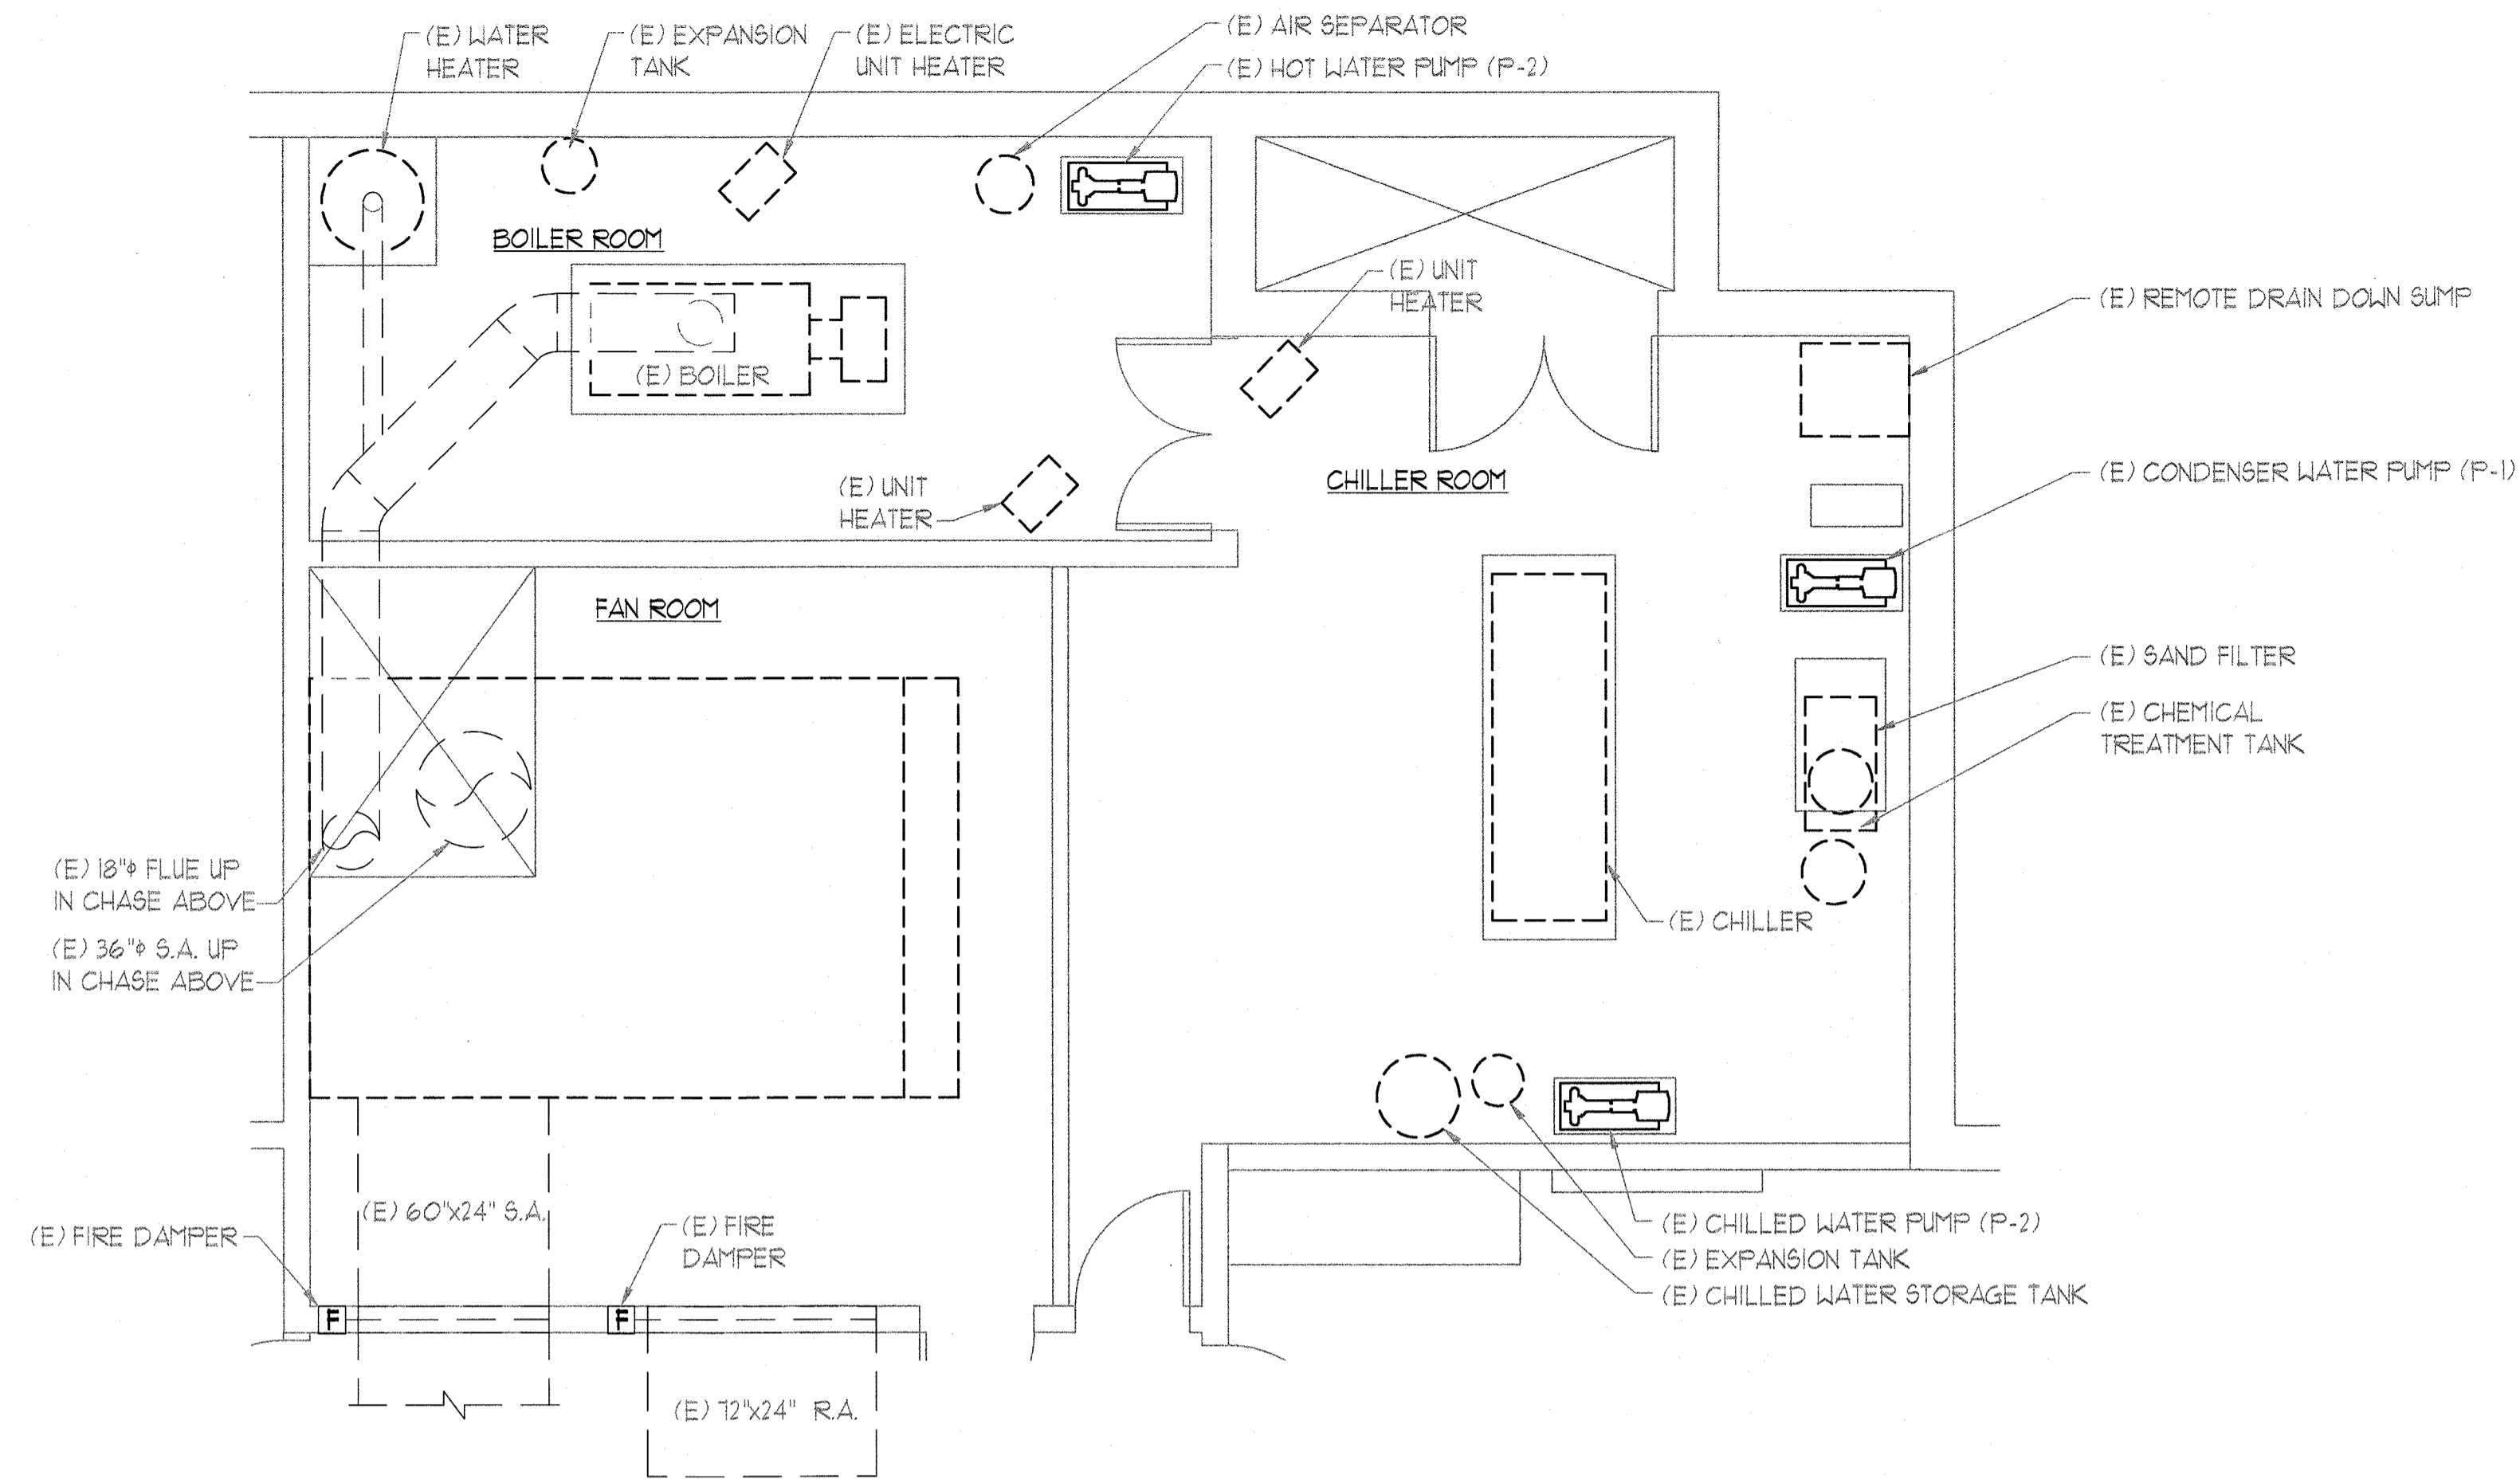


1 MECHANICAL ENLARGED PLAN
M2.6 SCALE: 1/4" = 1'-0"

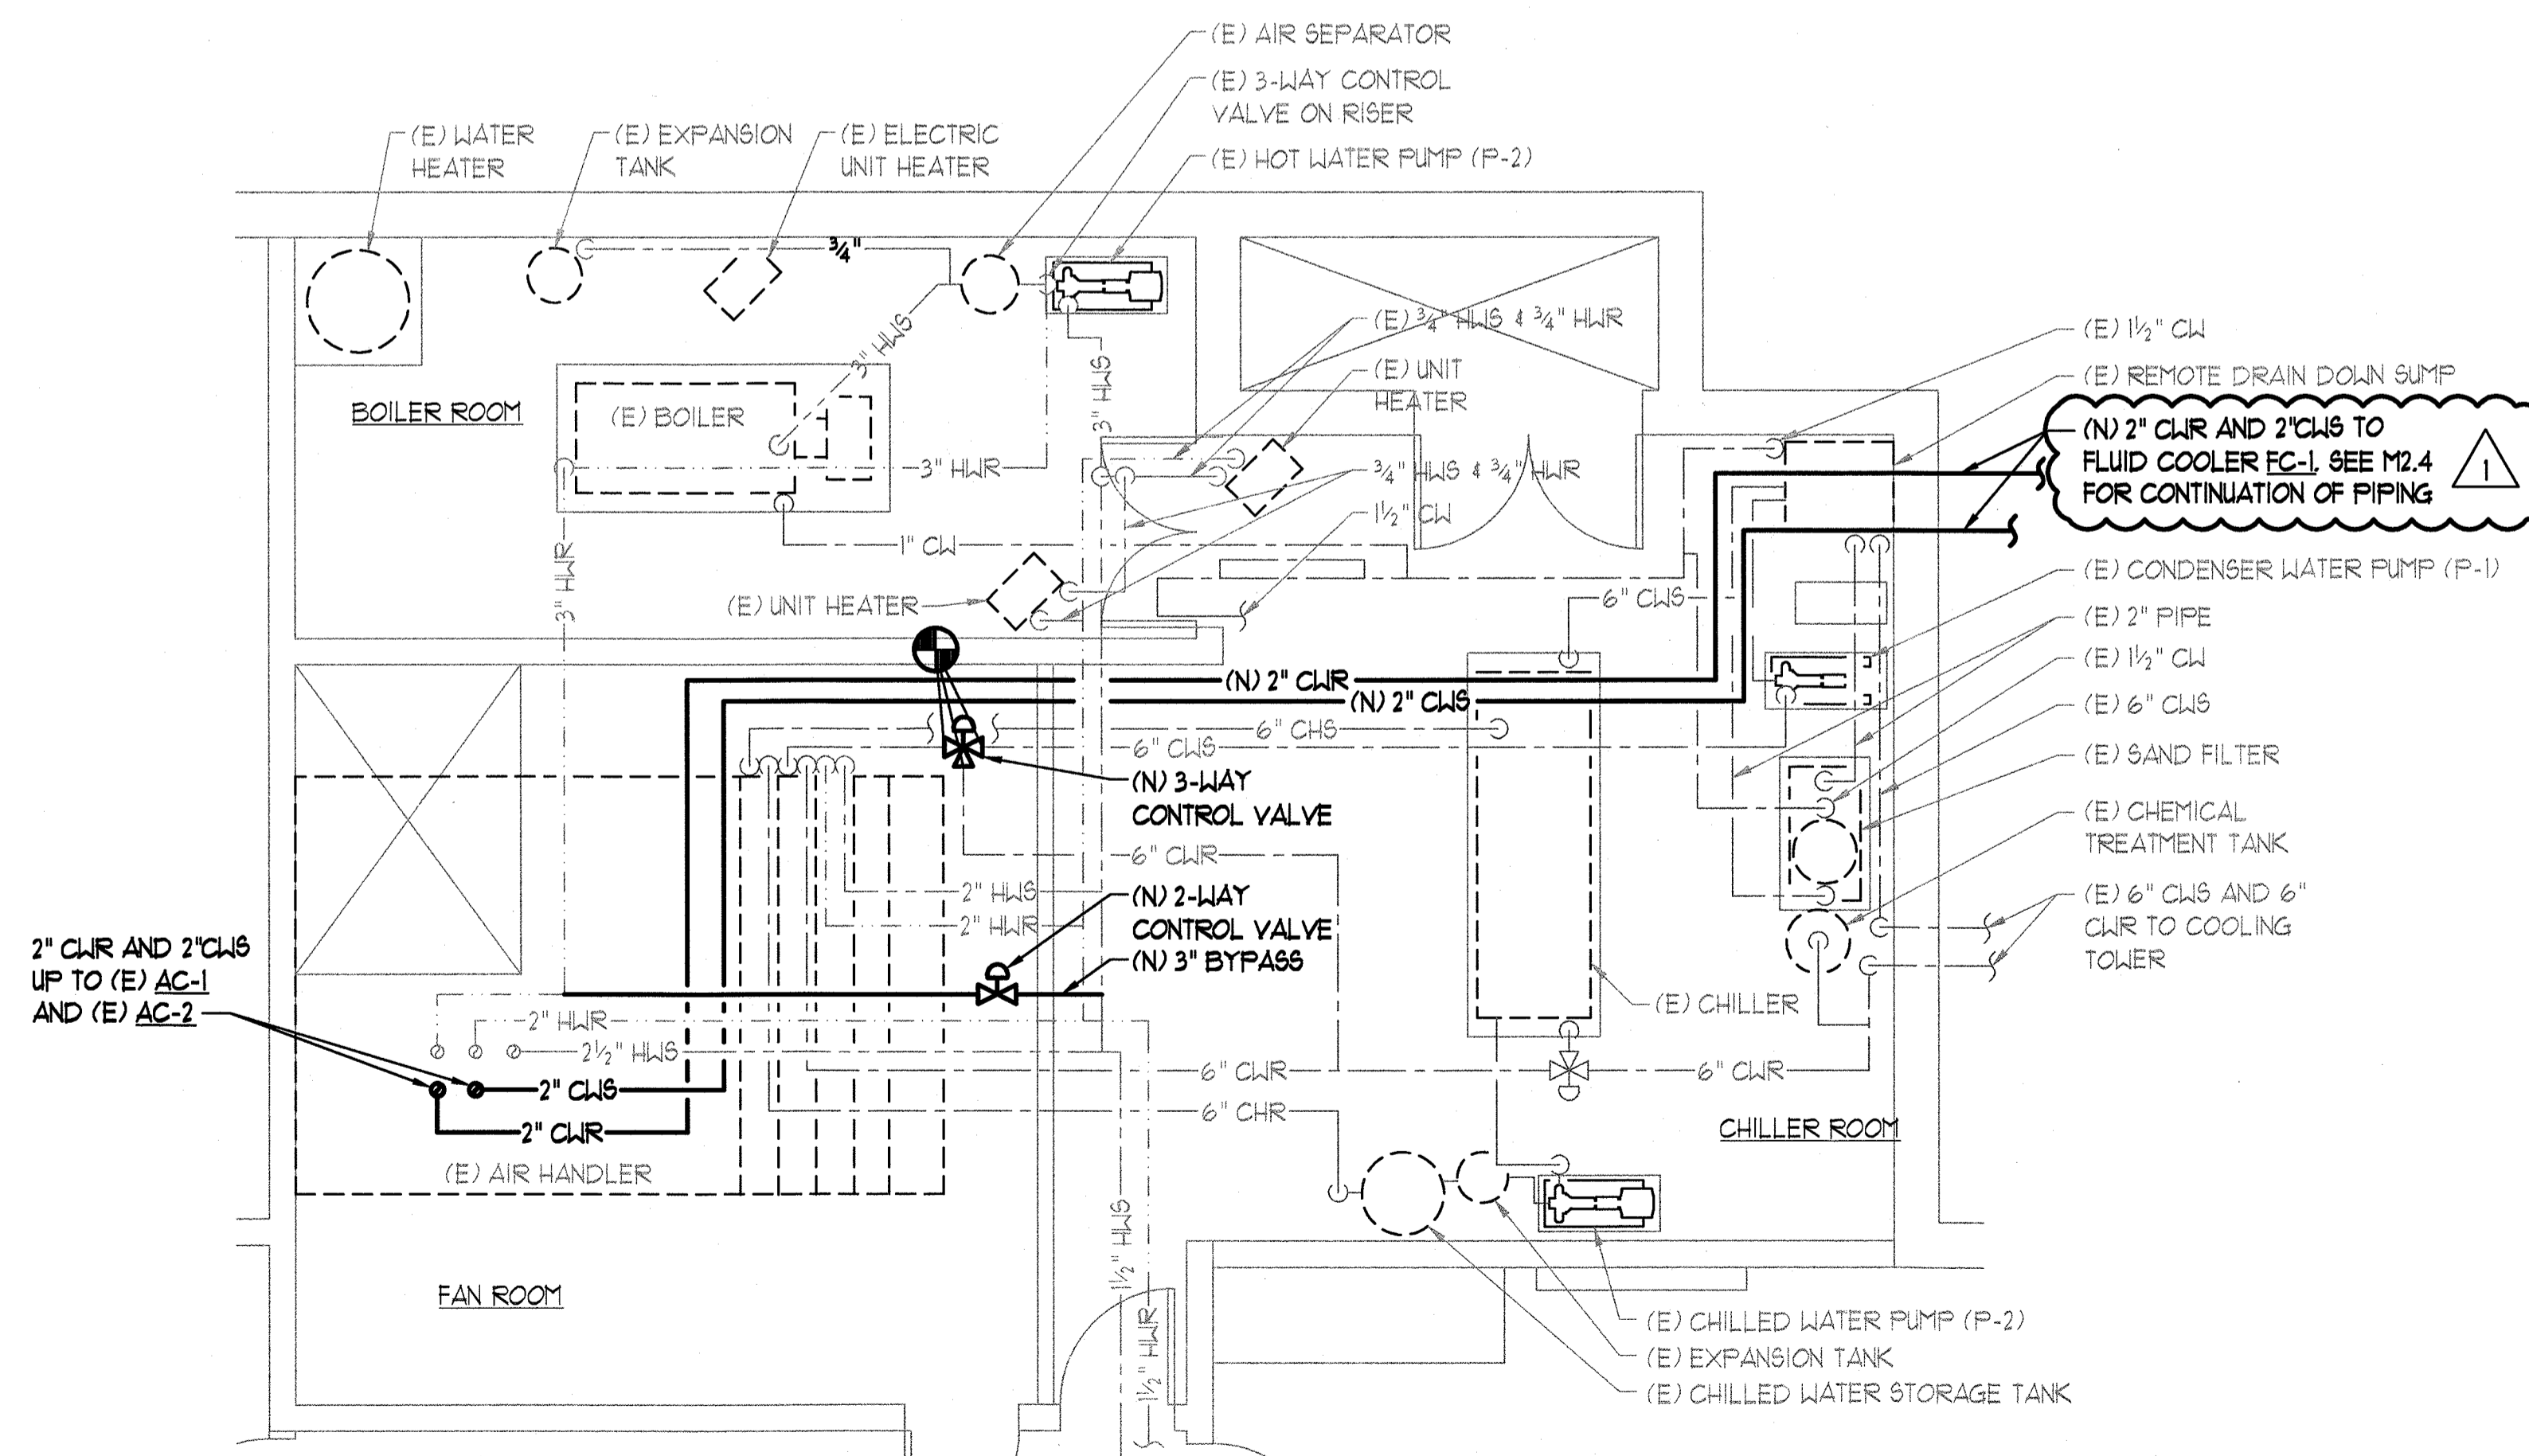

2 MECHANICAL PIPING ENLARGED PLAN
M2.6 SCALE: 1/4" = 1'-0"

MMI ENGINEERING
385 GENTRY WAY
RENO, NV. 89502
(775) 499-5784
WWW.MMI-DESIGNER.COM
MMI PROJECT #2016-19

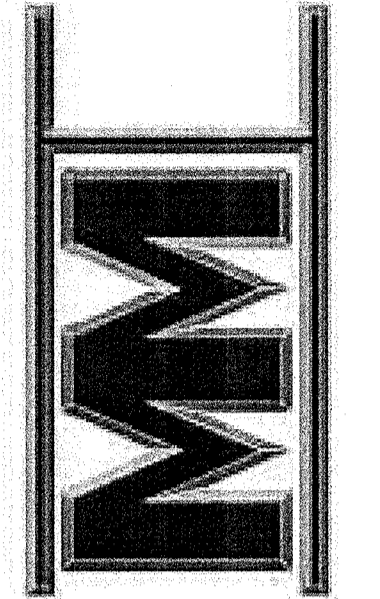


MMI ENGINEERING

SPARKS POLICE DEPARTMENT
HVAC UPGRADE PHASE 1
1701 EAST PRATER WAY
SPARKS, NEVADA 89434

SHEET TITLE
MECHANICAL ENLARGED PLANS

REVISIONS
PLAN REVIEW COMMENTS (04/09/18)

CITY OF SPARKS
COMMUNITY SERVICES-BLDG. DIV.
AUG 20 2018
REVISED

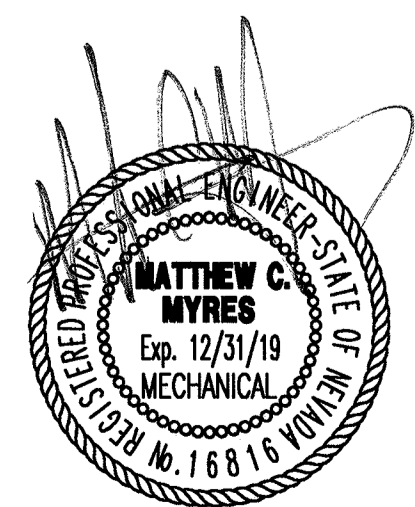


BID DOCUMENTS

DATE: MARCH 26, 2018
SHEET NUMBER:


M2.6

3/26/2018

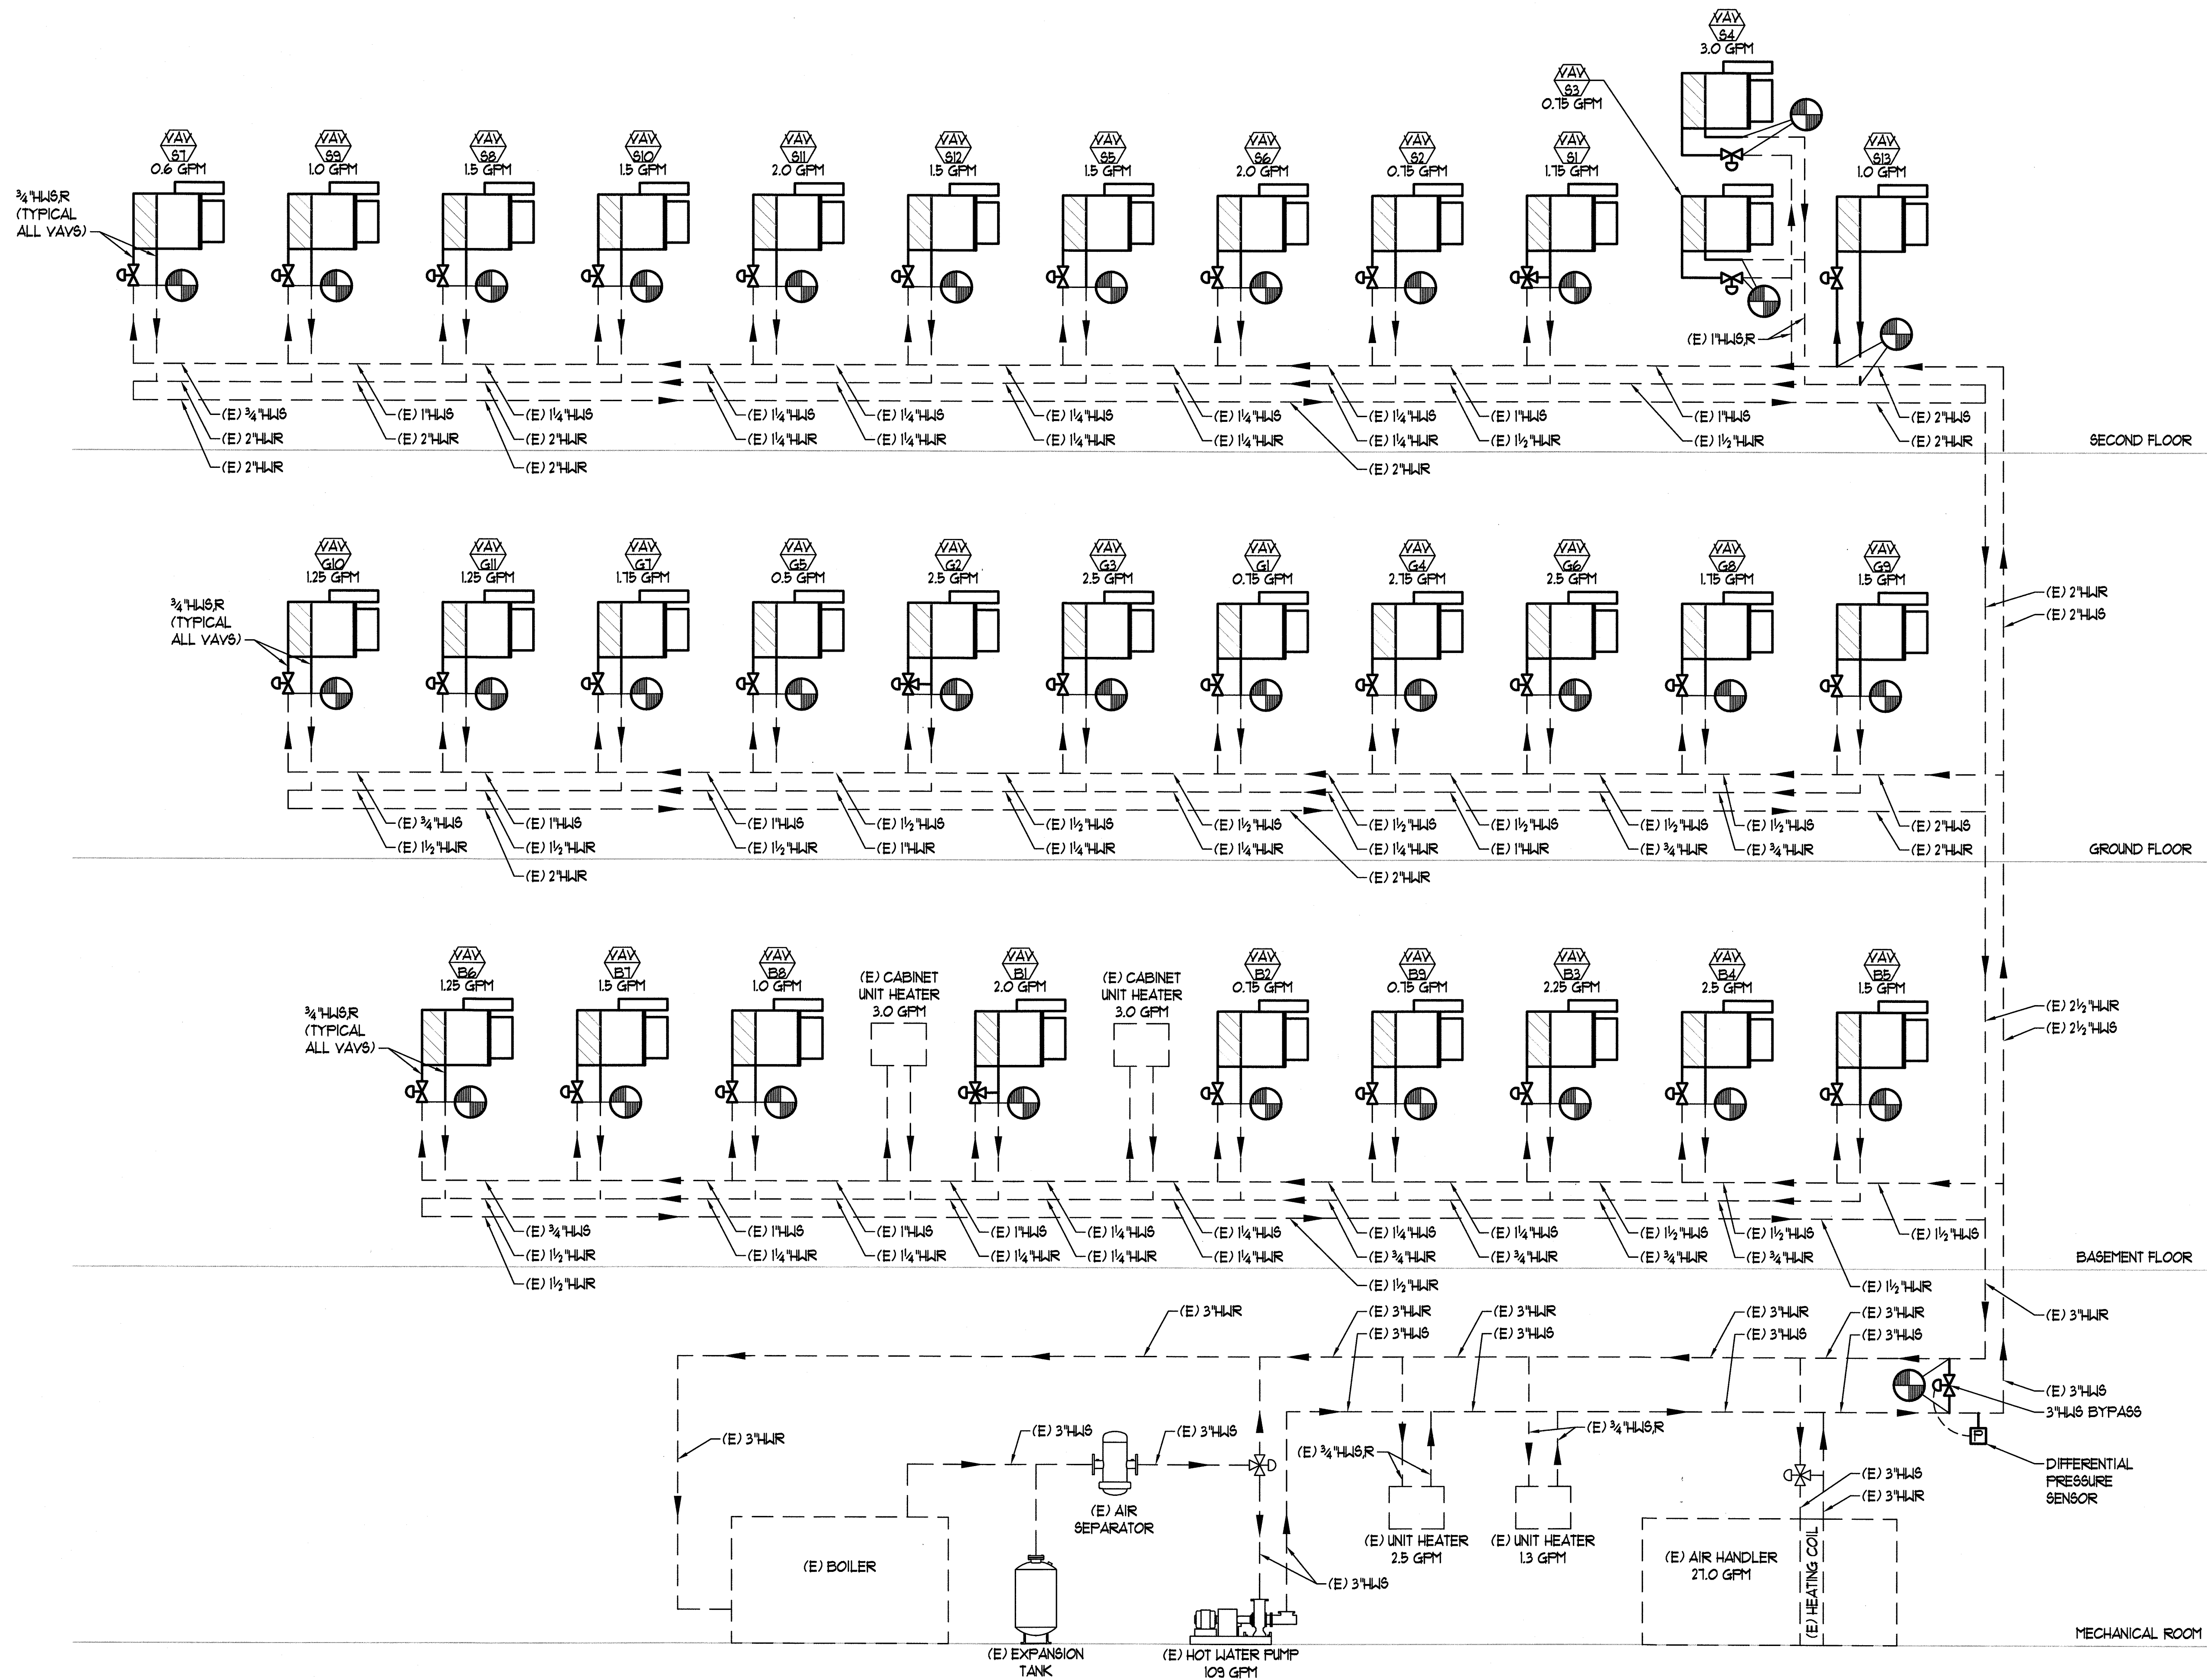

1 HEATING HOT WATER PIPING DIAGRAM
M4.1 SCALE: NONE

MMI ENGINEERING
385 GENTRY WAY
RENO, NV. 89502
(775) 499-5784
WWW.MMIE-DESIGNER.COM
MMI PROJECT #2016-19

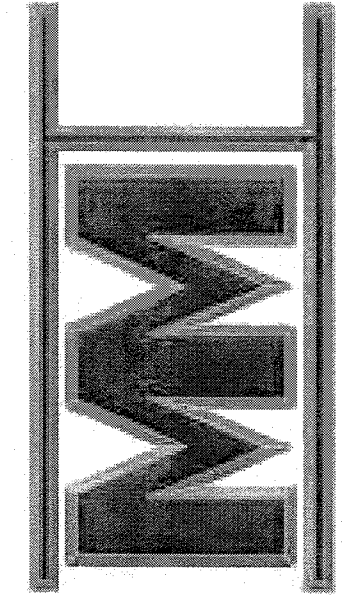


MMI ENGINEERING

SPARKS POLICE DEPARTMENT
HVAC UPGRADE PHASE 1
1701 EAST PRATER WAY
SPARKS, NEVADA 89434

SHEET TITLE
MECHANICAL PIPING
DIAGRAM


REVISIONS

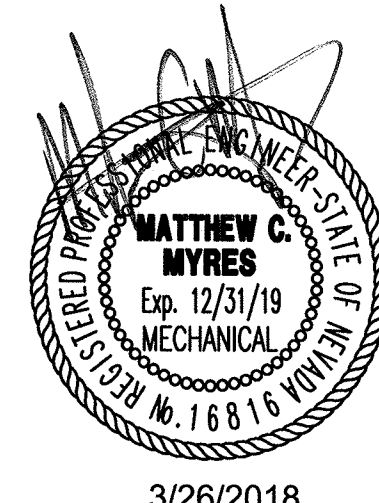

3/26/2018

BID DOCUMENTS

DATE: RECEIVED-CITY OF SPARKS
MARCH 26, 2018
SHEET NUMBER: MAR 28 2018
COMMUNITY SERVICES
BUILDING DIVISION
M4.1

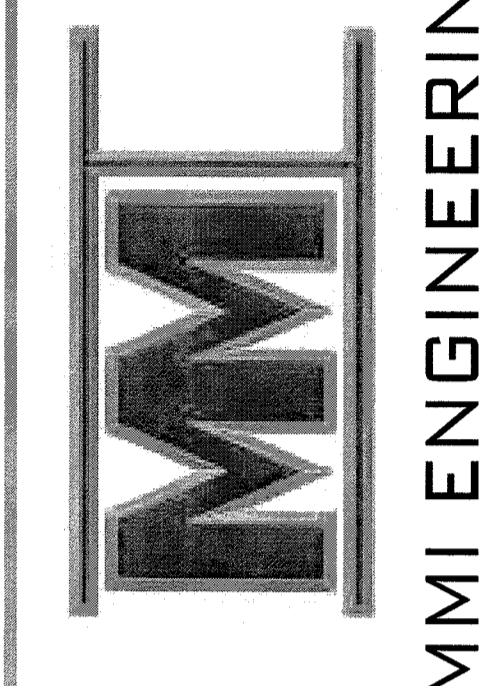

SPARKS POLICE DEPARTMENT
 HVAC UPGRADE PHASE 1
 1701 EAST PRATER WAY
 SPARKS, NEVADA 89434

SHEET TITLE
 MECHANICAL CONTROLS

REVISIONS

DATE: MARCH 28, 2018 OF SPARKS
 SHEET NUMBER: MAR 28 2018
 COMMUNITY SERVICES
 DIVISION
M5.1

BID DOCUMENTS



TYPICAL TERMINAL UNIT CONTROL

OCCUPIED CYCLE:

- AHU SUPPLY FAN STARTS AND MAINTAINS DUCT STATIC PRESSURE SETPOINT.
- ROOM TEMPERATURE SENSOR MODULATES TERMINAL UNIT DAMPER AND HEATING WATER VALVE IN SEQUENCE TO MAINTAIN RESPECTIVE HEATING/COOLING SET POINTS. A DEADBAND BETWEEN HEATING AND COOLING IS FIELD PROGRAMMABLE WITH A 2 DEGREE F MINIMUM.
- AHU VFD TO INCREASE FAN SPEED TO MEET REQUIREMENTS FOR AIR FLOW FOR EACH ZONE.

UNOCCUPIED CYCLE:

- TERMINAL UNIT FAN STOPS AT PROGRAMMED TIME.
- TERMINAL UNIT DAMPER CLOSES AND ZONE HEATING WATER VALVE CLOSES.
- ROOM TEMPERATURE SENSOR REVERTS TO "SET-BACK/SET-UP" TEMPERATURE SET POINT.
- MOMENTARY CONTACT PUSH-BUTTON IN ROOM TEMPERATURE SENSORS OVERRIDES "UNOCCUPIED CYCLE" AND PLACES SYSTEM IN "OCCUPIED CYCLE" FOR A PROGRAMMED LENGTH OF TIME.

SETPOINTS:

- OCCUPIED MODE:
 COOLING: 74°F, HEATING: 70°F
- UNOCCUPIED MODE:
 COOLING: 80°F, HEATING: 65°F


SAFETY CONTROL:

- IF COMMUNICATION FAILS BETWEEN TERMINAL UNIT CONTROLLER AND GLOBAL CONTROLLER, THE TERMINAL UNIT CONTROL SHALL AUTOMATICALLY MAINTAIN THE LATEST SET OF OCCUPIED TEMPERATURES OR 74°F COOLING AND 70°F HEATING AS SELECTED BY THE OPERATOR.

*NOTES:


- EXISTING VAV-SD DDC CONTROLLER TO BE REMOVED AND RE-INSTALLED ON NEW VAV TERMINAL UNIT.
- EXISTING ROOM SENSOR TO BE RE-USED.
- NEW HEATING WATER VALVE TO BE PROVIDED BY CONTROL CONTRACTOR AND INSTALLED BY MECHANICAL CONTRACTOR.
- NEW DAMPER ACTUATOR TO BE PROVIDED AND INSTALLED BY CONTROL CONTRACTOR

CONTROLS SHALL BE ALERTON TO MATCH EXISTING CITY WIDE HVAC CONTROL SYSTEM.
 BY BUILDING CONTROL SERVICES, INC.
 8521 WHITE FIR ST., SUITE C1A
 RENO, NV 89523
 PH#: (775) 826-8998
 FAX#: (775) 826-3524
 NO EXCEPTIONS

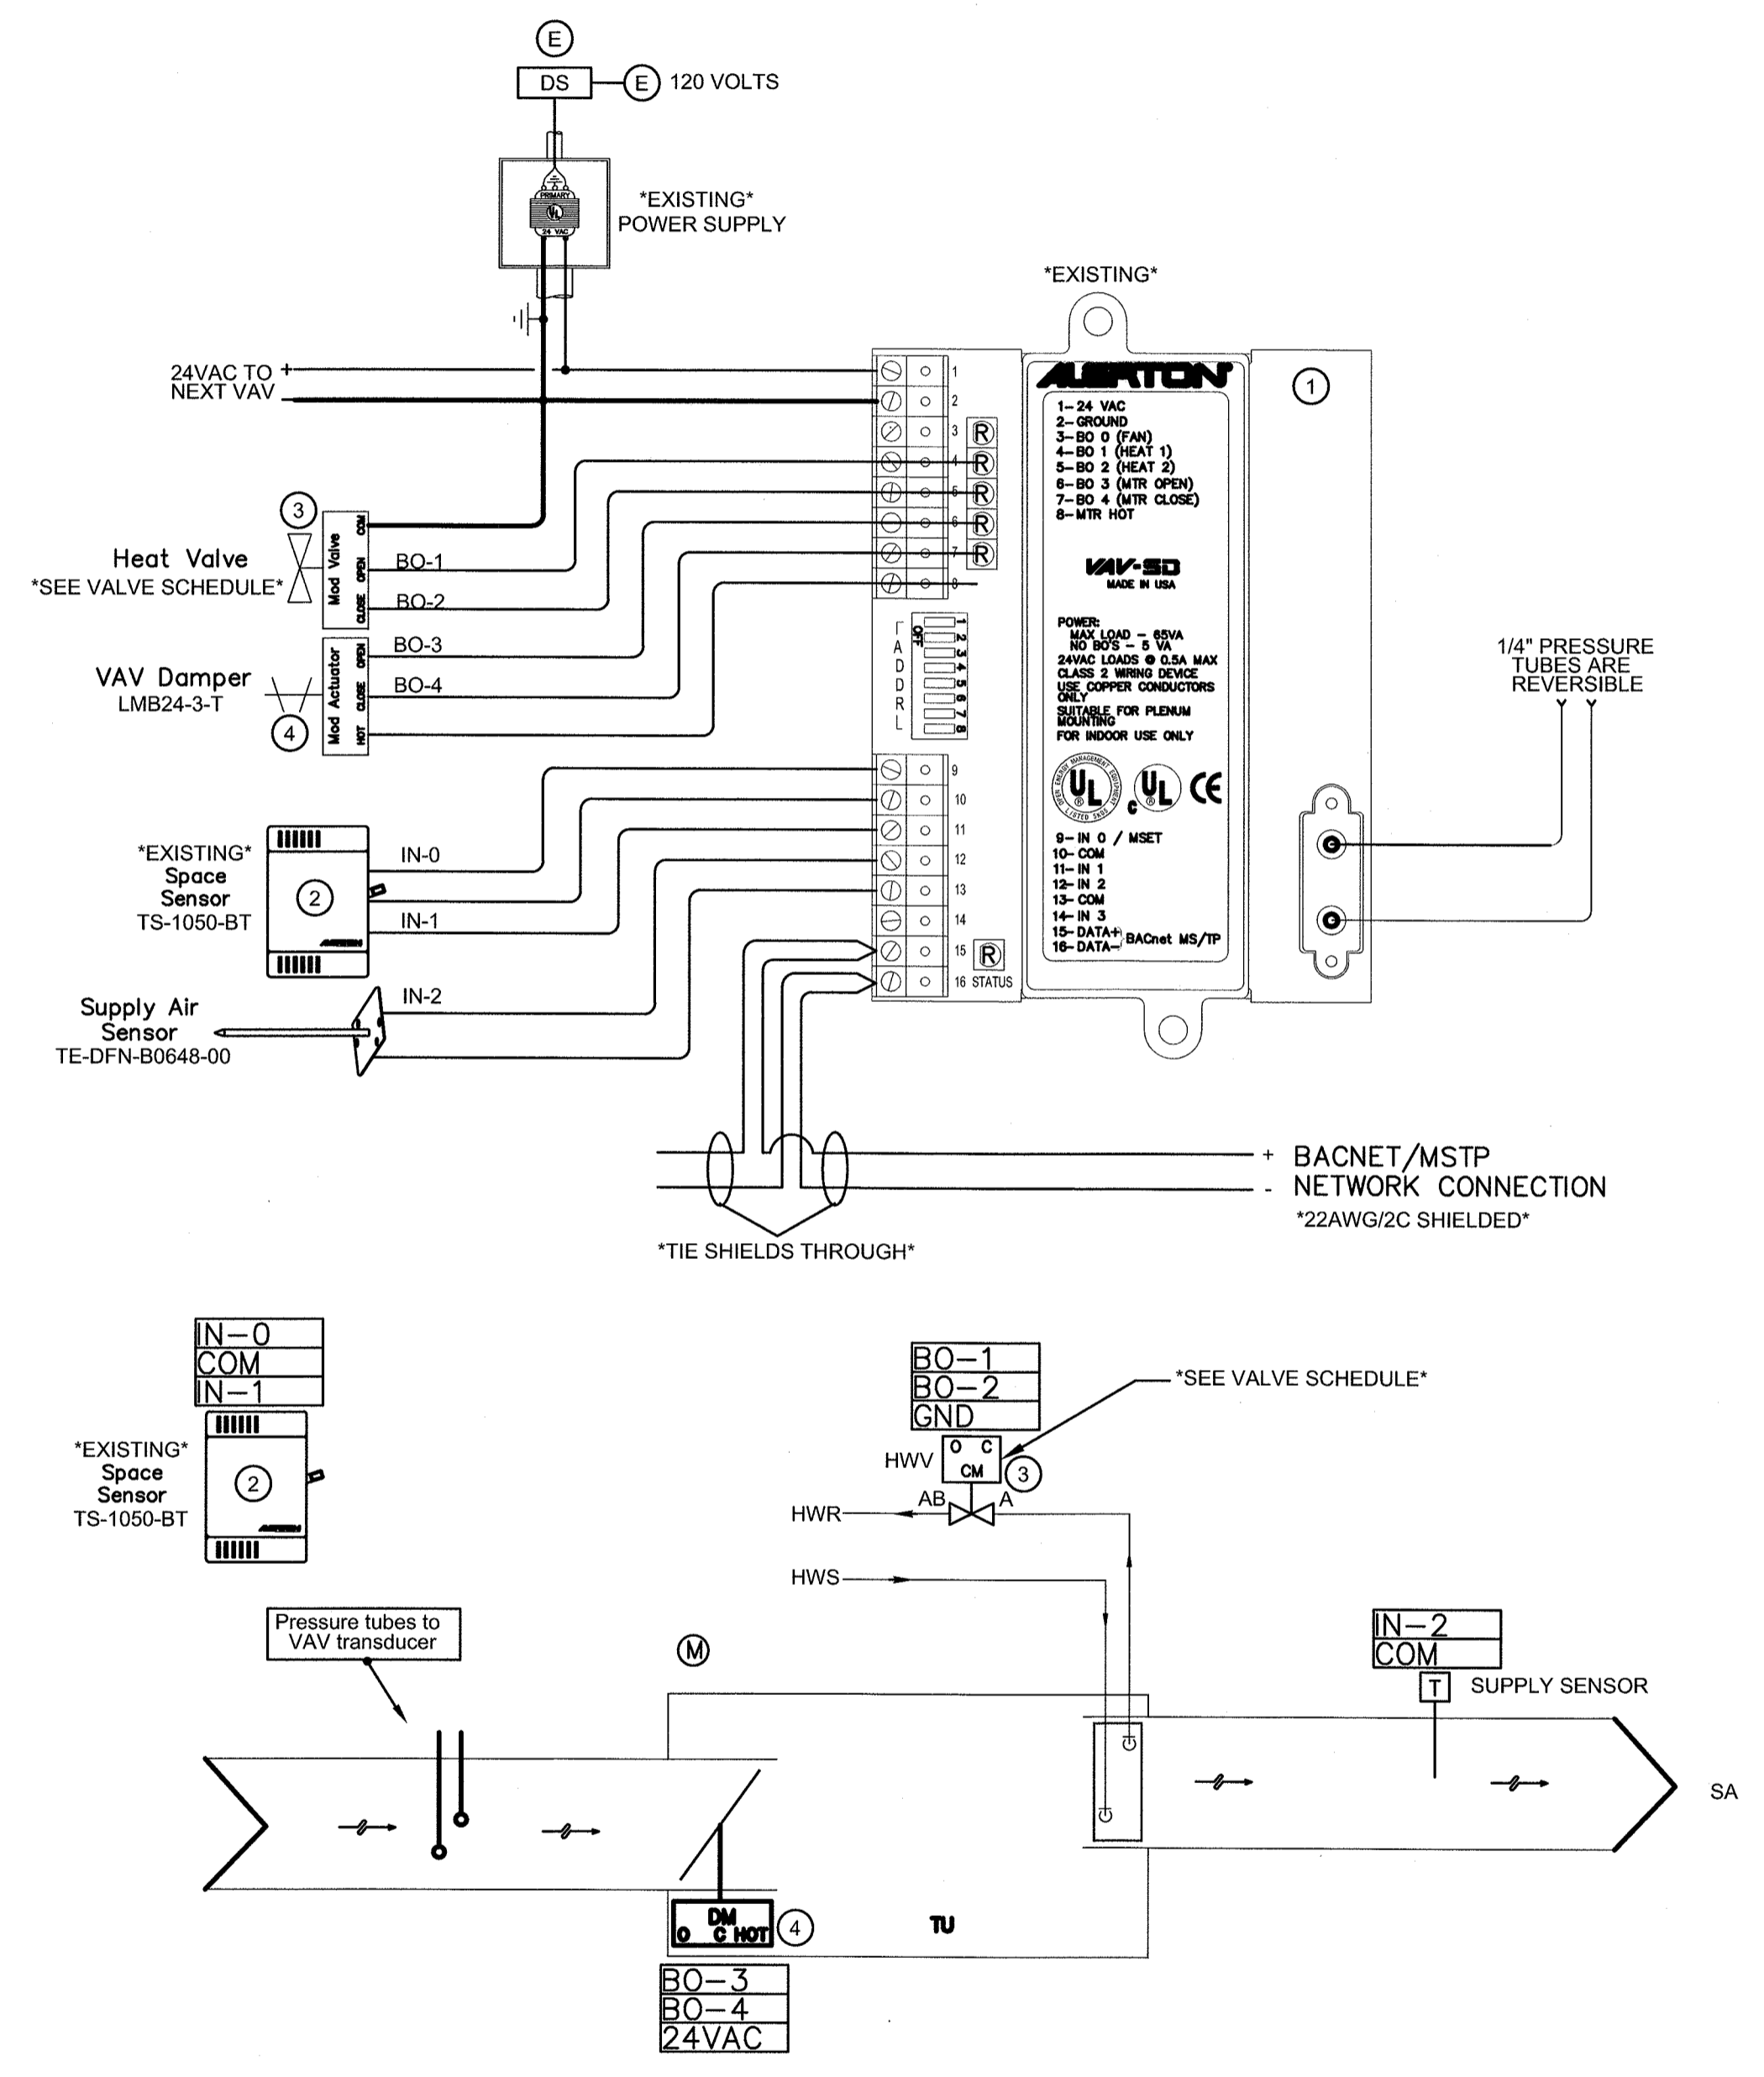

M5.1 MECHANICAL CONTROLS
 SCALE: NONE

MMI ENGINEERING
 385 GENTRY WAY
 RENO, NV. 89502
 (775) 499-5784
 WWW.MMIENGINEERING.COM
 MMI PROJECT #2016-19

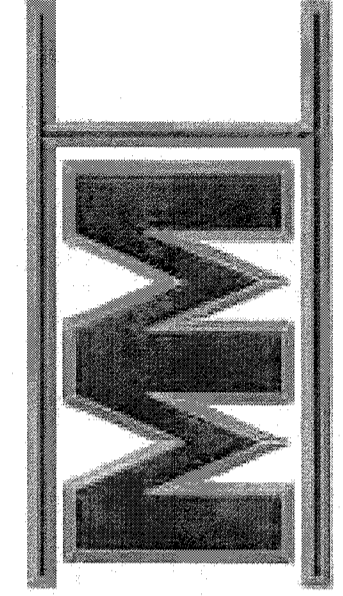

MMI ENGINEERING


SPARKS POLICE DEPARTMENT
 HVAC UPGRADE PHASE 1
 1701 EAST PRATER WAY
 SPARKS, NEVADA 89434

SHEET TITLE
 MECHANICAL CONTROLS (2)

REVISIONS

DATE: MARCH 26, 2018
 SHEET NUMBER: M5.2
 RECEIVED CITY OF SPARKS
 MAR 28 2018
 COMMUNITY SERVICES
 BUILDING DIVISION

BID DOCUMENTS

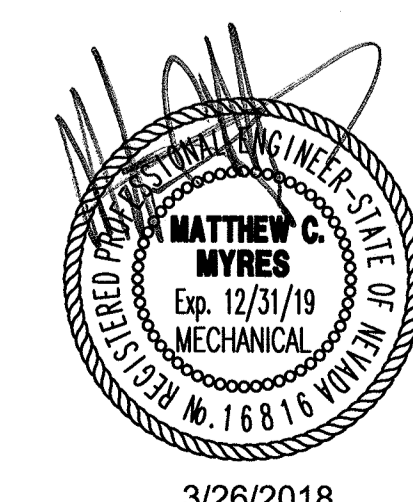


3/26/2018

HW PLANT CONTROL



- HEATING CYCLE:**
- WHENEVER THE OUTSIDE AIR TEMPERATURE IS LESS THAN 68°F(ADJ.), THE HEATING WATER SYSTEM SHALL BE ENABLED.
 - THE HEATING WATER PUMP SHALL START AND THE HW BYPASS VALVE SHALL MODULATE TO MAINTAIN THE HW SYSTEM DIFFERENTIAL PRESSURE SETPOINT OF 10PSI(ADJ.). IF THE HEATING WATER PUMP IS COMMANDED ON AND FAILS TO PROVE STATUS, AN ALARM SHALL BE GENERATED AT THE OPERATOR WORKSTATION.
 - ONCE FLOW HAS BEEN PROVEN VIA BOILER'S INTEGRAL FLOW SWITCH, THE BOILER SHALL BE ENABLED AND SHALL MODULATE THE BURNER VIA BOILER'S INTERNAL CONTROLS TO MAINTAIN THE LEAVING HEATING WATER SETPOINT OF 180°F(ADJ.).
 - THE BUILDING HEATING WATER SUPPLY SETPOINT SHALL BE RESET FROM 180°F(ADJ.) TO 140°F(ADJ.) AS THE OUTSIDE AIR TEMPERATURE INCREASES FROM 30°F(ADJ.) TO 60°F(ADJ.). THE 3-WAY MIXING VALVE SHALL MODULATE TO MAINTAIN THE CURRENT BUILDING HEATING WATER SUPPLY SETPOINT.
- SAFETY:**
- THE BOILER'S INTERNAL SAFETIES SHALL DIASABLE THE BURNER AND SEND AN ALARM TO THE OPERATOR WORKSTATION.

HEATING WATER SUPPLY RESET CURVE

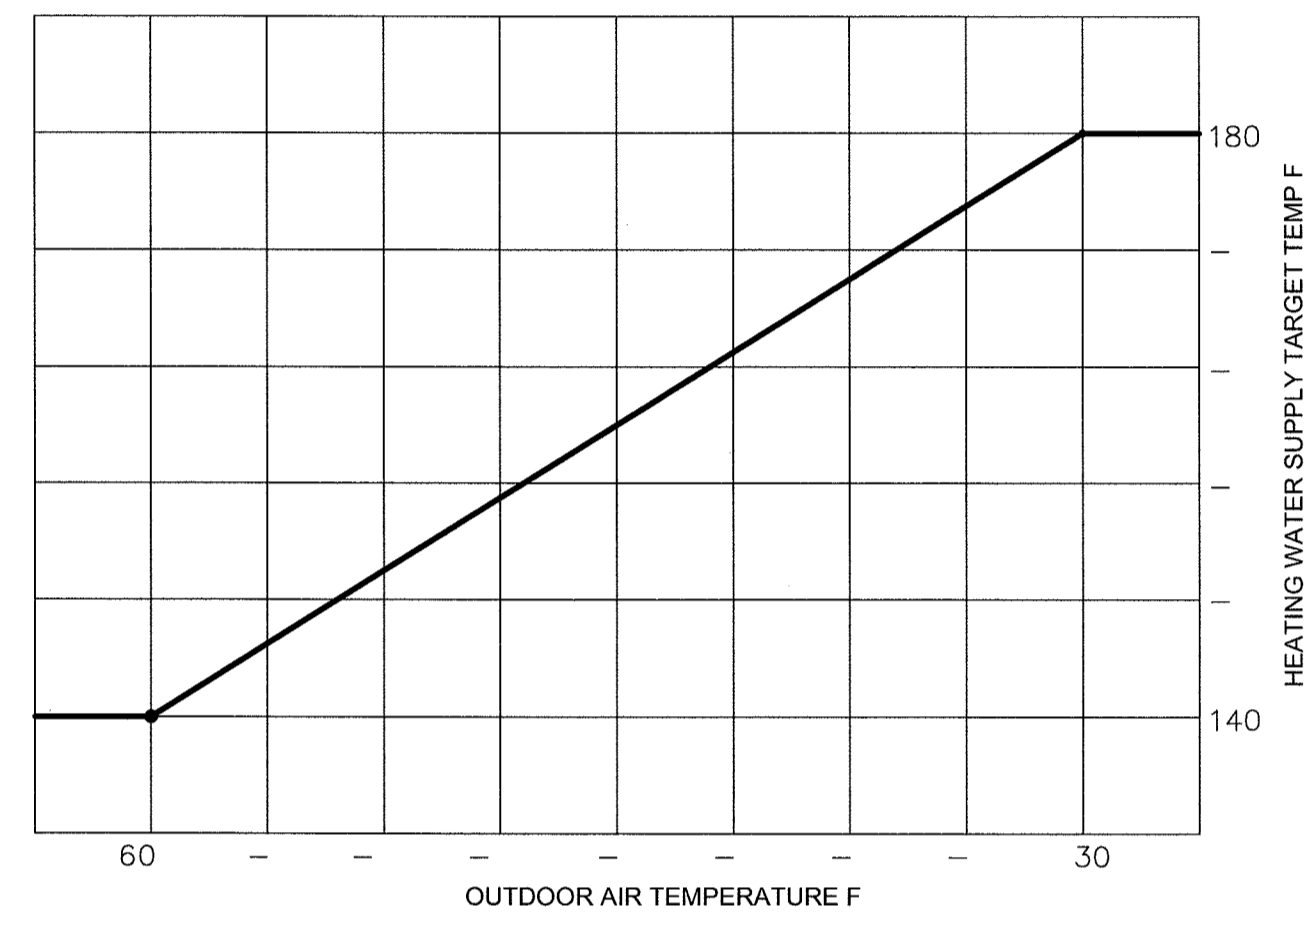


- *NOTES:**
- EXISTING VAV-SD DDC CONTROLLER TO BE REMOVED AND RE-INSTALLED ON NEW VAV TERMINAL UNIT.
 - EXISTING ROOM SENSOR TO BE RE-USED.
 - NEW HEATING WATER VALVE TO BE PROVIDED BY MECHANICAL CONTRACTOR AND INSTALLED BY MECHANICAL CONTRACTOR.
 - NEW DAMPER ACTUATOR TO BE PROVIDED AND INSTALLED BY CONTROL CONTRACTOR

CONTROLS SHALL BE ALERTON TO MATCH EXISTING CITY WIDE HVAC CONTROL SYSTEM BY BUILDING CONTROL SERVICES, INC. 8521 WHITE FIR ST., SUITE C1A RENO, NV 89523 PH#: (775) 826-8998 FAX#: (775) 826-3524 *NO EXCEPTIONS*

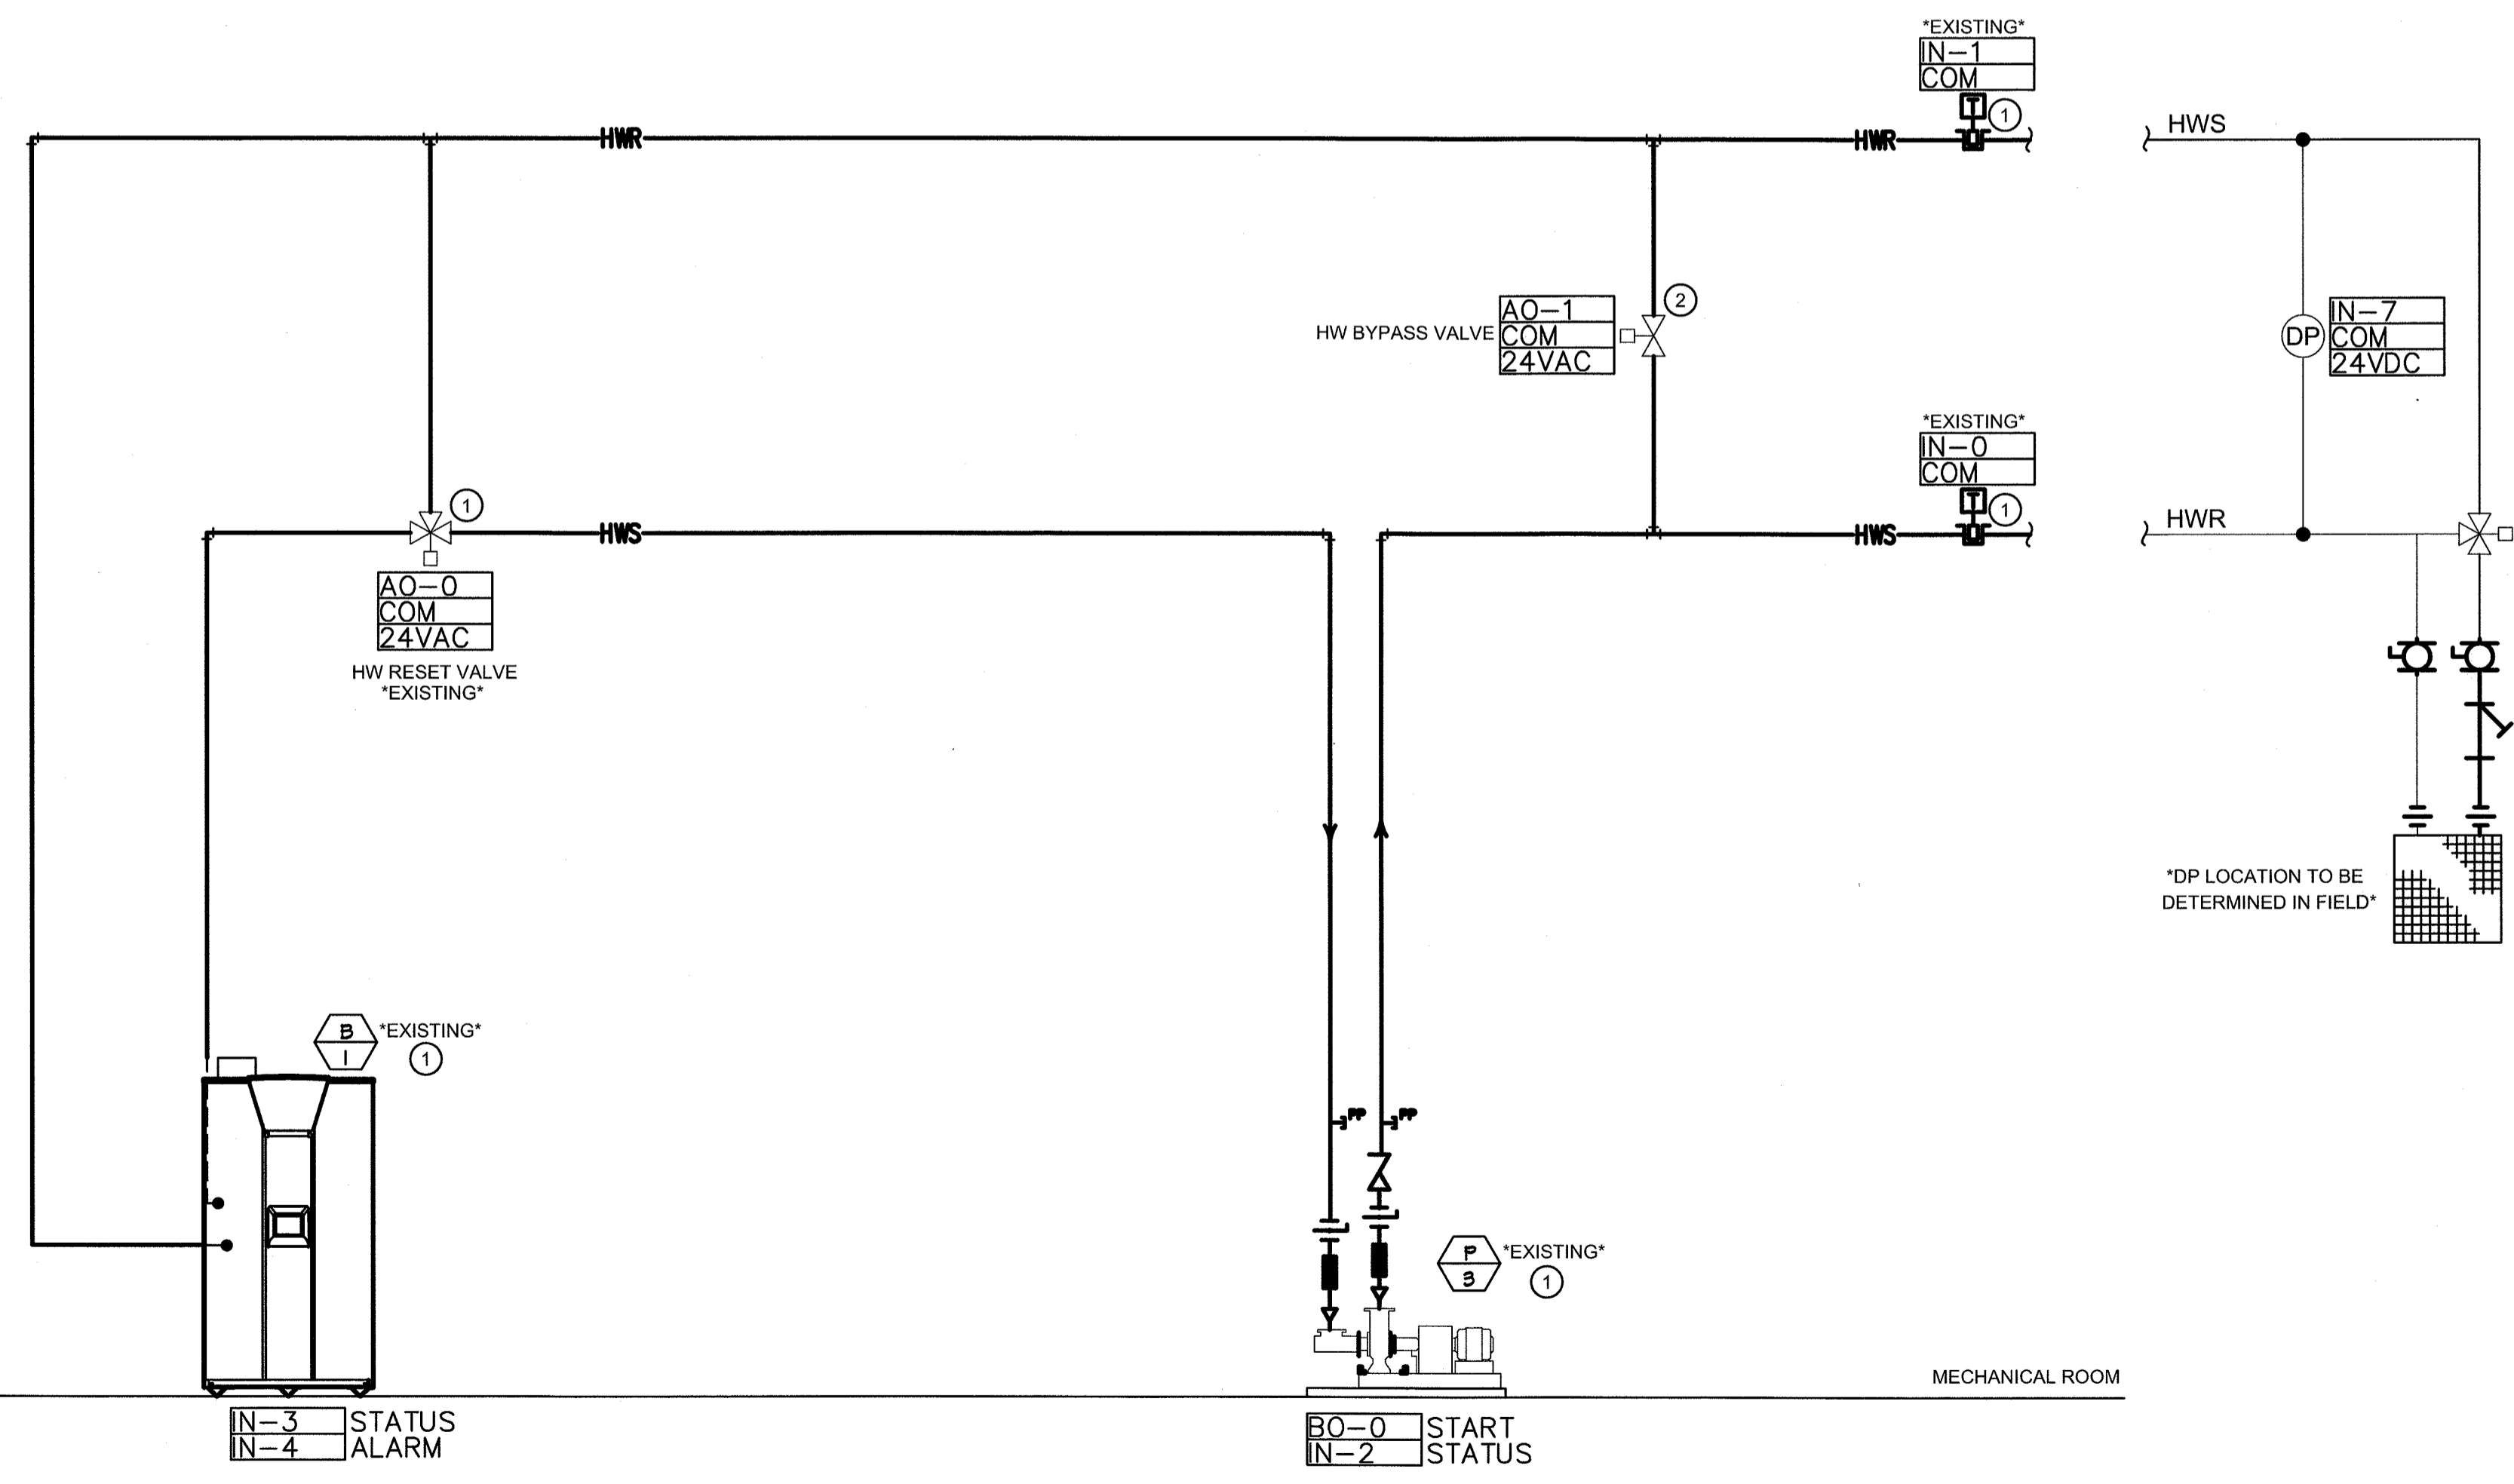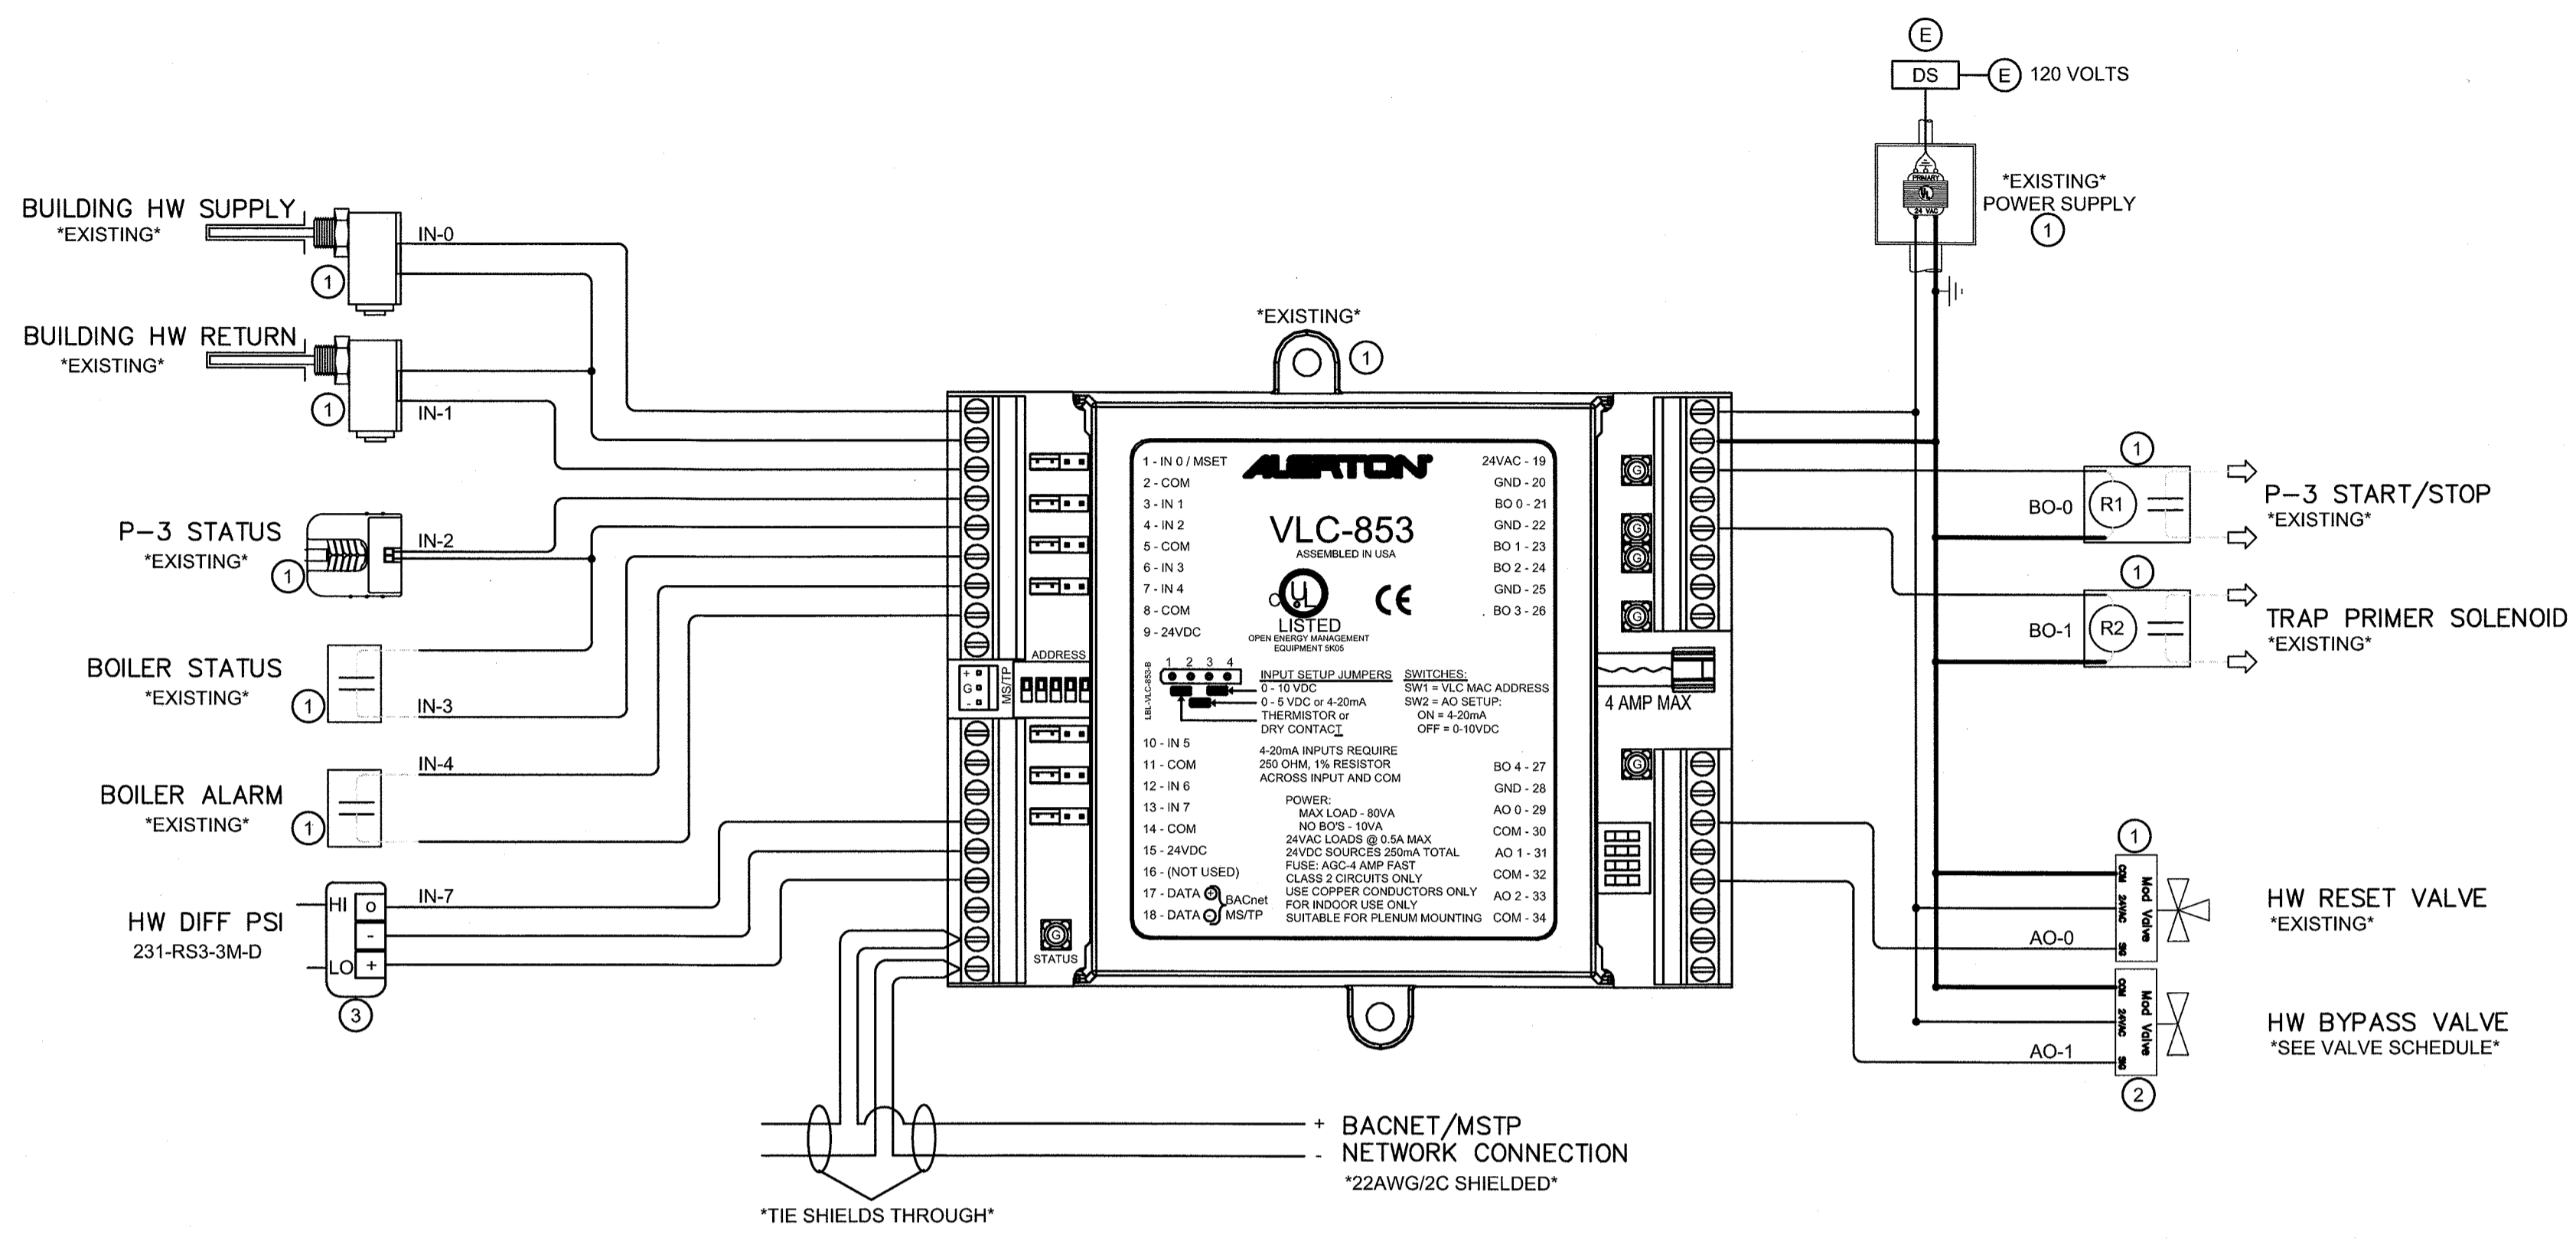

M5.2 MECHANICAL CONTROLS (2)
 SCALE: NONE

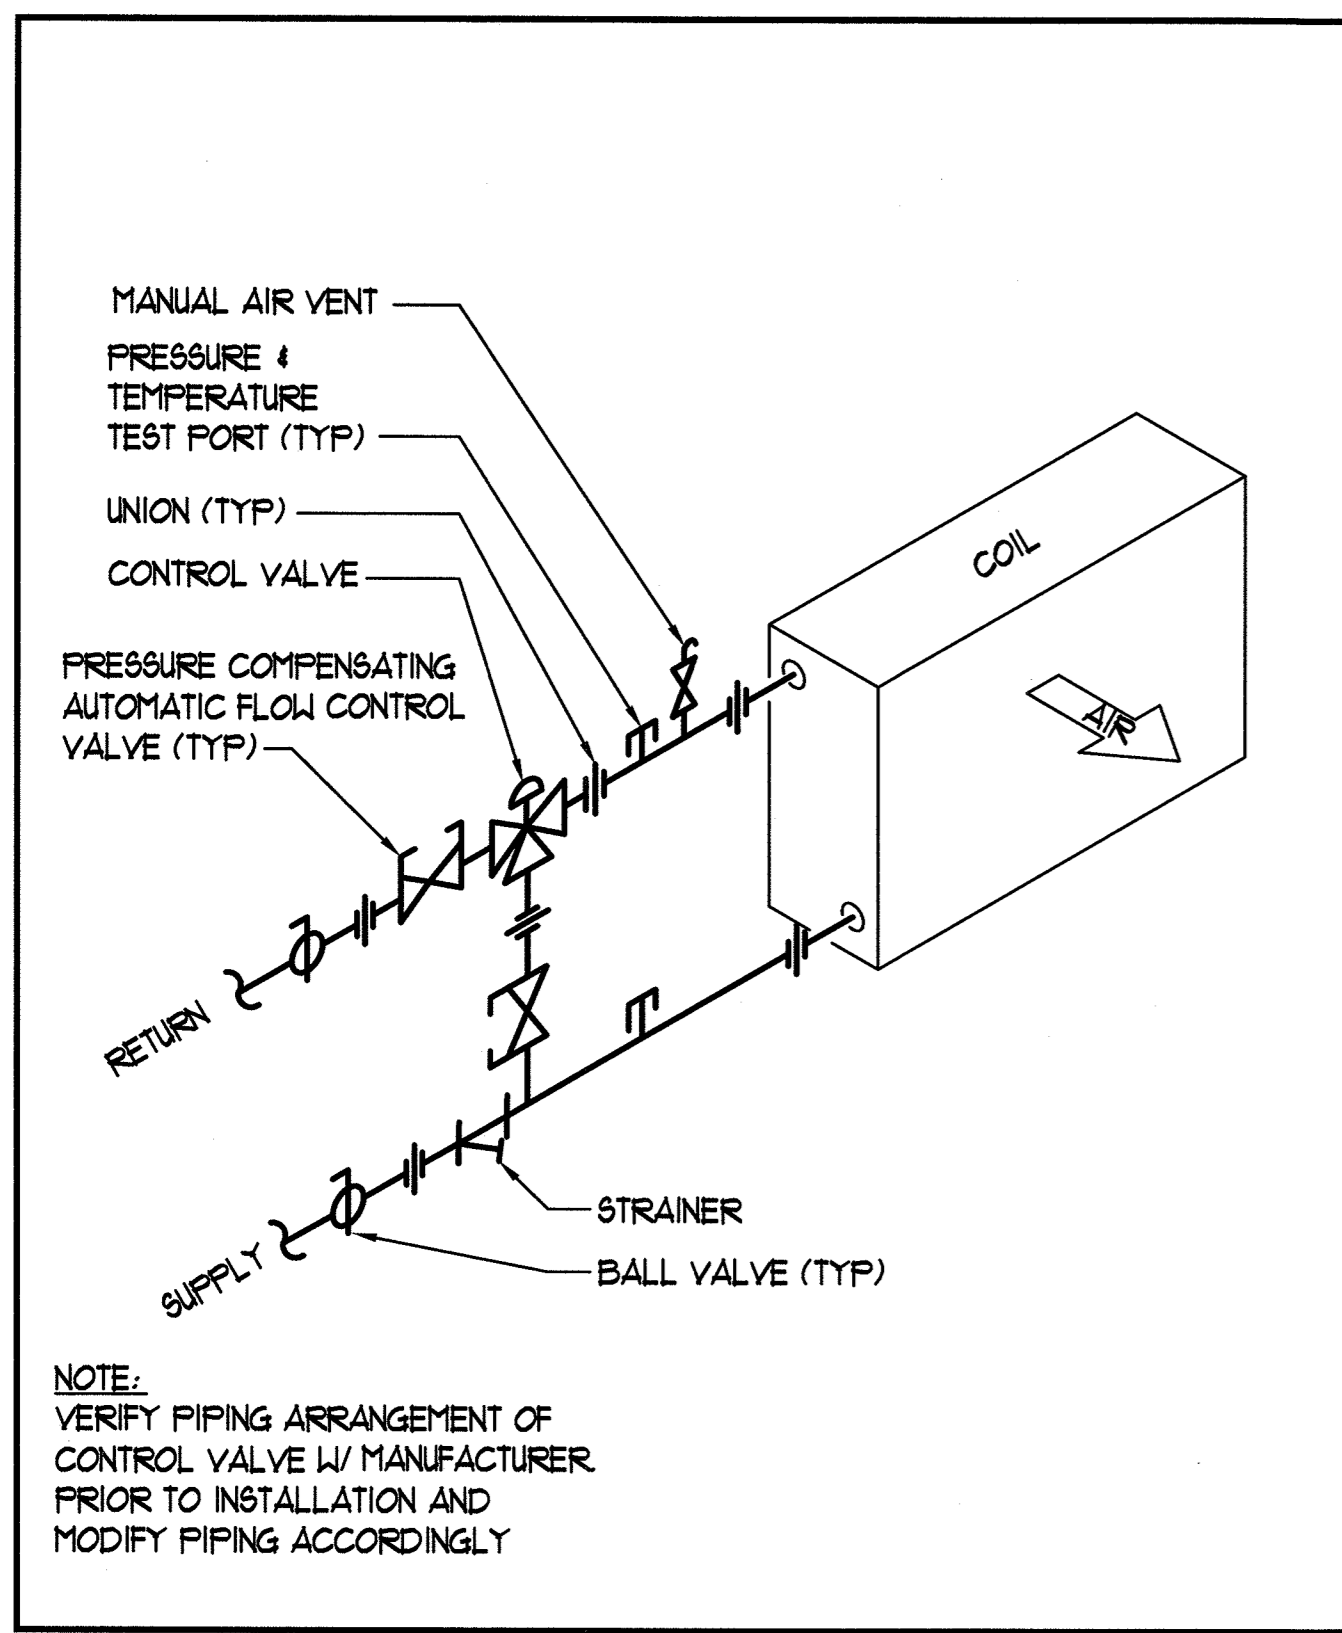


1 3 WAY HOT WATER COIL PIPING
M6.1 SCALE: NONE

APPROVED		UNACCEPTABLE	
ROUND Y-FITTING	RECTANGULAR Y-FITTING	BULLHEAD TEE	CUSHION HEAD
ROUND LATERAL TAP	ROUND W/ CONICAL TAP	ROUND TAP W/O FITTING	
RECT. TAP W/ HEEL FITTING	ROUND TAP W/ HEEL FITTING	RECT. TAP W/O FITTING	ROUND TAP W/O FITTING
LONG RADIUS 90° ELBOW	LONG RADIUS 45° ELBOW	SQUARE TO ROUND W/O TRANSITION	RECT. MITERED ELBOW W/O TURNING VANES
		NOTE: APPROVED FITTINGS ARE NOT INTERCHANGEABLE. SEE PLANS FOR DUCT LAYOUT AND PREFERRED FITTING.	
SQUARE TO ROUND TRANSITION	RECT. MITERED ELBOW W/ TURNING VANES		
SHORT RADIUS 90° ELBOW	SHORT RADIUS 45° ELBOW		


2 LOW PRESSURE DUCT FITTINGS DETAIL
M6.1 SCALE: NONE

APPROVED		UNACCEPTABLE	
ROUND Y-FITTING	RECTANGULAR Y-FITTING	BULLHEAD TEE	CUSHION HEAD
ROUND LATERAL TAP	ROUND W/ CONICAL TAP	ROUND TAP W/O FITTING	
RECT. TAP W/ HEEL FITTING	ROUND TAP W/ HEEL FITTING	RECT. TAP W/O FITTING	ROUND TAP W/O FITTING
LONG RADIUS 90° ELBOW	LONG RADIUS 45° ELBOW	SHORT RADIUS 90° ELBOW	SHORT RADIUS 45° ELBOW
SQUARE TO ROUND TRANSITION	RECT. MITERED ELBOW W/ TURNING VANES	SQUARE TO ROUND W/O TRANSITION	RECT. MITERED ELBOW W/O TURNING VANES


3 MEDIUM PRESSURE DUCT FITTINGS DETAIL
M6.1 SCALE: NONE

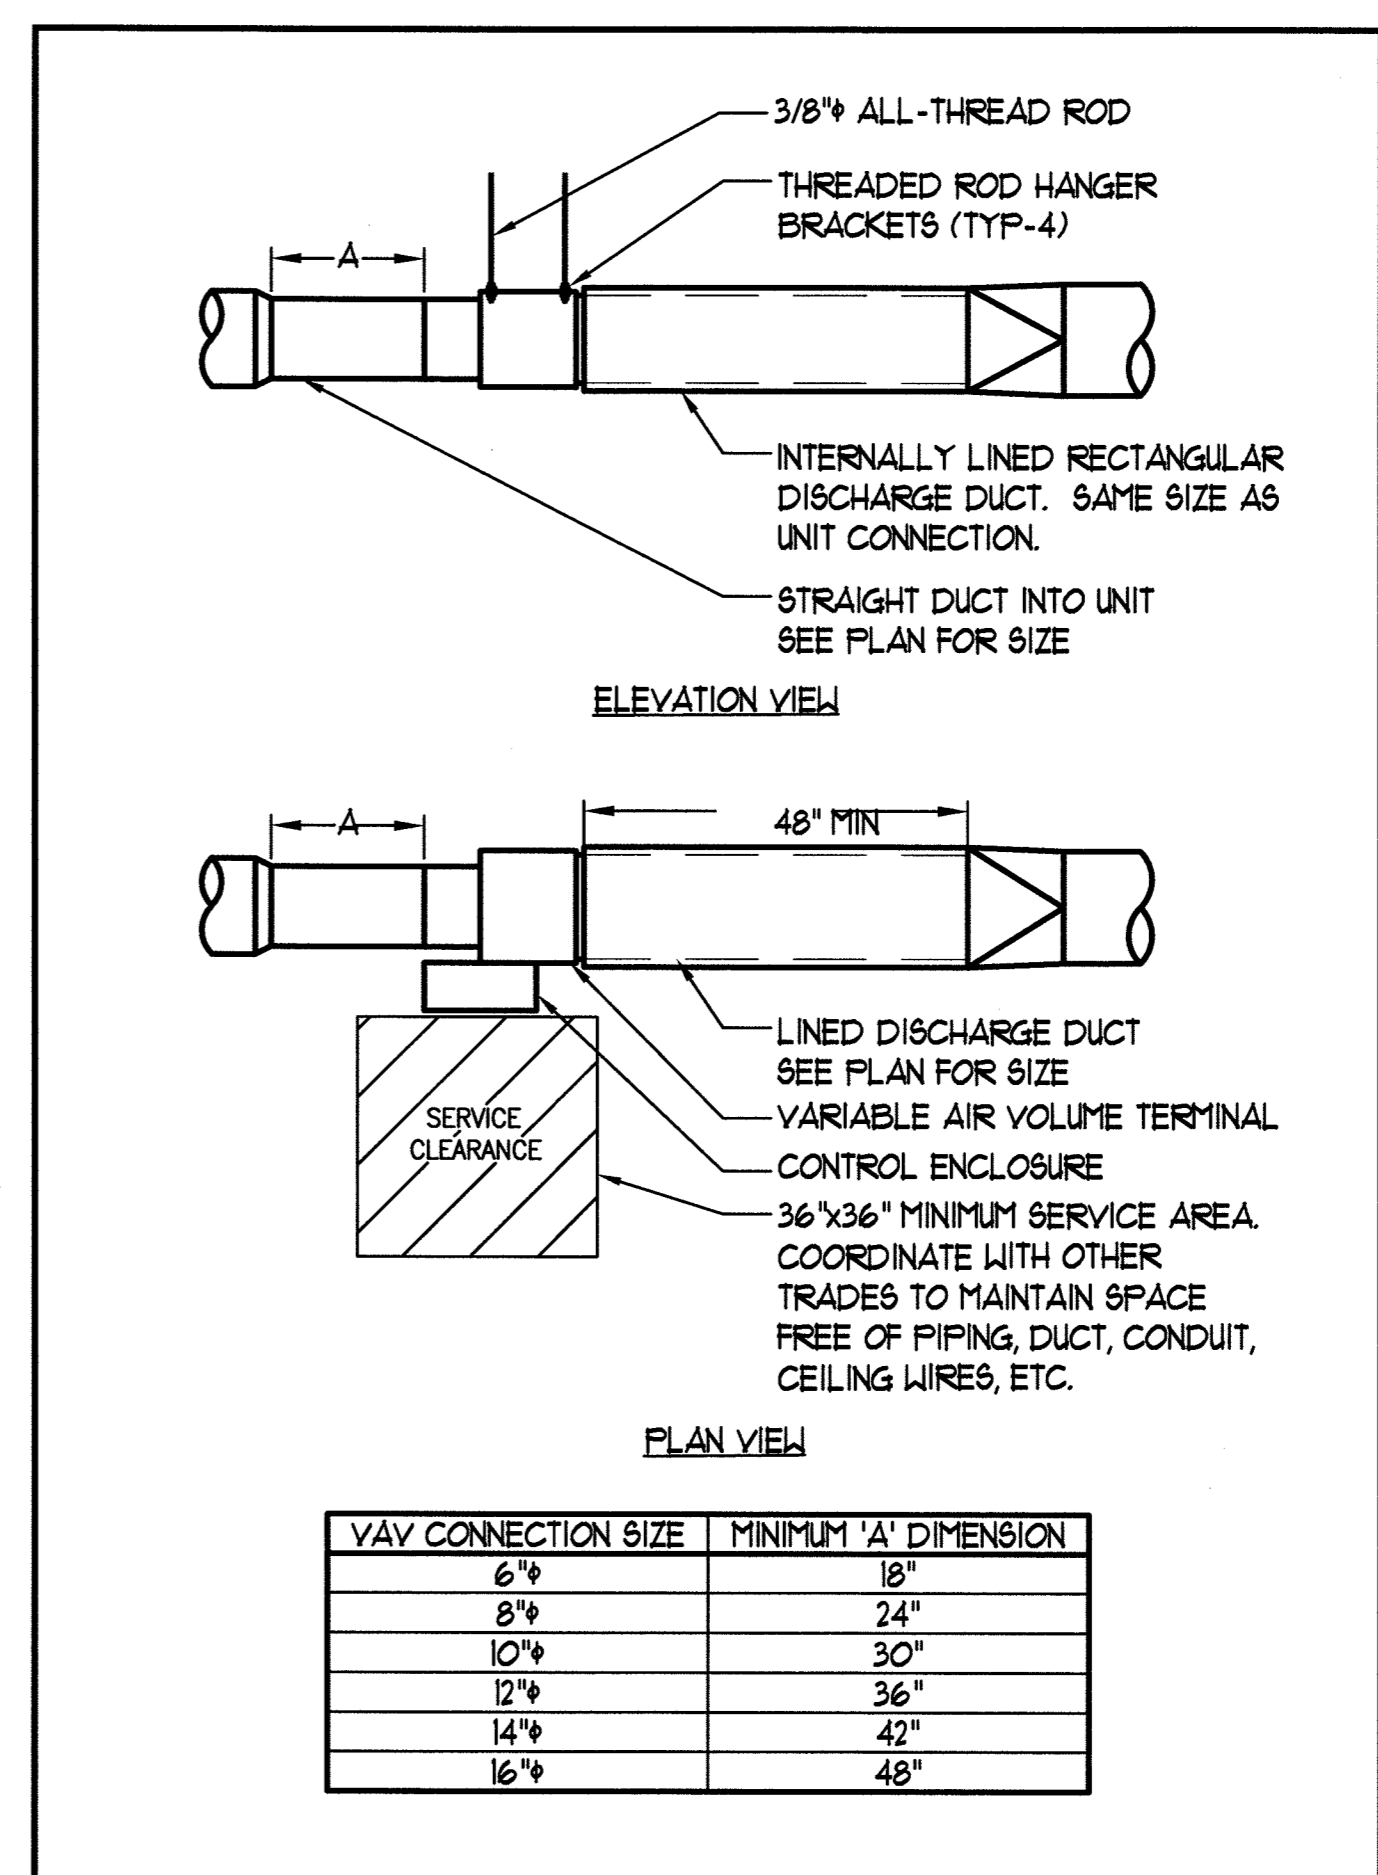


4 VAV TERMINAL DETAIL
M6.1 SCALE: NONE

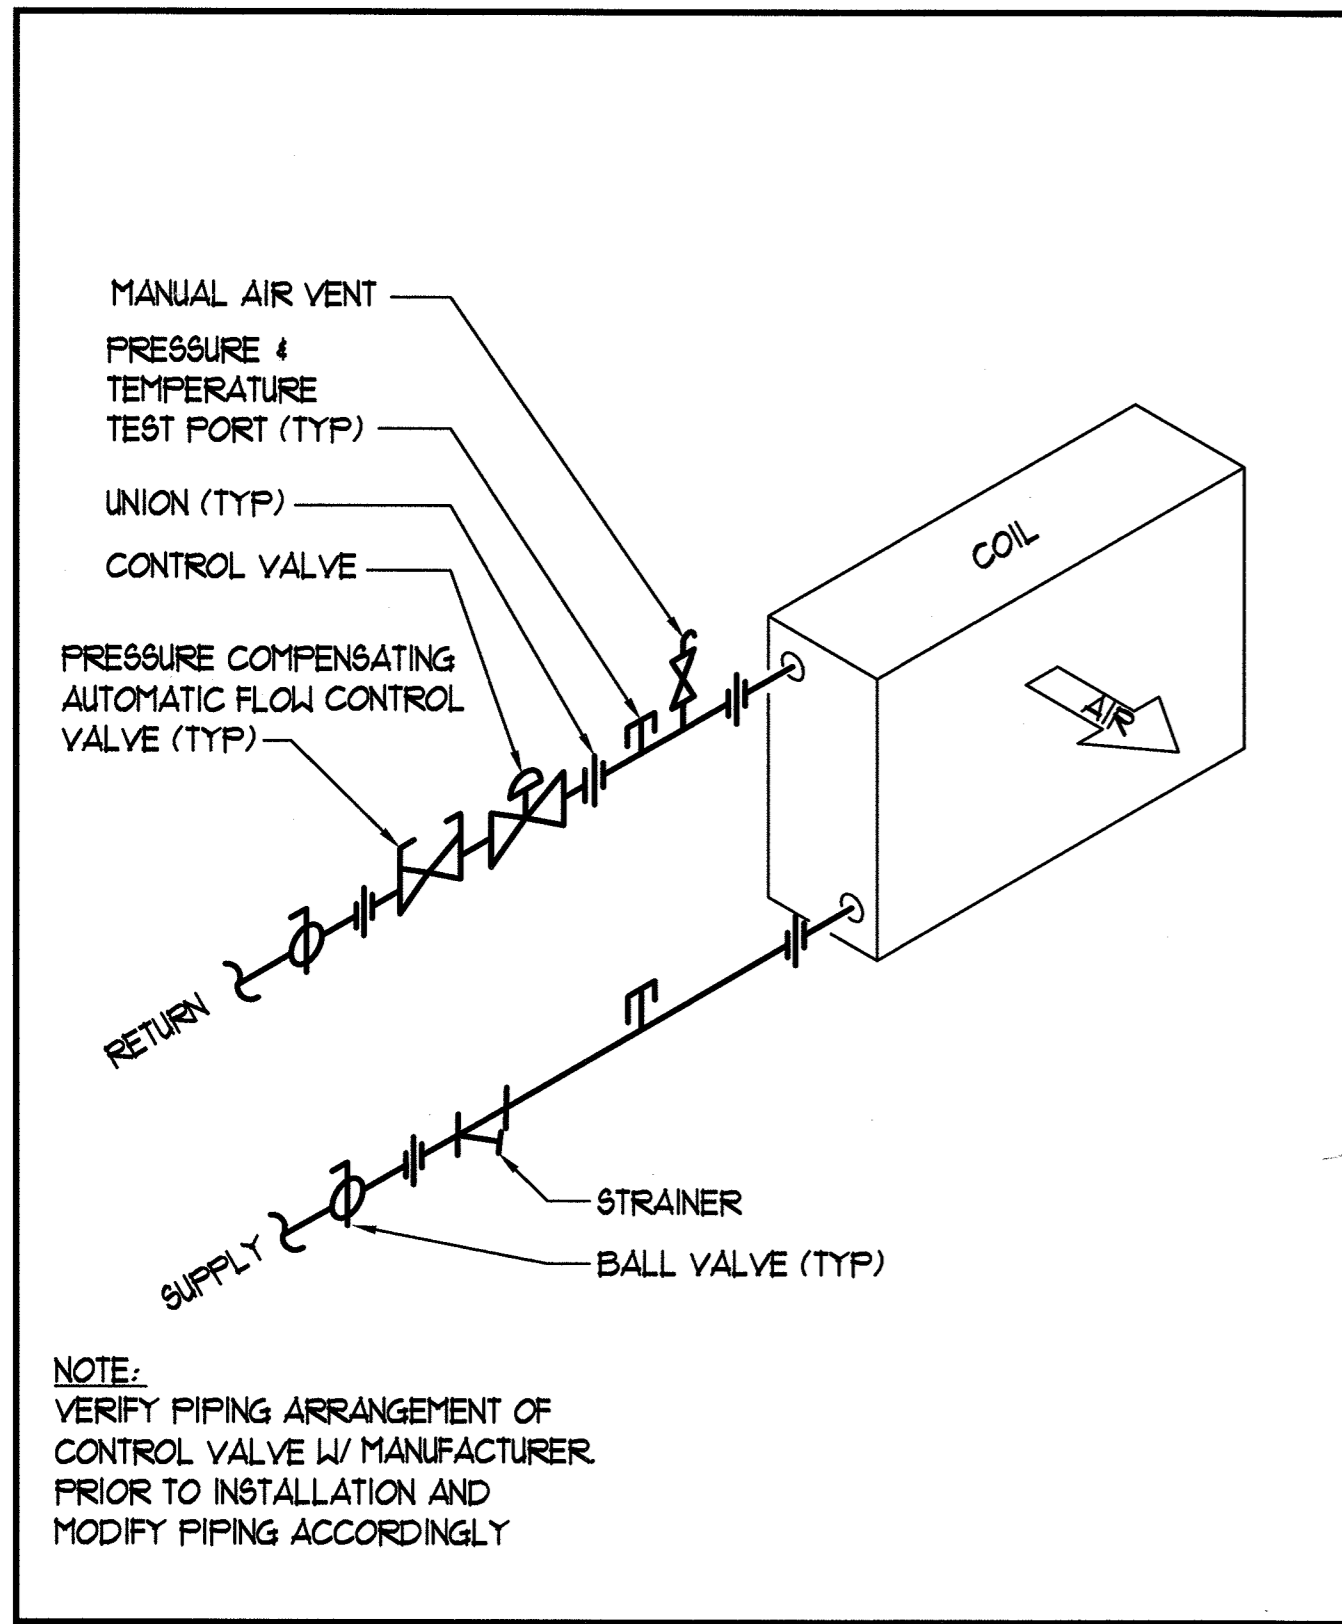


5 2 WAY HOT WATER COIL PIPING
M6.1 SCALE: NONE

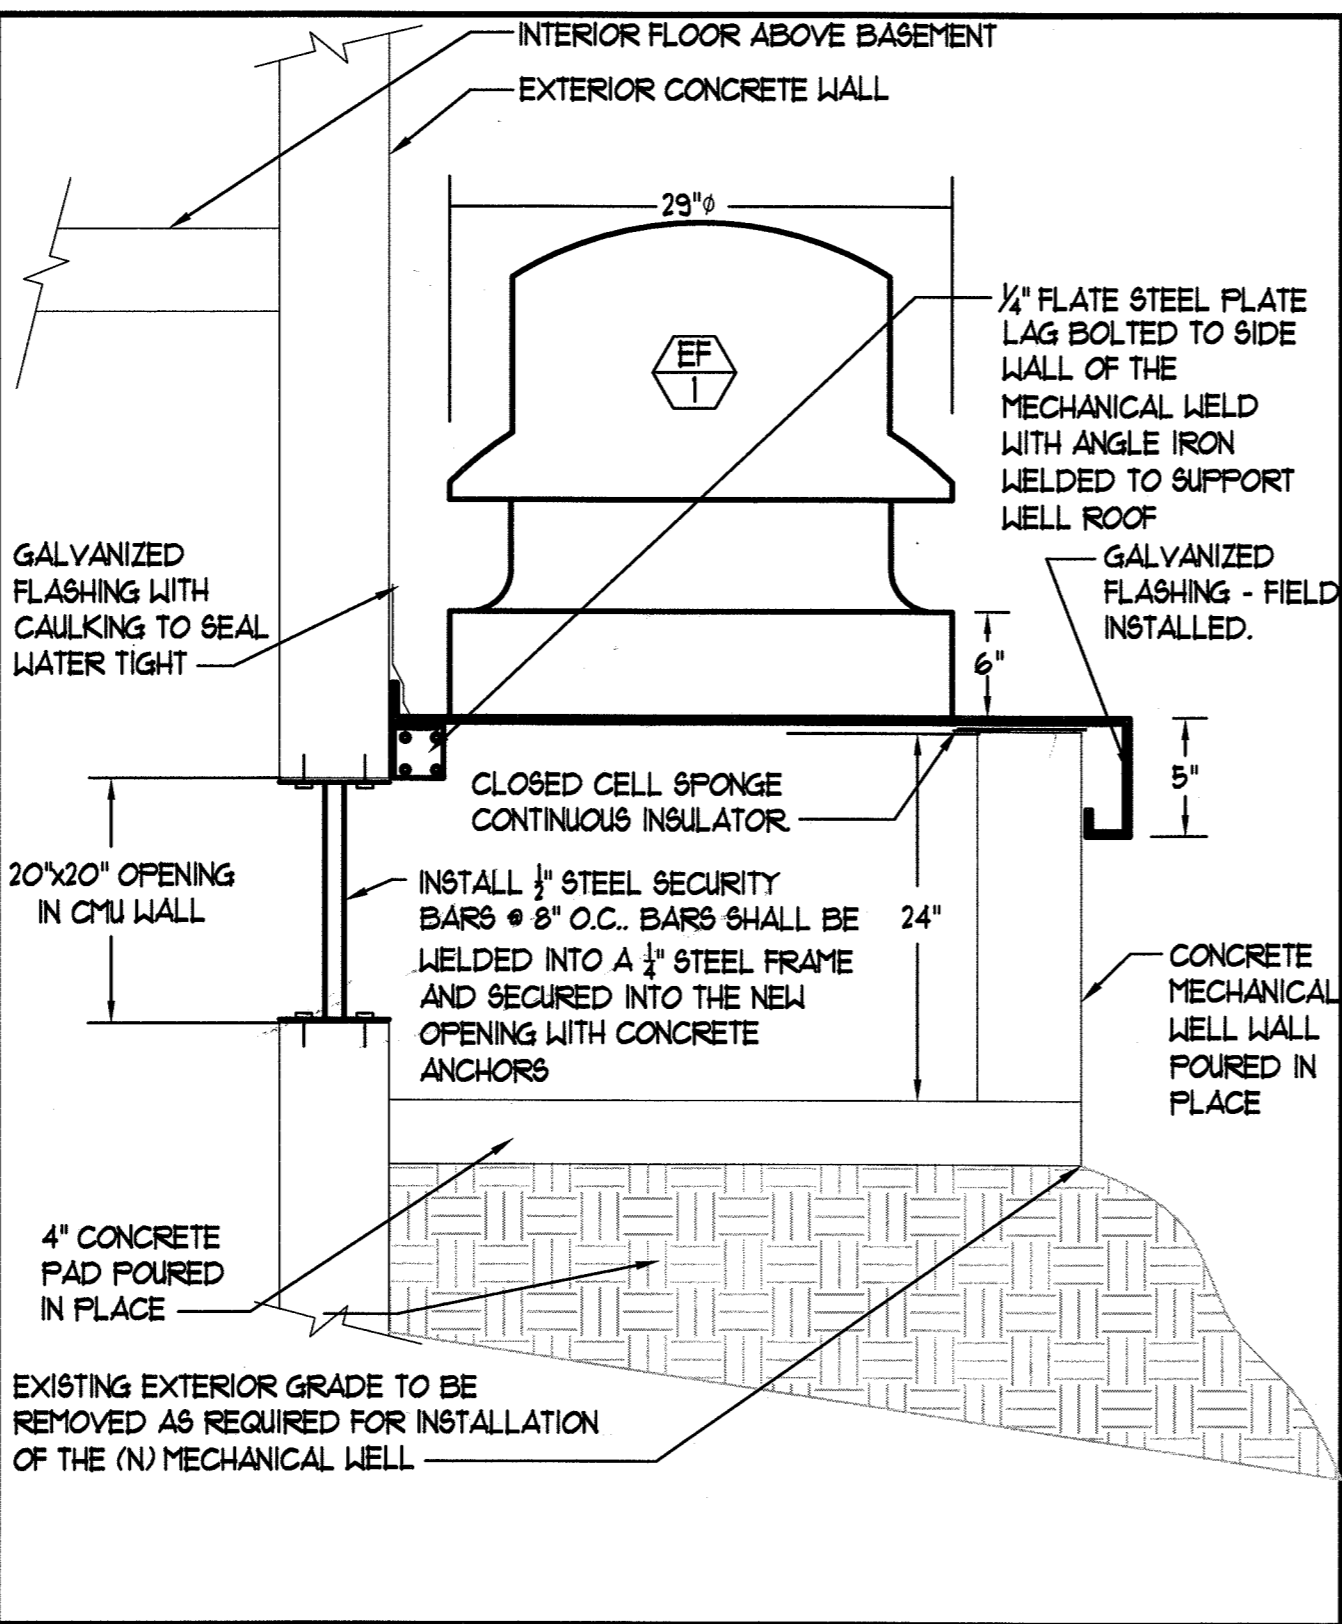

6 EVIDENCE ROOM EXHAUST FAN
M6.1 SCALE: NONE

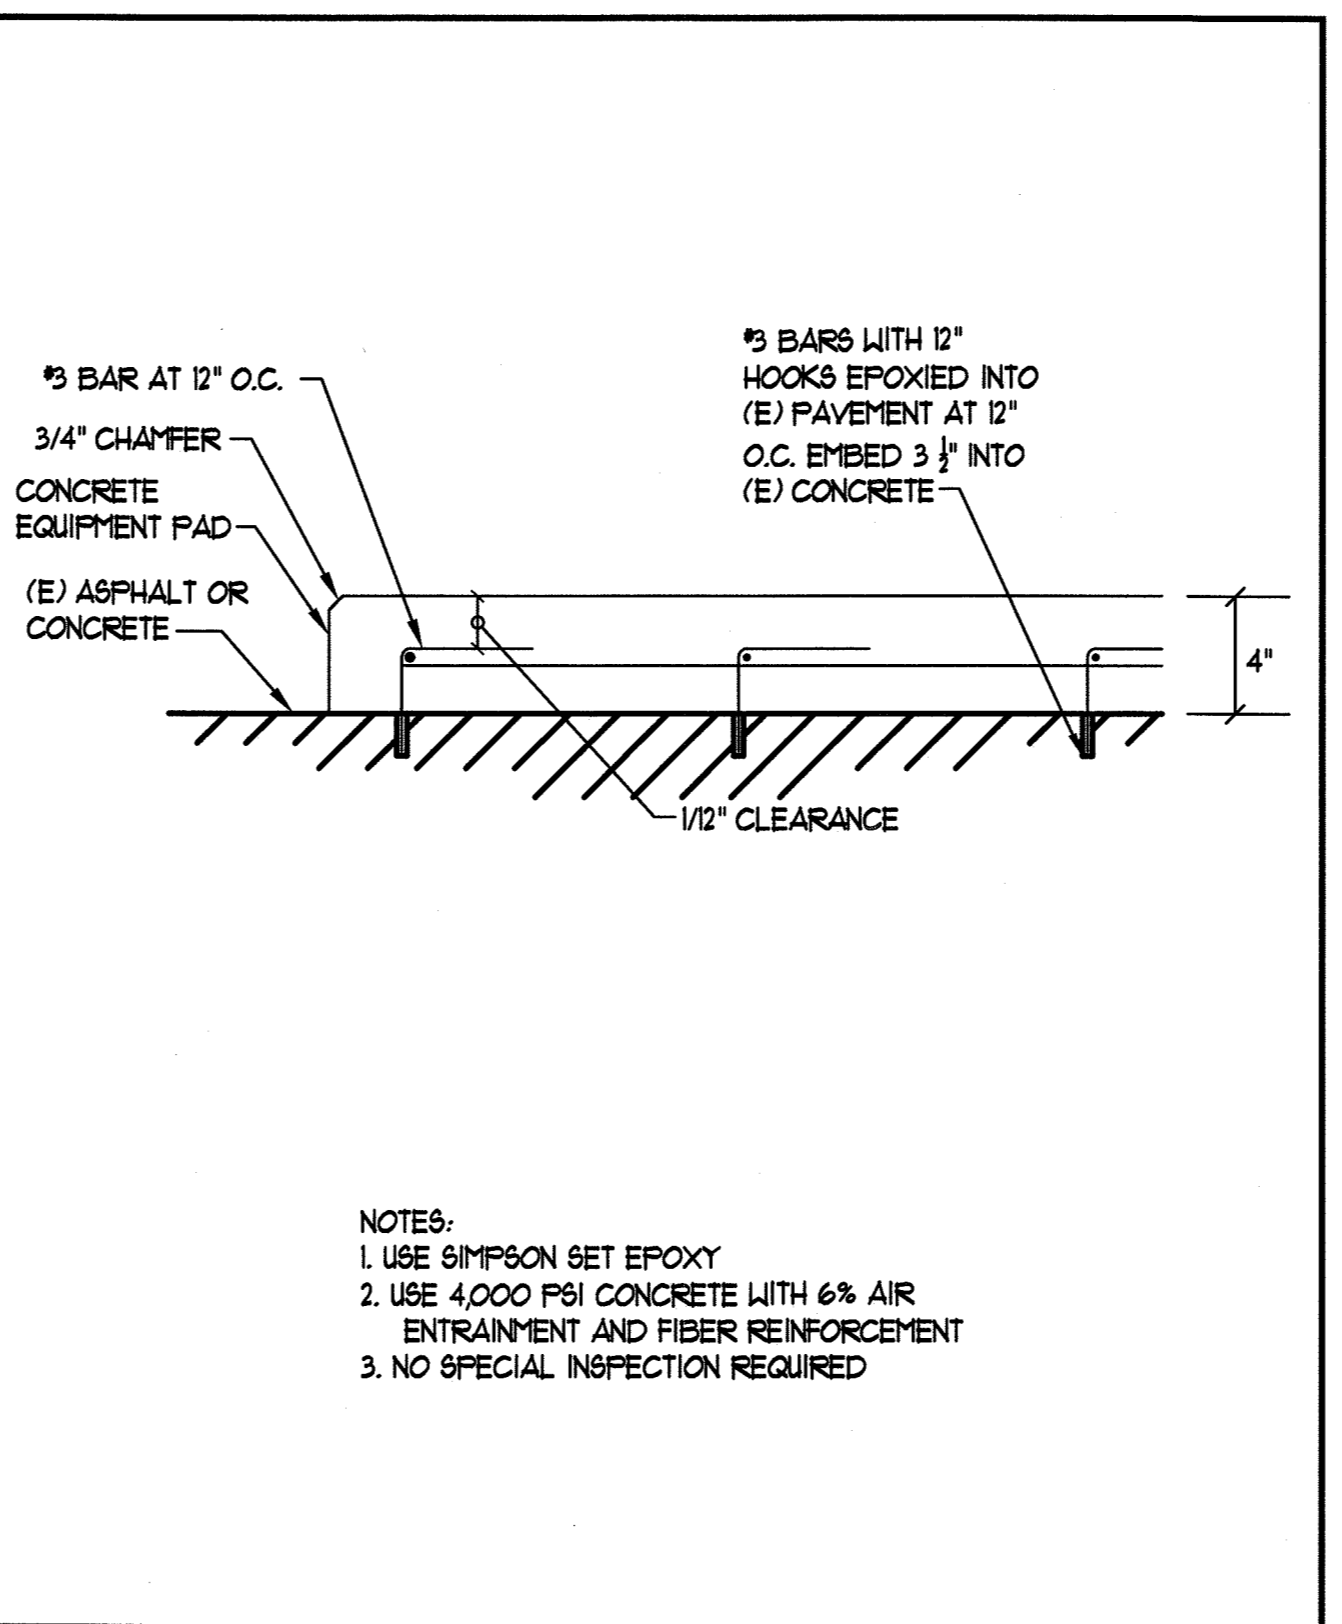

7 CONCRETE EQUIPMENT PAD DETAIL
M6.1 SCALE: NONE

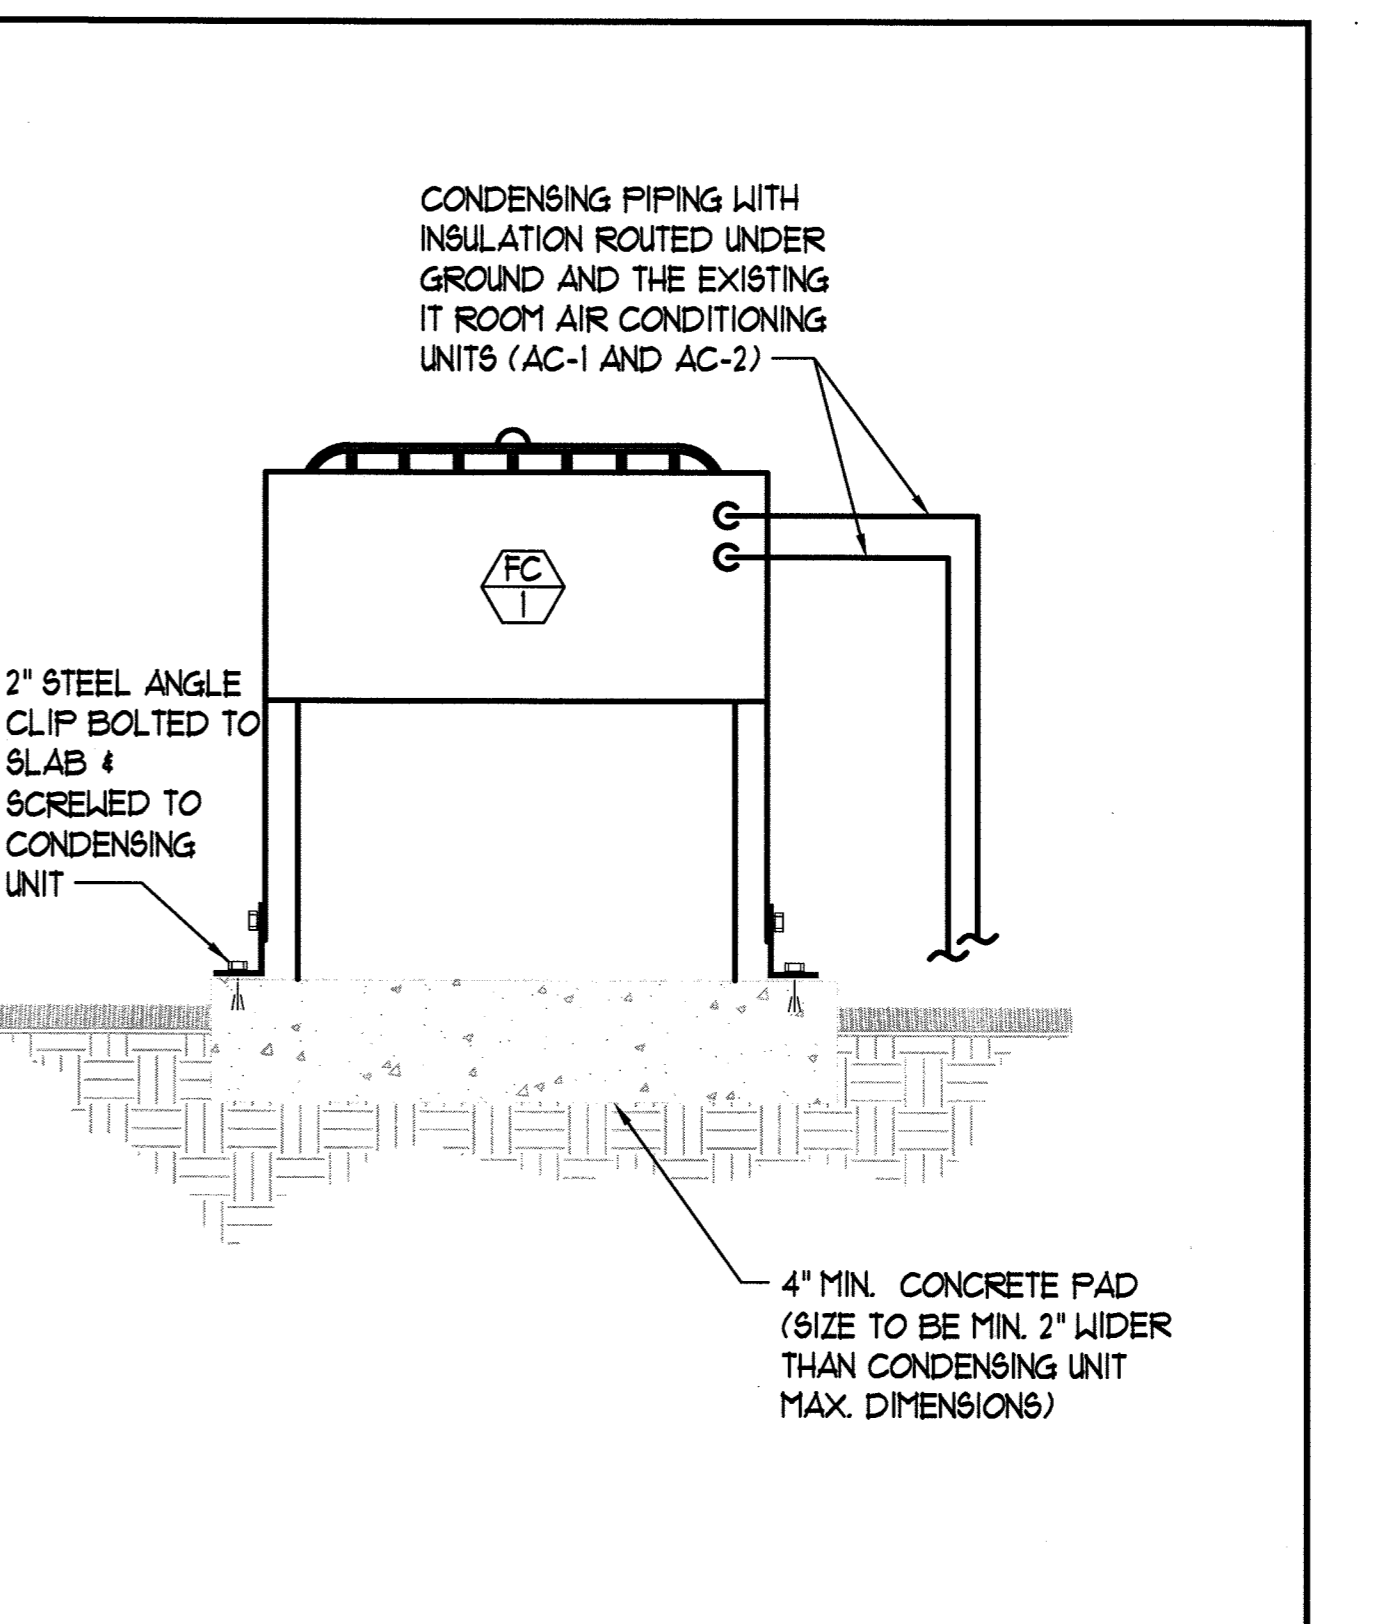

8 IT ROOM FLUID COOLER DETAIL
M6.1 SCALE: NONE

MMI ENGINEERING
385 GENTRY WAY
RENO, NV. 89502
(775) 499-5784
WWW.MMI-ENGINEER.COM
MMI PROJECT #2016-19

SPARKS POLICE DEPARTMENT
HVAC UPGRADE PHASE 1
1701 EAST PRATER WAY
SPARKS, NEVADA 89434


SHEET TITLE
MECHANICAL DETAILS

REVISIONS




BID DOCUMENTS


DATE: MARCH 26, 2018
SHEET NUMBER: MAR 28 2018
COMMUNITY SERVICES BUILDING DIVISION
M6.1

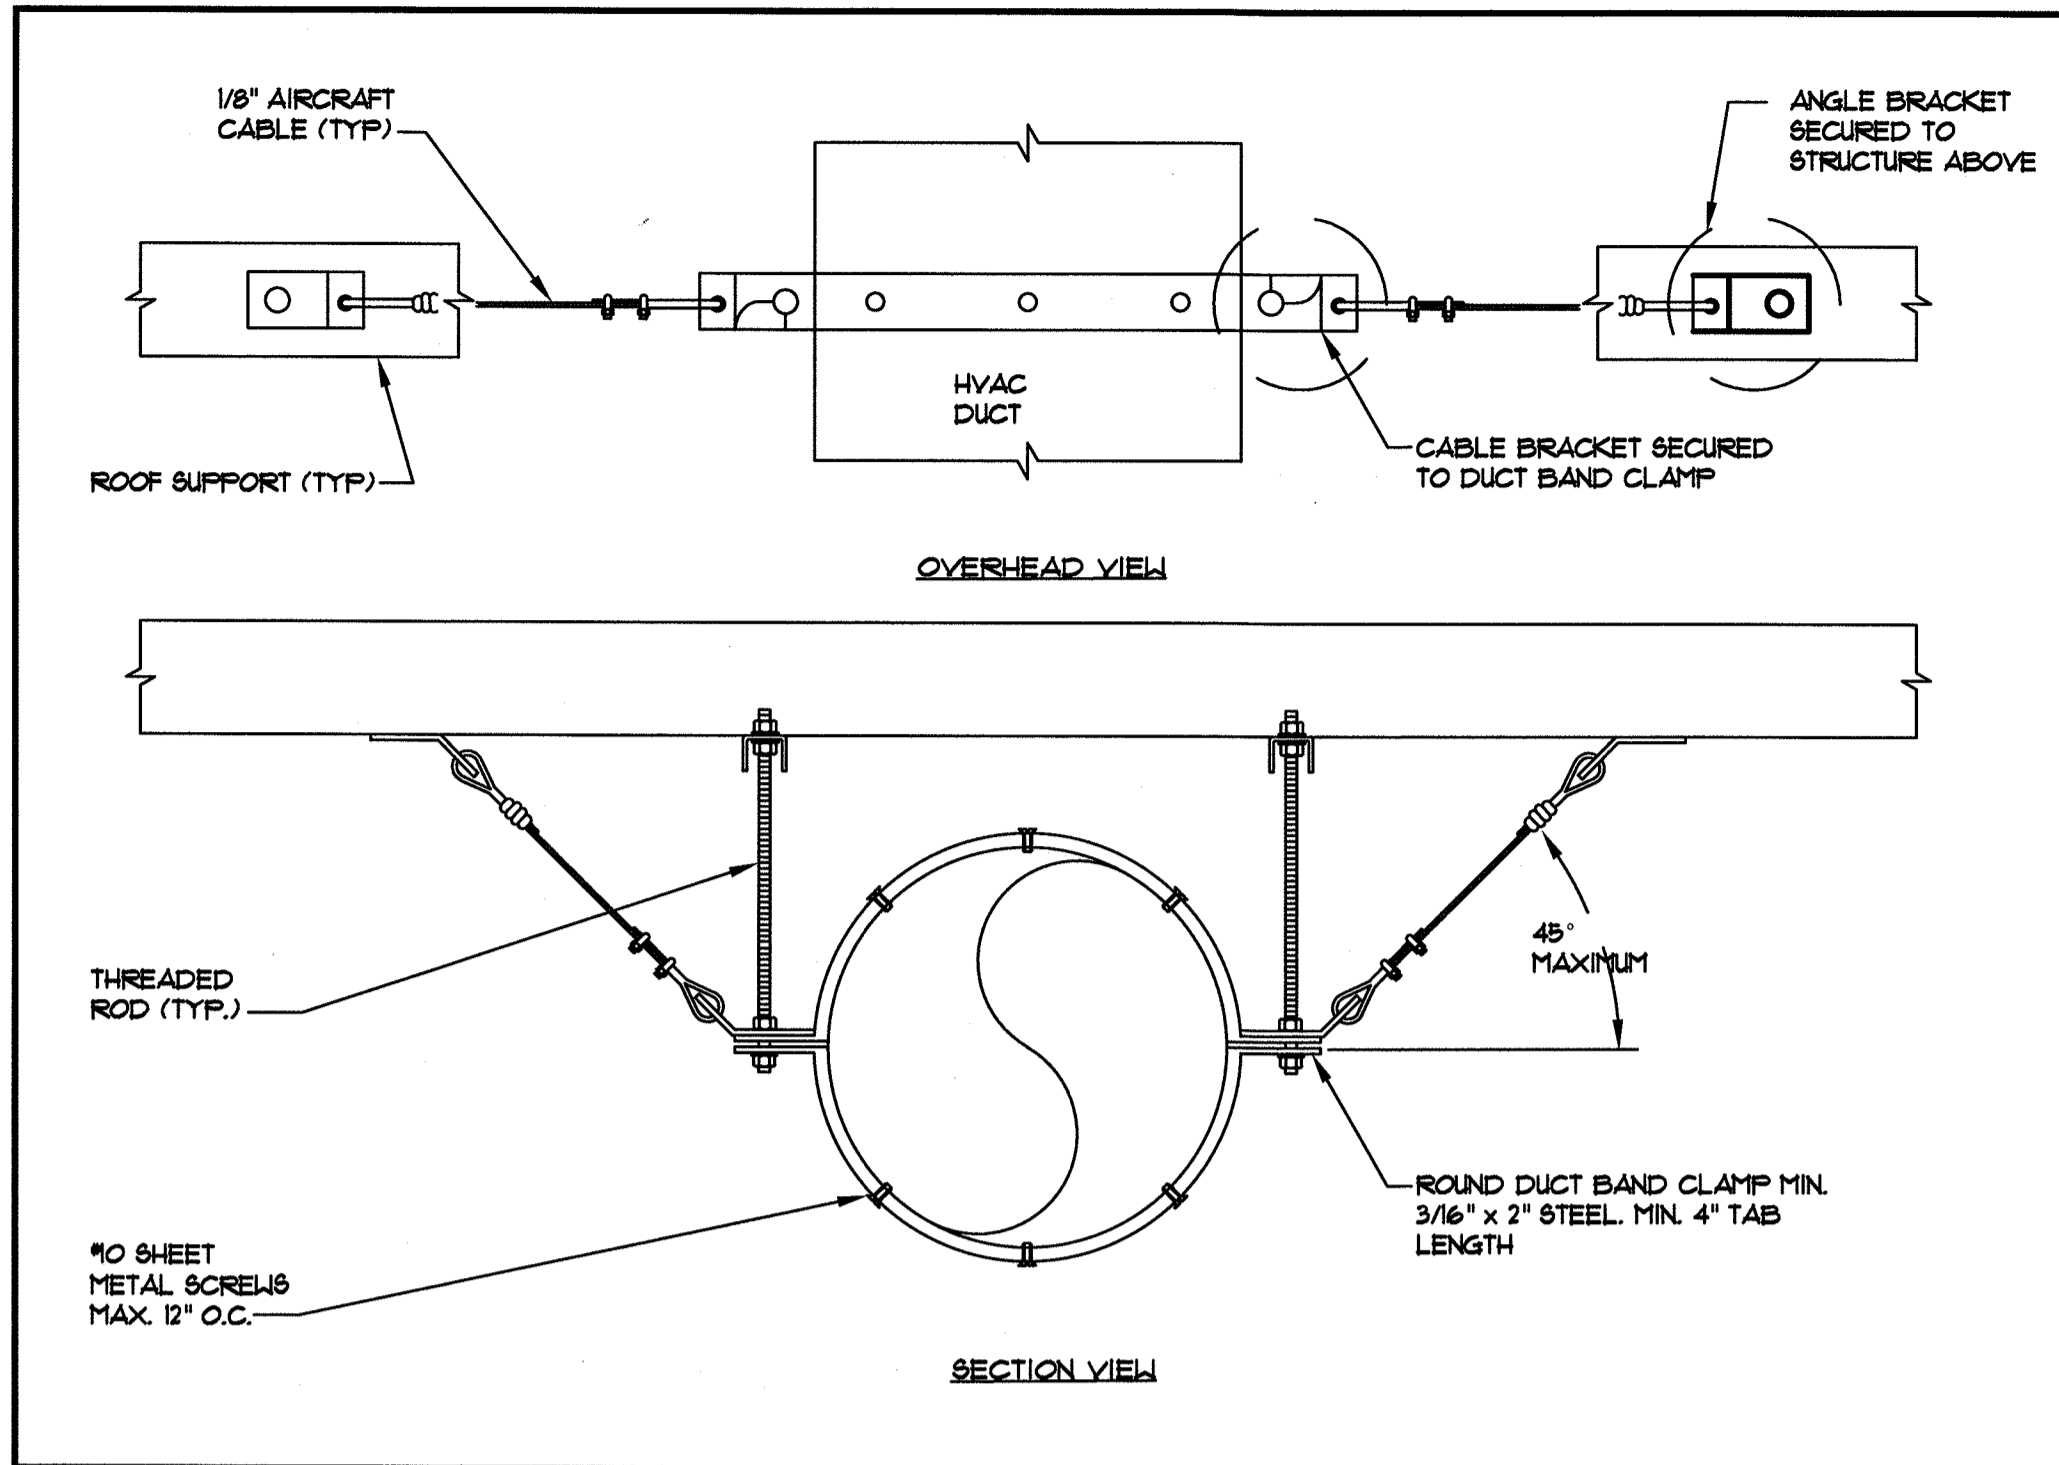


1 2-WAY TRANSFER CABLE DUCT BRACING DETAIL
M6.3 SCALE: NONE

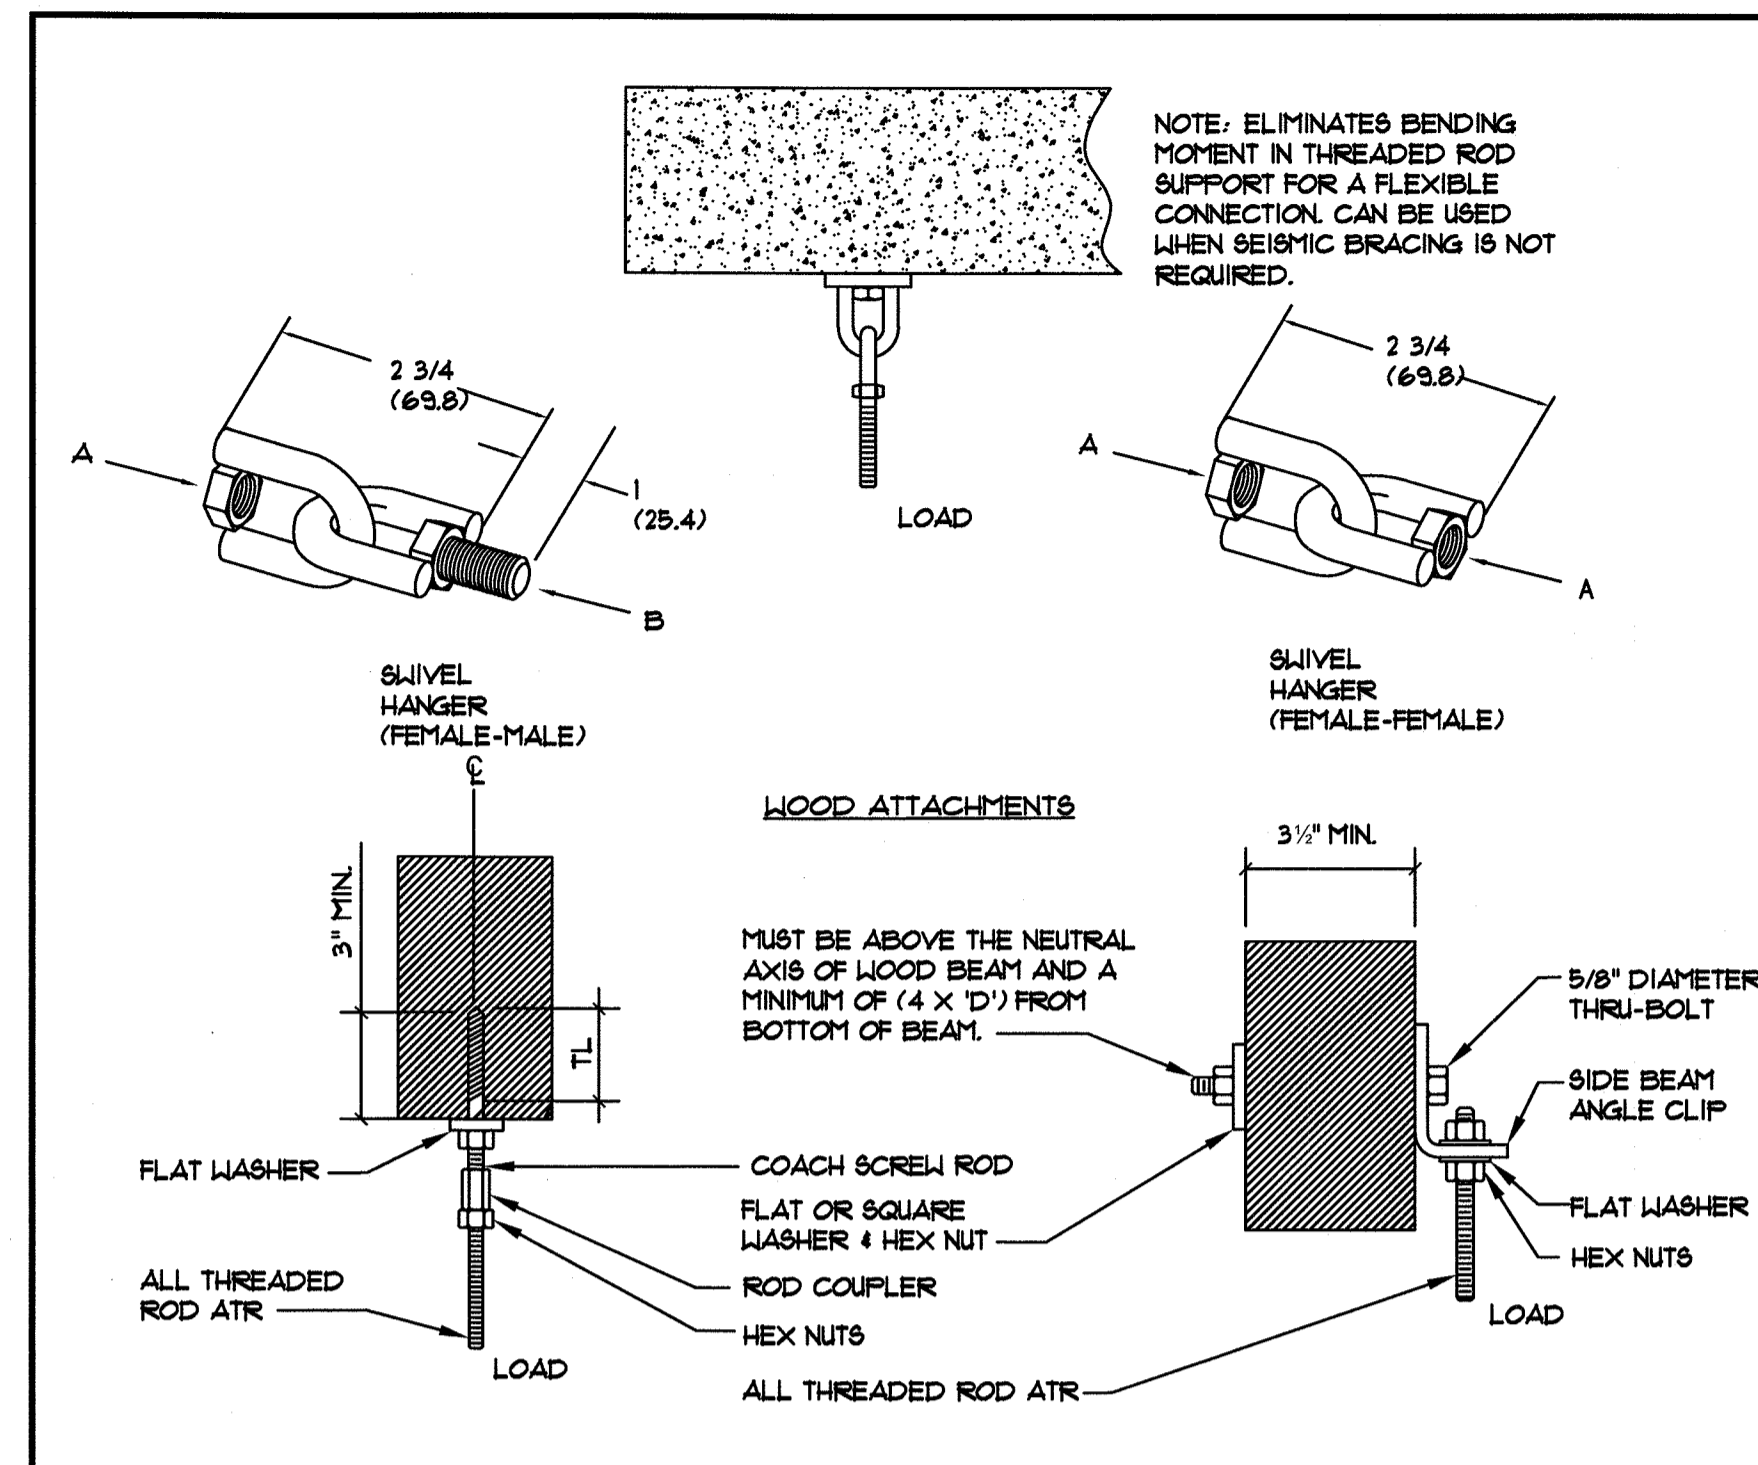


2 SEISMIC BRACING DETAIL
M6.3 SCALE: NONE

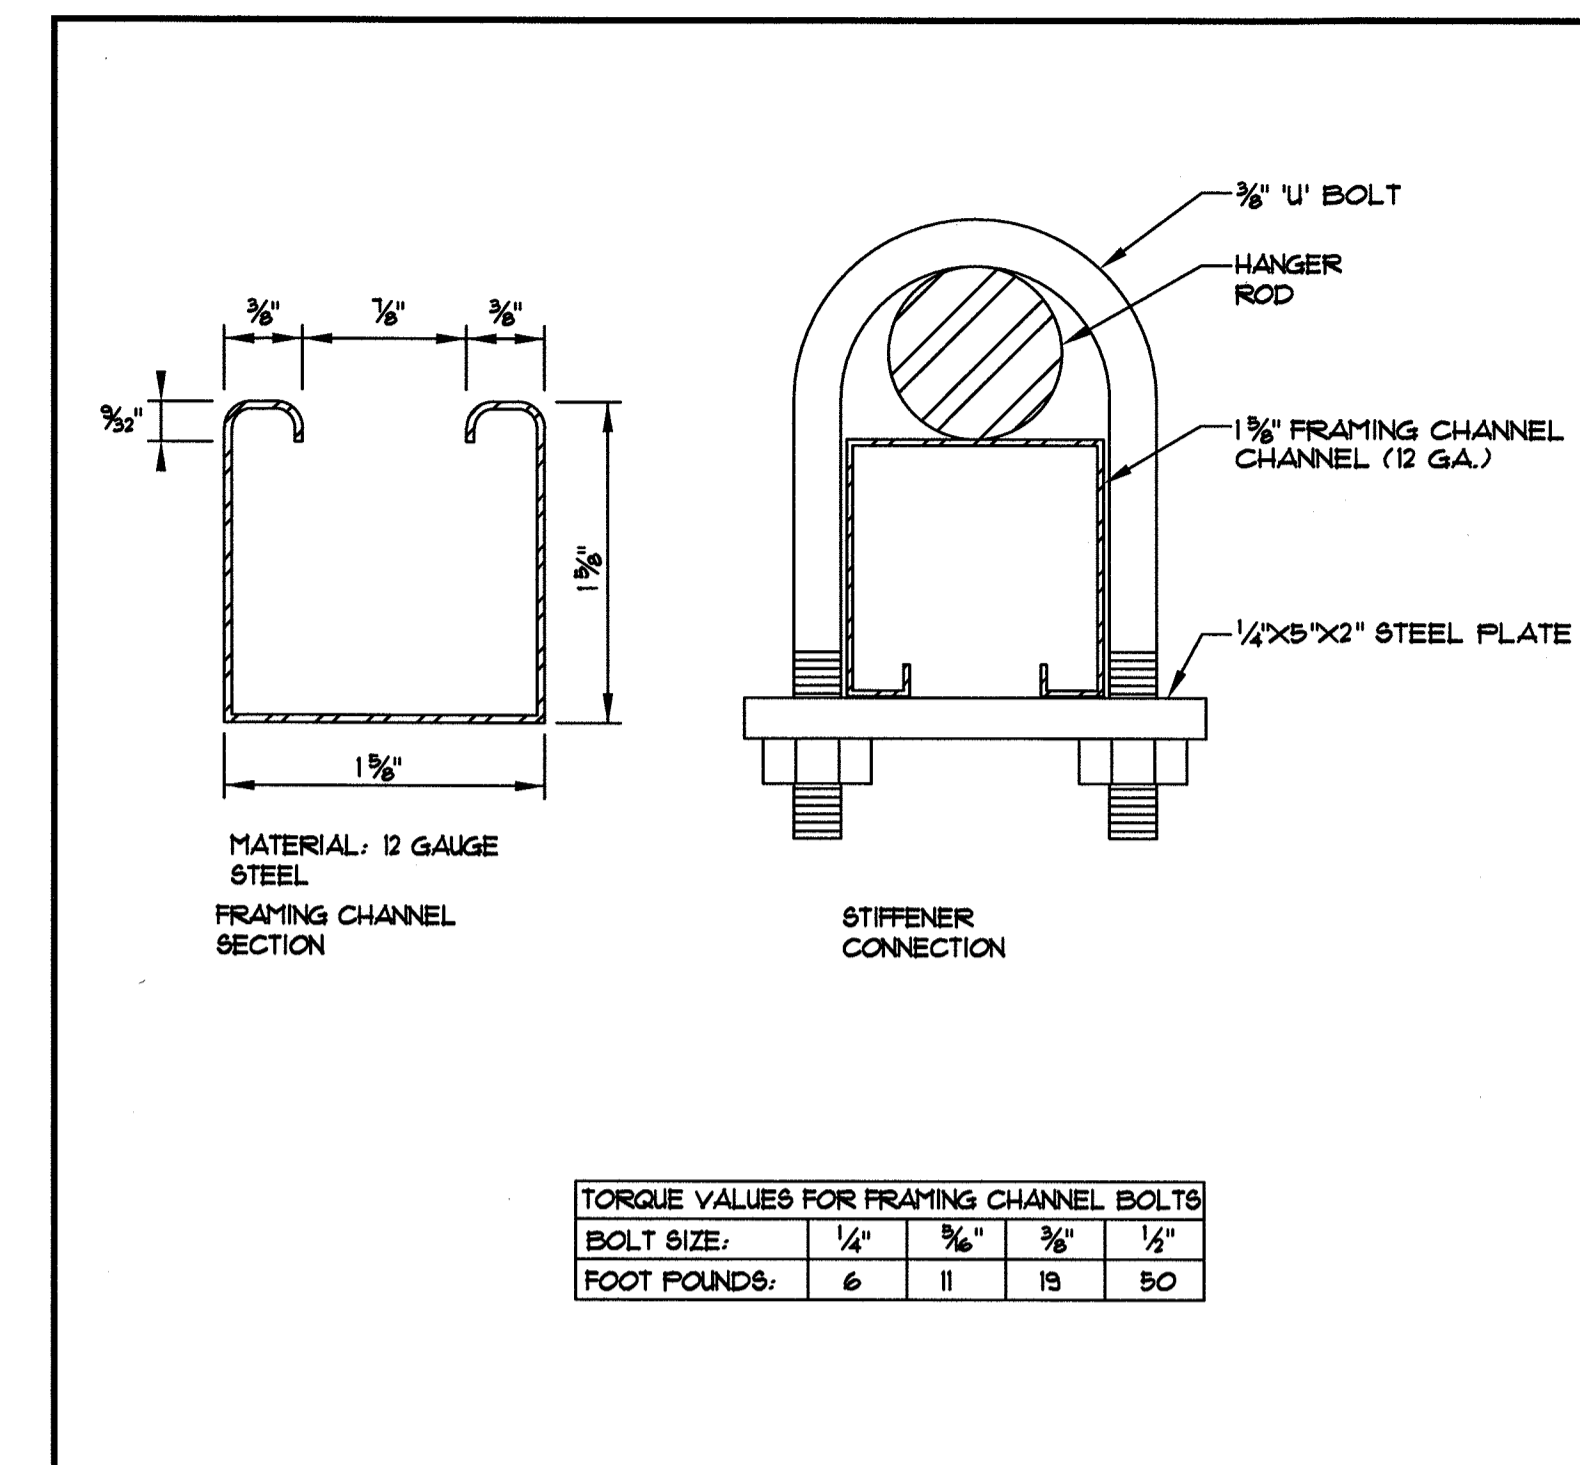


3 ROD STIFFENER DETAIL
M6.3 SCALE: NONE

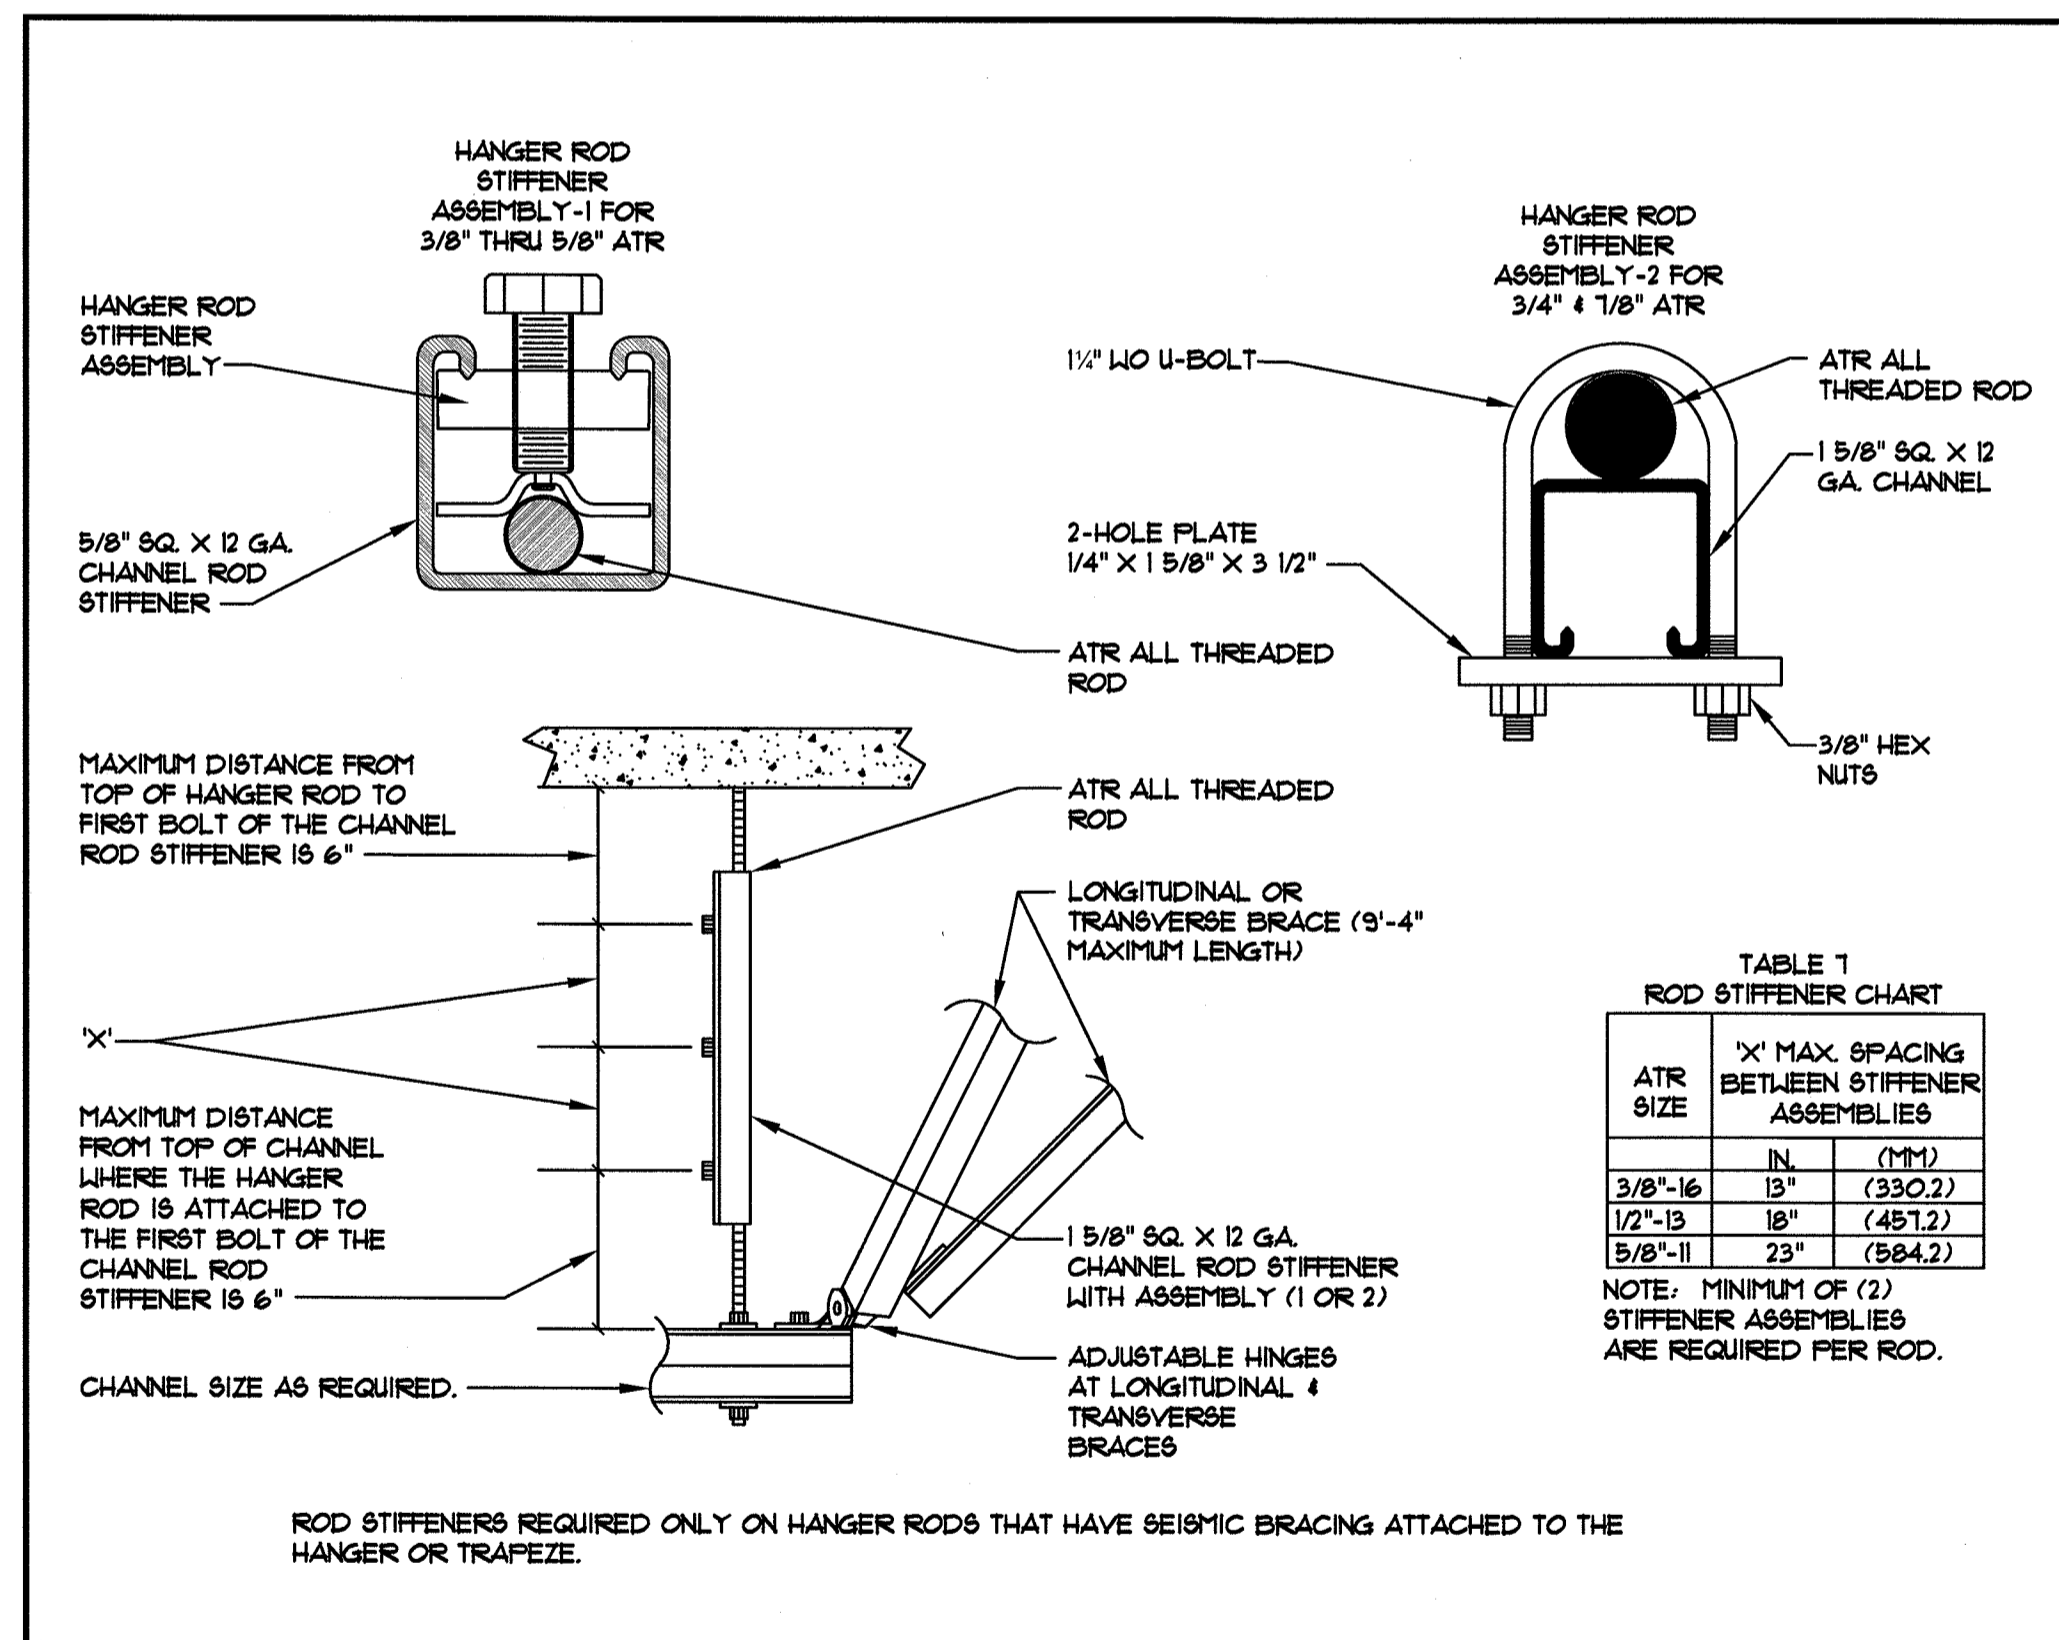


4 SEISMIC BRACING DETAIL
M6.3 SCALE: NONE

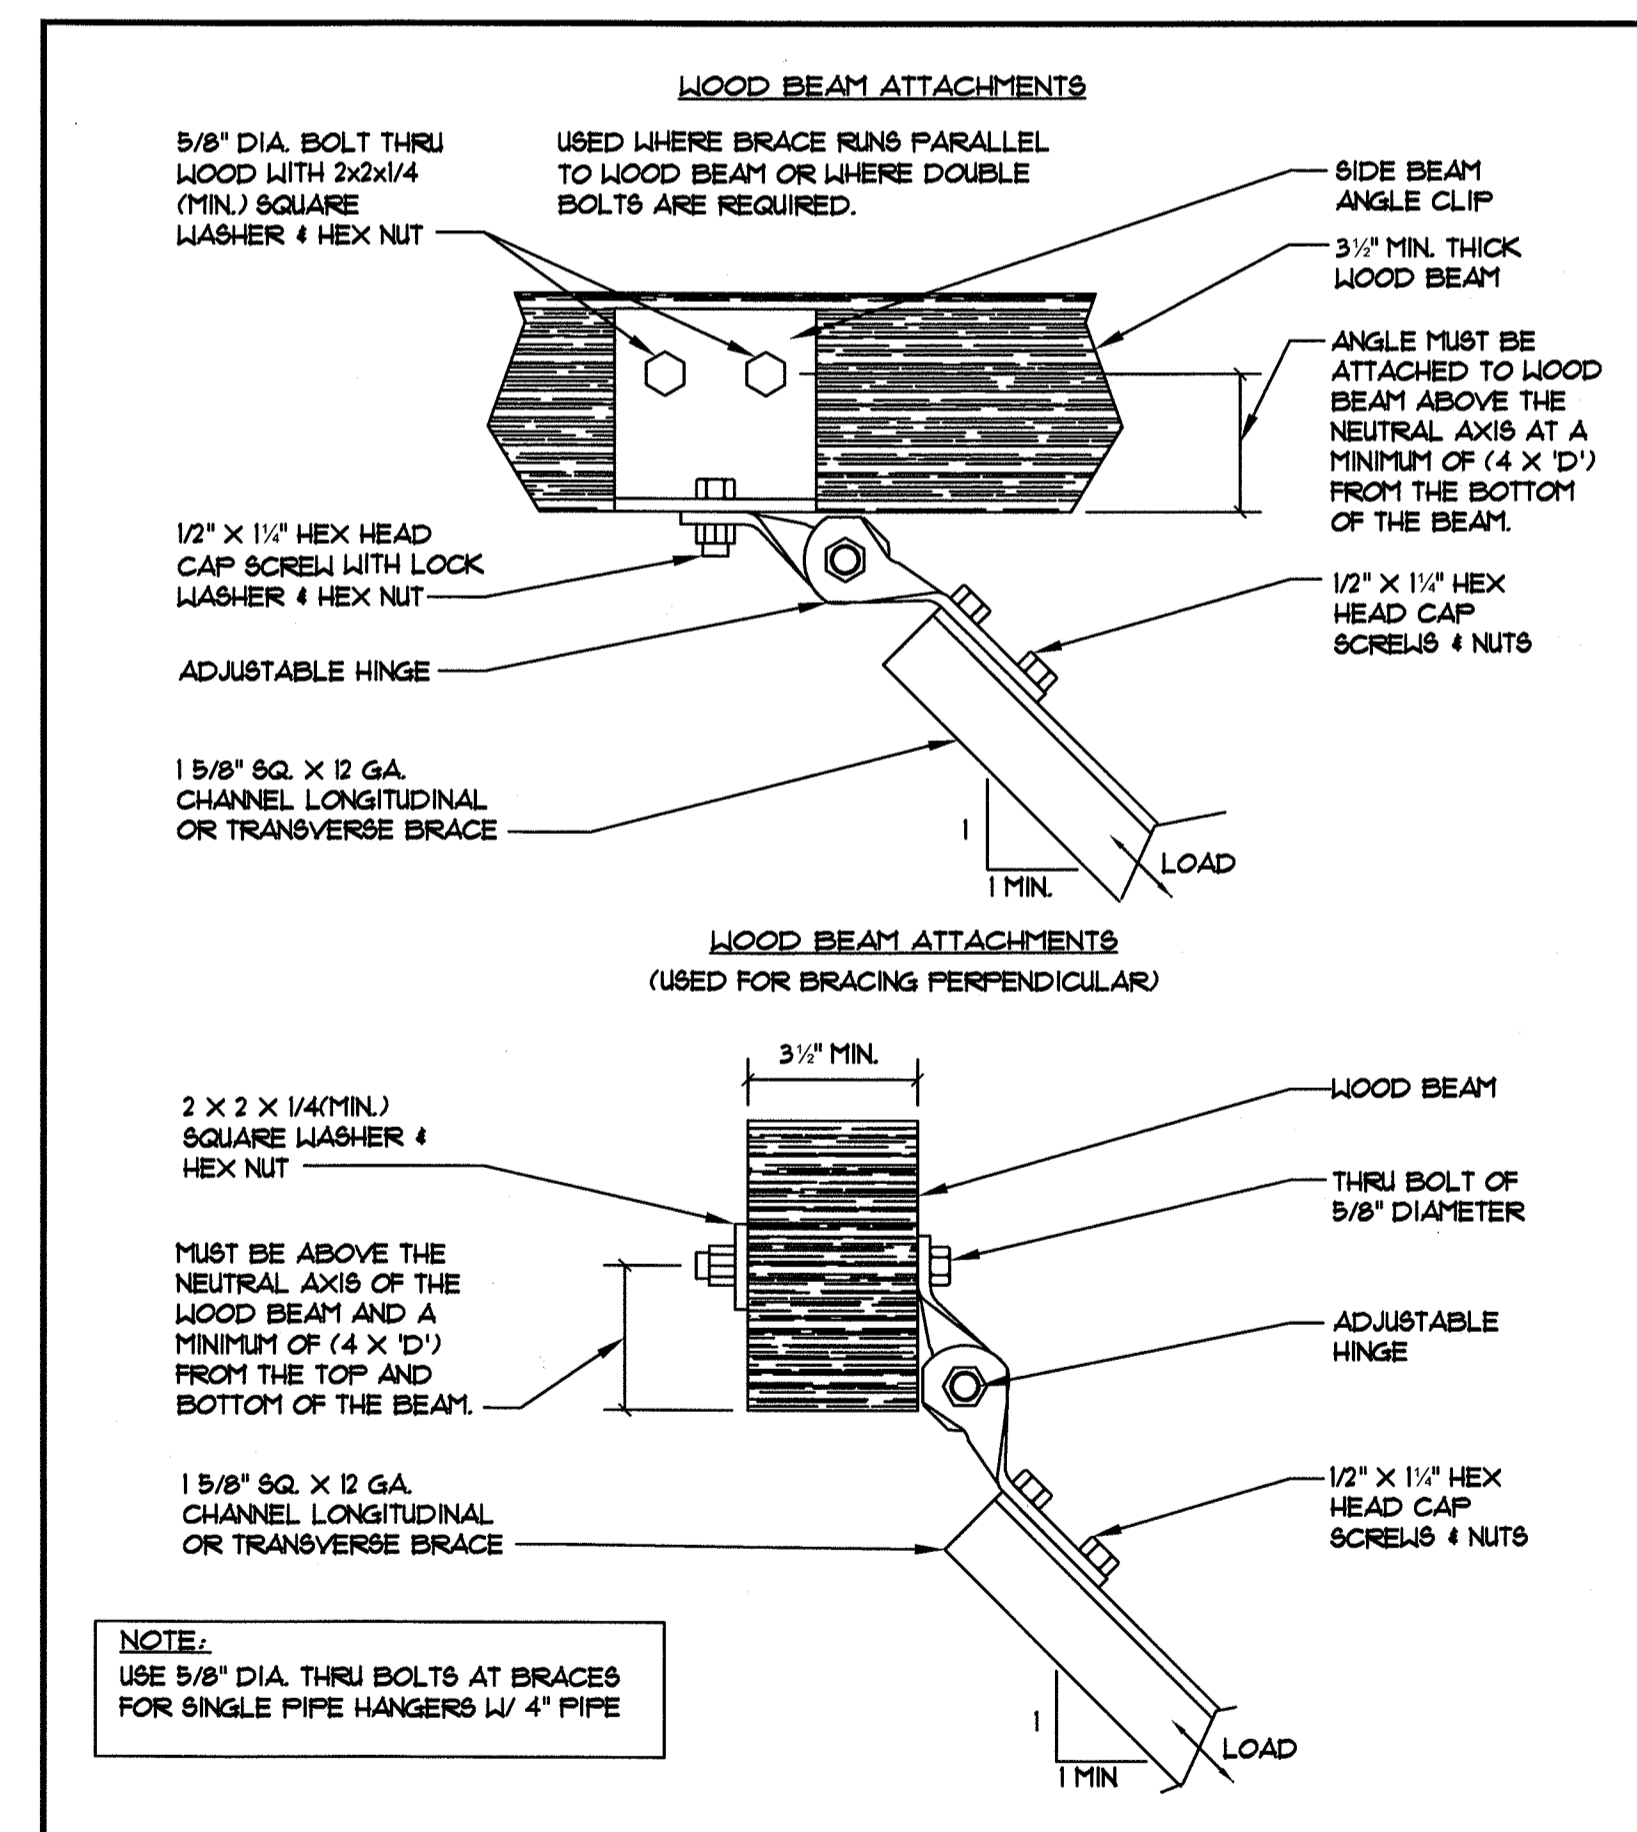

5 SEISMIC BRACING DETAIL
M6.3 SCALE: NONE

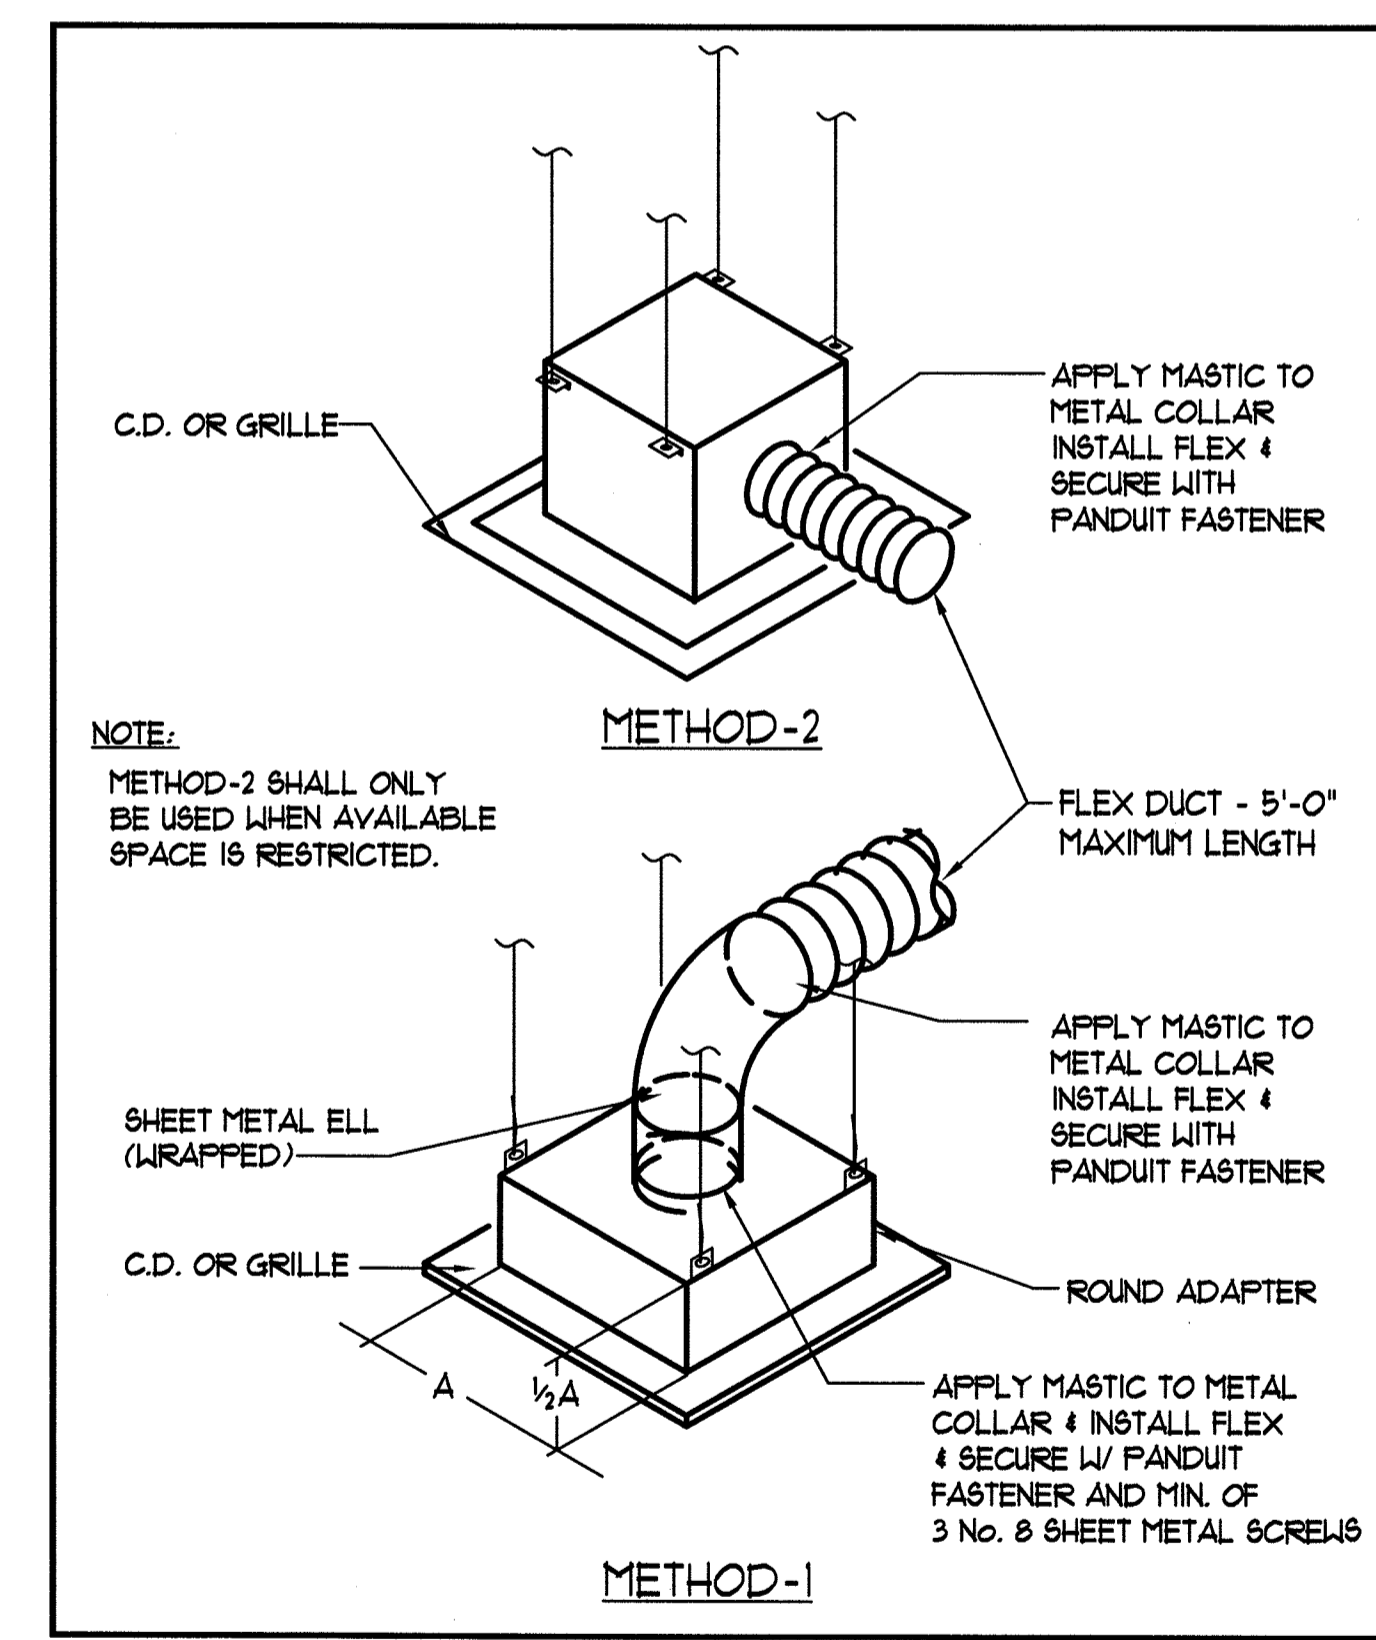


6 LAY IN CEILING DIFFUSER DETAIL
M6.3 SCALE: NONE

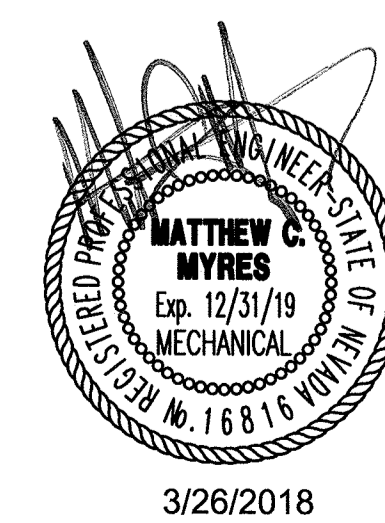

BID DOCUMENTS

MMI ENGINEERING
385 GENTRY WAY
RENO, NV. 89502
(775) 499-5784
WWW.MMI-DESIGNER.COM
MMI PROJECT #2016-19

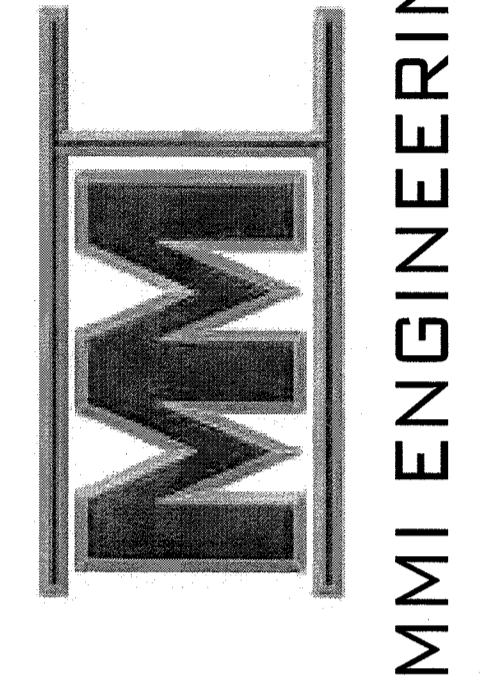


SPARKS POLICE DEPARTMENT
HVAC UPGRADE PHASE 1
1701 EAST PRATER WAY
SPARKS, NEVADA 89434

SHEET TITLE
MECHANICAL DETAILS (3)

REVISIONS


DATE: MARCH 26, 2018
RECEIVED-CITY OF SPARKS
SHEET NUMBER: MAR 28 2018
COMMUNITY SERVICES BUILDING DIVISION
M6.3

3/26/2018

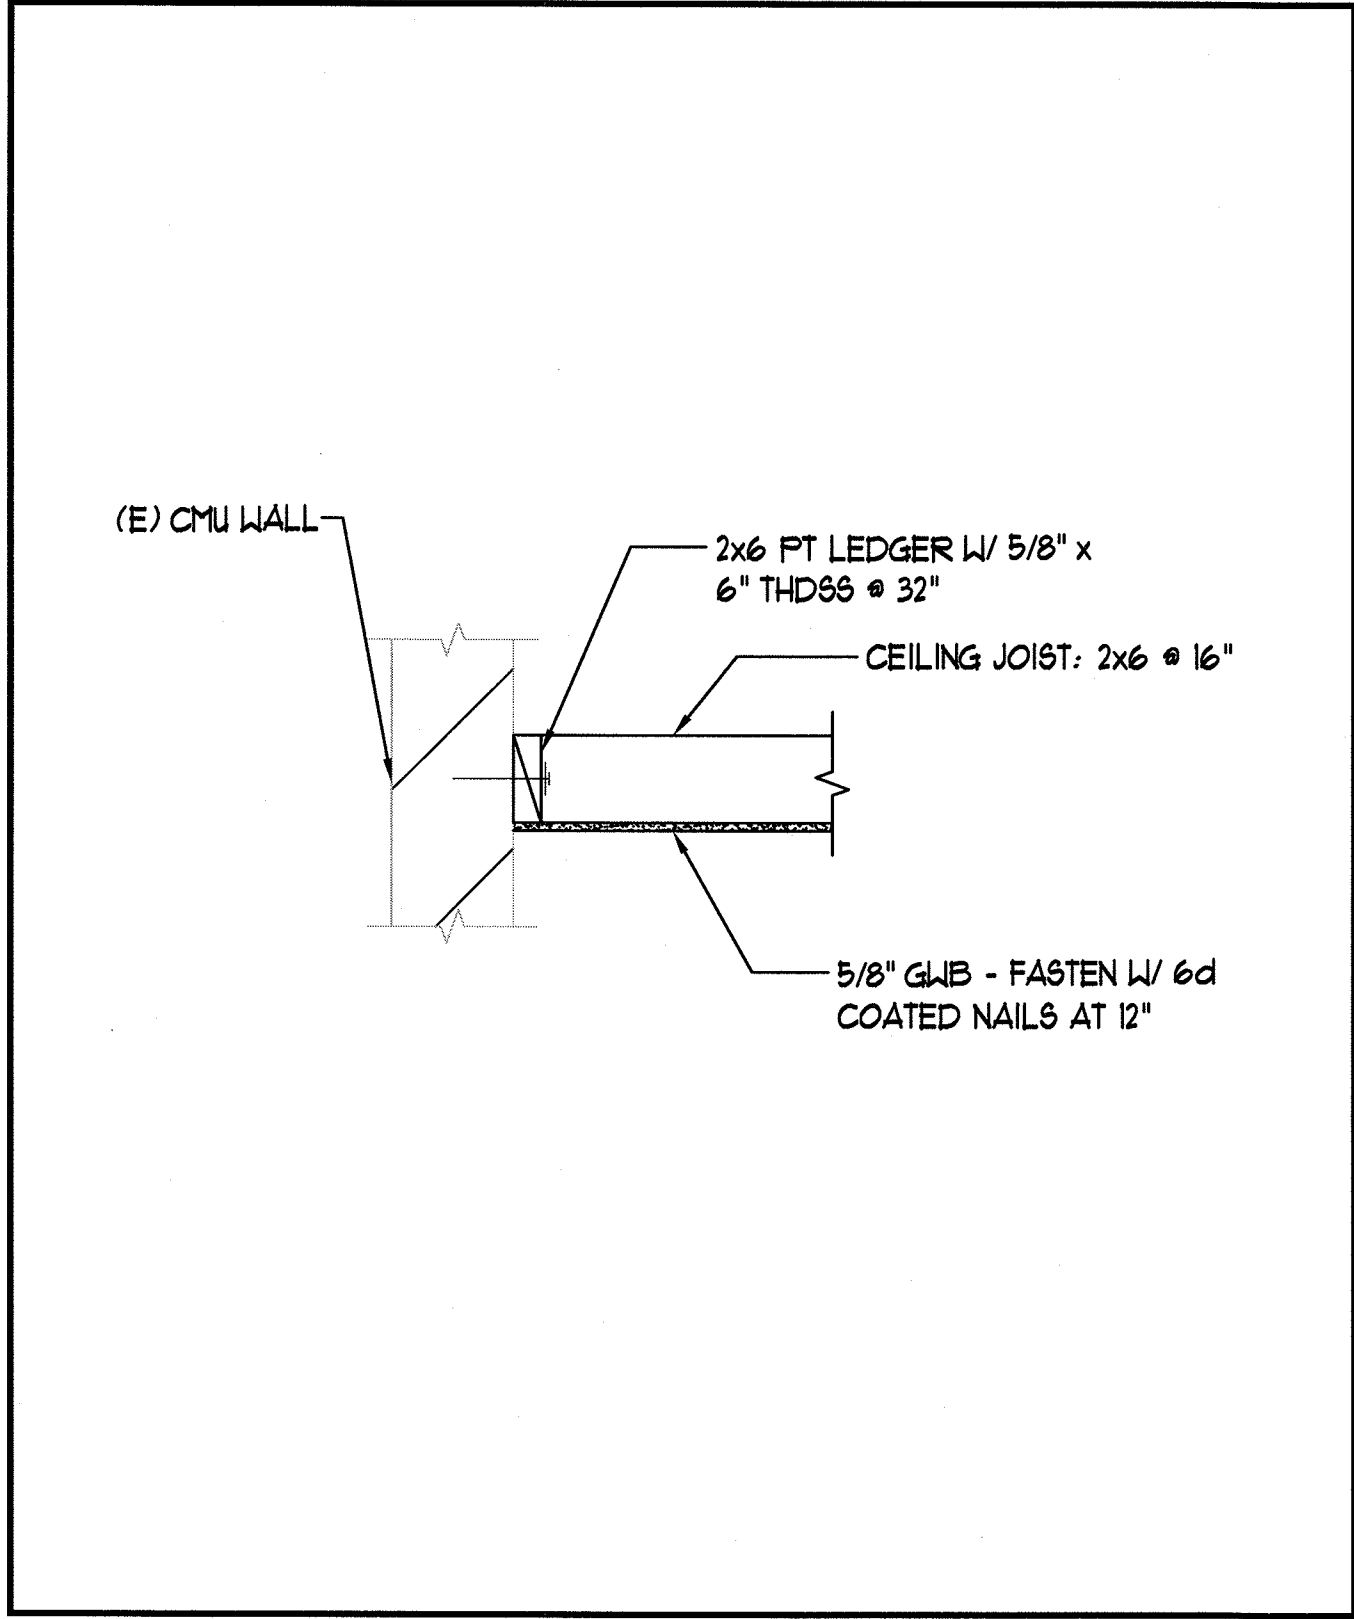

1 GYPSUM BOARD CEILING DETAIL
 M6.4 SCALE: NONE

MMI ENGINEERING
 385 GENTRY WAY
 RENO, NV. 89502
 (775) 499-5784
 WWW.MMIENGINEERING.COM
 MMI PROJECT #2016-19

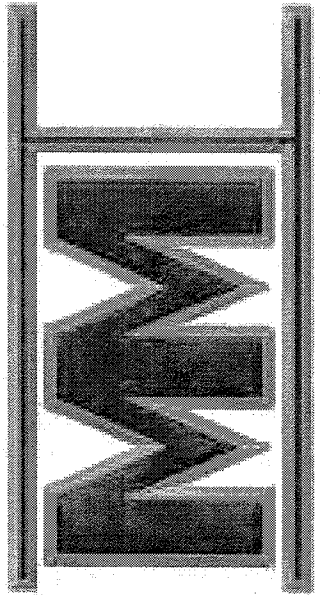


MMI ENGINEERING

SPARKS POLICE DEPARTMENT
 HVAC UPGRADE PHASE 1
 1701 EAST PRATER WAY
 SPARKS, NEVADA 89434

SHEET TITLE
 MECHANICAL DETAILS (4)

REVISIONS

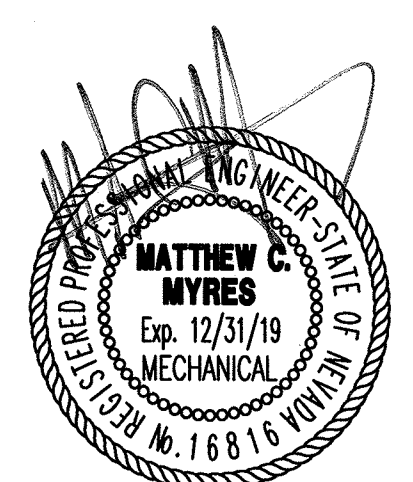

3/26/2018

BID DOCUMENTS

DATE: MARCH 26, 2018 OF SPARKS
 SHEET NUMBER: MAR 28 2018
 COMMUNITY SERVICES BUILDING DIVISION

M6.4

ELECTRICAL SYMBOL LIST

	CONDUIT RUN IN OR ON CEILING OR WALL
	CONDUIT RUN IN OR UNDER FLOOR OR UNDERGROUND
	HASH MARKS INDICATE NUMBER OF #12 AWG CONDUCTORS IN CONDUIT. NO MARKS INDICATE 2 #12'S. DOES NOT INCLUDE GROUND WIRE. IF NON-METALLIC CONDUIT ADD GROUND PER NEC.
	LONG SLASH WITH HASH MARKS AS SHOWN INDICATES GROUND WIRE FOR ISOLATED GROUNDING SYSTEM. SIZE PER N.E.C.
	HOMERUN TO PANEL WITH PANEL AND CIRCUIT INDICATED
	HOMERUN TO PANEL WITH CIRCUIT NUMBER IN BRACKETS INDICATING MULTI-POLE BREAKER.
	RACEWAY UP
	RACEWAY DOWN
	FLEX CONDUIT TO LAY-IN FIXTURE IN CEILING
	"ON" INDICATES CIRCUITING IS SPLIT AT DIFFERENT LOCATIONS
	FLUORESCENT FIXTURE SURFACE OR SUSPENDED - SEE FIXTURE SCHEDULE FOR MOUNTING
	FLUORESCENT FIXTURE - LAY-IN
	SINGLE POLE SWITCH +48" AFF
	AUTOMATIC WALL SWITCHES, WATT STOPPER CAT. PW-100 120/277. +48" AFF
	DUAL LEVEL AUTOMATIC WALL SWITCHES, WATT STOPPER CAT NO. PW-200 120/277. +48" AFF
	MOTOR SYMBOL - HORSEPOWER AS INDICATED
	DISCONNECT SWITCH (30A/3P UNLESS INDICATED ON DWGS) "F" INDICATES FUSES PER MANUFACTURERS NAMEPLATE RATING
	MAGNETIC MOTOR STARTER (SIZE AS INDICATED ON DRAWINGS)
	COMBINATION STARTER / FUSED DISCONNECT SWITCH (SIZE AS INDICATED ON DRAWINGS - FUSES SIZED PER MANUFACTURER'S NAMEPLATE RATING)
	120V DUPLEX CONVENIENCE RECEPTACLE +18" AFF
	120V DOUBLE DUPLEX CONVENIENCE RECEPTACLE +18" AFF
	JUNCTION BOX AS REQUIRED BY NATIONAL ELECTRIC CODE
	ELECTRICAL PANELBOARD - SURFACE MOUNTED
	TRANSFORMER
	AUXILIARY SYSTEM TERMINAL CABINET
	EXISTING WIRE AND/OR CONDUIT TO BE REMOVED OR ABANDONED
	EXISTING WIRE AND/OR CONDUIT TO REMAIN
	DASHED DEVICES, LIGHT FIXTURES, ETC. EXISTING TO BE REMOVED
	"E" ADJACENT TO DEVICES, LIGHT FIXTURES, ETC. INDICATES EXISTING TO REMAIN
	SHEET NOTE
	LIGHT FIXTURE DESIGNATION & WATTAGE. SEE FIXTURE SCHEDULE
	MECHANICAL EQUIPMENT DESIGNATION. SEE MECHANICAL & PLUMBING PLANS
	FEEDER - SIZE AS INDICATED ON SINGLE LINE DIAGRAM
	DETAIL DESIGNATION - "B" INDICATES DETAIL # ON SHEET E3.1
	ROOM NUMBER

* NOTE: ALL MOUNTING HEIGHTS AS INDICATED UNLESS NOTED OTHERWISE.
ALL SYMBOLS MAY NOT BE USED ON PROJECTS.

ELECTRICAL ABBREVIATIONS

AC	ABOVE COUNTER. INSTALL 4" ABOVE SPLASH OR COUNTER OR AT HEIGHT AS INDICATED ON DRAWINGS
AFF	ABOVE FINISHED FLOOR
AFG	ABOVE FINISHED GRADE
AL	ALUMINUM
CU	COPPER
EC	EMPTY CONDUIT WITH PULL WIRE
FBO	FURNISHED BY OTHER SECTION
GFI	GROUND FAULT INTERRUPTING
NEC	NATIONAL ELECTRICAL CODE
NIC	NOT IN CONTRACT
NVE	NV ENERGY
PNL	PANEL
TTB	TELEPHONE TERMINAL BOARD
UNO	UNLESS NOTED OTHERWISE
W/	WITH
WP	WEATHERPROOF (NEMA 3R)
XFMR	TRANSFORMER

GENERAL DEMOLITION NOTES


- ELECTRICAL LIGHTS, DEVICES AND ETC. THAT ARE INDICATED BY DASHED LINES SHALL BE REMOVED ENTIRELY, INCLUDING JUNCTION BOXES AND CIRCUITING ASSOCIATED WITH SAID ITEM.
- THESE PLANS DO NOT PURPORT TO SHOW ALL EXISTING CONDITIONS. ANY OUTLETS, CIRCUITING AND/OR DEVICES THAT CONFLICT WITH ALL WORK BEING PERFORMED DURING THE COURSE OF THIS PROJECT SHALL BE RELOCATED/ROUTED OR REMOVED ENTIRELY AS DICTATED BY OWNER.
- IT IS RECOMMENDED THAT THE CONTRACTOR VISIT SITE AND VERIFY EXISTING CONDITIONS THAT MIGHT AFFECT HIS OR HER WORK. ALL DISCREPANCIES SHALL BE REPORTED TO ENGINEER PRIOR TO BID.
- DEMOLITION AND MODIFICATION OF EXISTING DISTRIBUTION SYSTEMS SHALL BE PERFORMED AS FOLLOWS:
 - EXISTING WIRING TO BE REMOVED SHALL BE REMOVED BACK TO ITS SOURCE. CONDUITS MAY BE ABANDONED IN PLACE IF THEY ARE IN CONCEALED LOCATION AND DO NOT CONFLICT WITH ANY NEW WORK. THIS CONDUITS SHALL BE LABELED AS ABANDONED. REMOVE ALL WIRING FROM ABANDONED RACEWAYS.
 - CONTINUATION OF SERVICE: MAINTAIN CONTINUITY OF EXISTING CIRCUITS. TEST LIGHTING, RECEPTACLES AND ALL ELECTRICALLY POWERED EQUIPMENT IN SURROUNDING AREAS TO DETERMINE IF ANY EQUIPMENT TO REMAIN HAS BEEN DE-ENERGIZED. CONTRACTOR SHALL RECONNECT ALL EQUIPMENT AND EXTEND CIRCUITING IN ORDER TO RE-ACTIVATE ANY SUCH EQUIPMENT.

ELECTRICAL GENERAL NOTES

- UTILITIES SHOWN TO BE DEMOLISHED SHALL NOT BE REMOVED FROM SERVICE UNTIL EITHER OF THE FOLLOWING EVENTS OCCUR: A) THE FACILITY SERVED BY THE UTILITY IS NO LONGER OCCUPIED AND IS READY FOR DEMOLITION. OR B) EQUIVALENT SERVICE BY NEW UTILITY CONSTRUCTION HAS BEEN PROVIDED TO THE FACILITY CURRENTLY SERVICED. UNLESS OTHERWISE NOTED.
- VERIFY EXACT LOCATION OF ALL RECEPTACLES ABOVE OR ADJACENT TO COUNTERS FIXTURES MIRRORS OUTDOOR FIXTURES AND MOUNTING HEIGHTS & LOCATIONS OF ALL FIXTURES & BOXES PRIOR TO ROUGH-IN. NO EXTRA COSTS WILL BE ALLOWED FOR FAILURE TO COMPLY.
- ANY POWER OUTAGE OF ANY CIRCUIT SHALL BE APPROVED BY THE OWNER IN WRITING A MINIMUM OF TWO WEEKS PRIOR TO OUTAGE. ALL OUTAGES SHALL BE DONE EXACTLY WHEN DETERMINED BY THE OWNER AND DONE BEFORE OR AFTER WORKING HOURS AND ON WEEKENDS. NO SINGLE OUTAGE SHALL REQUIRE MORE THAN 4 HOURS. PROVIDE TEMPORARY POWER, HEAT & COOLING IF REQUIRED DURING OUTAGE.
- PRIOR TO PURCHASE OF ANY PANEL, PROTECTIVE DEVICES, SWITCH, STARTER, CONDUIT, WIRE, ETC., TO FEED ANY PIECE OF MECHANICAL EQUIPMENT VERIFY THE VOLTAGE, PHASE, & LOAD OF THAT ITEM IN THE FIELD AND/OR WITH THE PARTICULAR ENTITY INVOLVED IN FURNISHING THE ITEM SUCH THAT THE PROPER SIZE & RATING OF THE MATERIALS ARE PURCHASED. NO EXTRAS WILL BE ALLOWED FOR FAILURE TO COMPLY. THIS APPLIES TO ALL EQUIPMENT UNDER OTHER SECTIONS & BY THE OWNER.
- ALL RECEPTACLES SHALL MATCH THE MALE PLUG CONNECTOR OF ALL EQUIPMENT PROVIDED VERIFY PRIOR TO PURCHASE. SEE GENERAL NOTE 4.
- PULL ROPES: PROVIDE 12 GA PULL WIRE OR NYLON EQUIVALENT IN ALL INTERIOR EMPTY CONDUIT RUNS. PROVIDE 1/4" DIA NYLON PULL ROPE IN EACH EMPTY EXTERIOR CONDUIT OR DUCT.
- COORDINATE WITH MECHANICAL CONTRACTORS TO AVOID CONFLICTS BETWEEN DUCT WORK, SUPPLY & EXHAUST DIFFUSERS AND LIGHTING, SOUND SYSTEM & FIRE ALARM SYSTEM FIXTURES.
- VERIFY THE EXACT LOCATION AND ELEVATION OF ALL ELECTRICAL EQUIPMENT PRIOR TO ROUGH-IN. FINAL CONNECTIONS OF EQUIPMENT SHALL BE PER MANUFACTURERS APPROVED WIRING DIAGRAMS, DETAILS AND INSTRUCTIONS. THE ELECTRICAL CONTRACTOR SHALL PROVIDE MATERIALS AND EQUIPMENT COMPATIBLE WITH EQUIPMENT ACTUALLY SUPPLIED.
- ORDER AND/OR RELEASE ORDERED MATERIALS PROMPTLY AFTER SUBMITTAL APPROVAL. NO SUBSTITUTIONS OR ALTERNATE METHODS OF INSTALLATION WILL BE ACCEPTED FOR FAILURE TO ORDER MATERIALS IN A TIMELY FASHION.
- CONDUIT/ CONDUCTOR RUNS SHOWN ARE DIAGRAMMATICAL ONLY. THE BEST FINAL CONDUIT ROUTING SHALL BE AS DETERMINED BY THE ELECTRICAL CONTRACTOR AT TIME OF CONSTRUCTION.
- SERIES RATING OF UPSTREAM OR DOWNSTREAM CIRCUIT BREAKERS OR FUSES IS PROHIBITED. ONLY FULLY RATED SYSTEM COMPONENTS WILL BE ACCEPTED.
- PROVIDE ALL TRENCHING, EXCAVATION, BACK FILLING, SHORING, PUMPING, COMP ACTION TESTS, ETC. THAT ARE REQUIRED FOR THE SCOPE OF ELECTRICAL WORK.


385 Gentry Way
Reno, NV 89502
Ph: 775.826.4044
Fax: 775.826.4190
Web: dnter.com
J-4538

DINTER
ENGINEERING CONFIDENCE

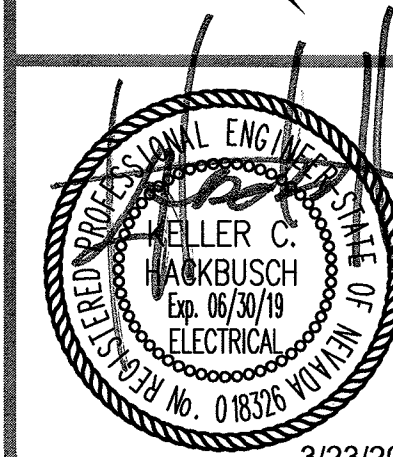

3/23/2018

MMI ENGINEERING
385 GENTRY WAY
RENO, NV. 89502
(775) 499-5784
WWW.MMIE-DESIGNER.COM
MMI PROJECT #2016-19

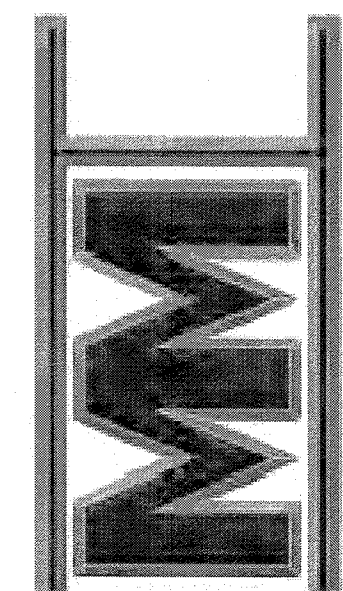

MMI ENGINEERING

SPARKS POLICE DEPARTMENT
HVAC UPGRADE PHASE 1
1701 EAST PRATER WAY
SPARKS, NEVADA 89434

SHEET TITLE

ELECTRICAL SYMBOL LIST

REVISIONS

BID DOCUMENTS


RECEIVED CITY OF SPARKS

DATE : MARCH 26, 2018 MAR 28 2018
COMMUNITY SERVICES
BUILDING DIVISION

E0.1

ELECTRICAL SHEET NOTES:

- 1 ELECTRICAL LOAD REMOVED DURING MECHANICAL EQUIPMENT REPLACEMENT.
- 2 NEW ELECTRICAL LOAD ADDED FOR NEW MECHANICAL EQUIPMENT.
- 3 NEW 20AMP/3POLE BREAKER TO BE FURNISHED AND INSTALL BY ELECTRICAL CONTRACTOR.

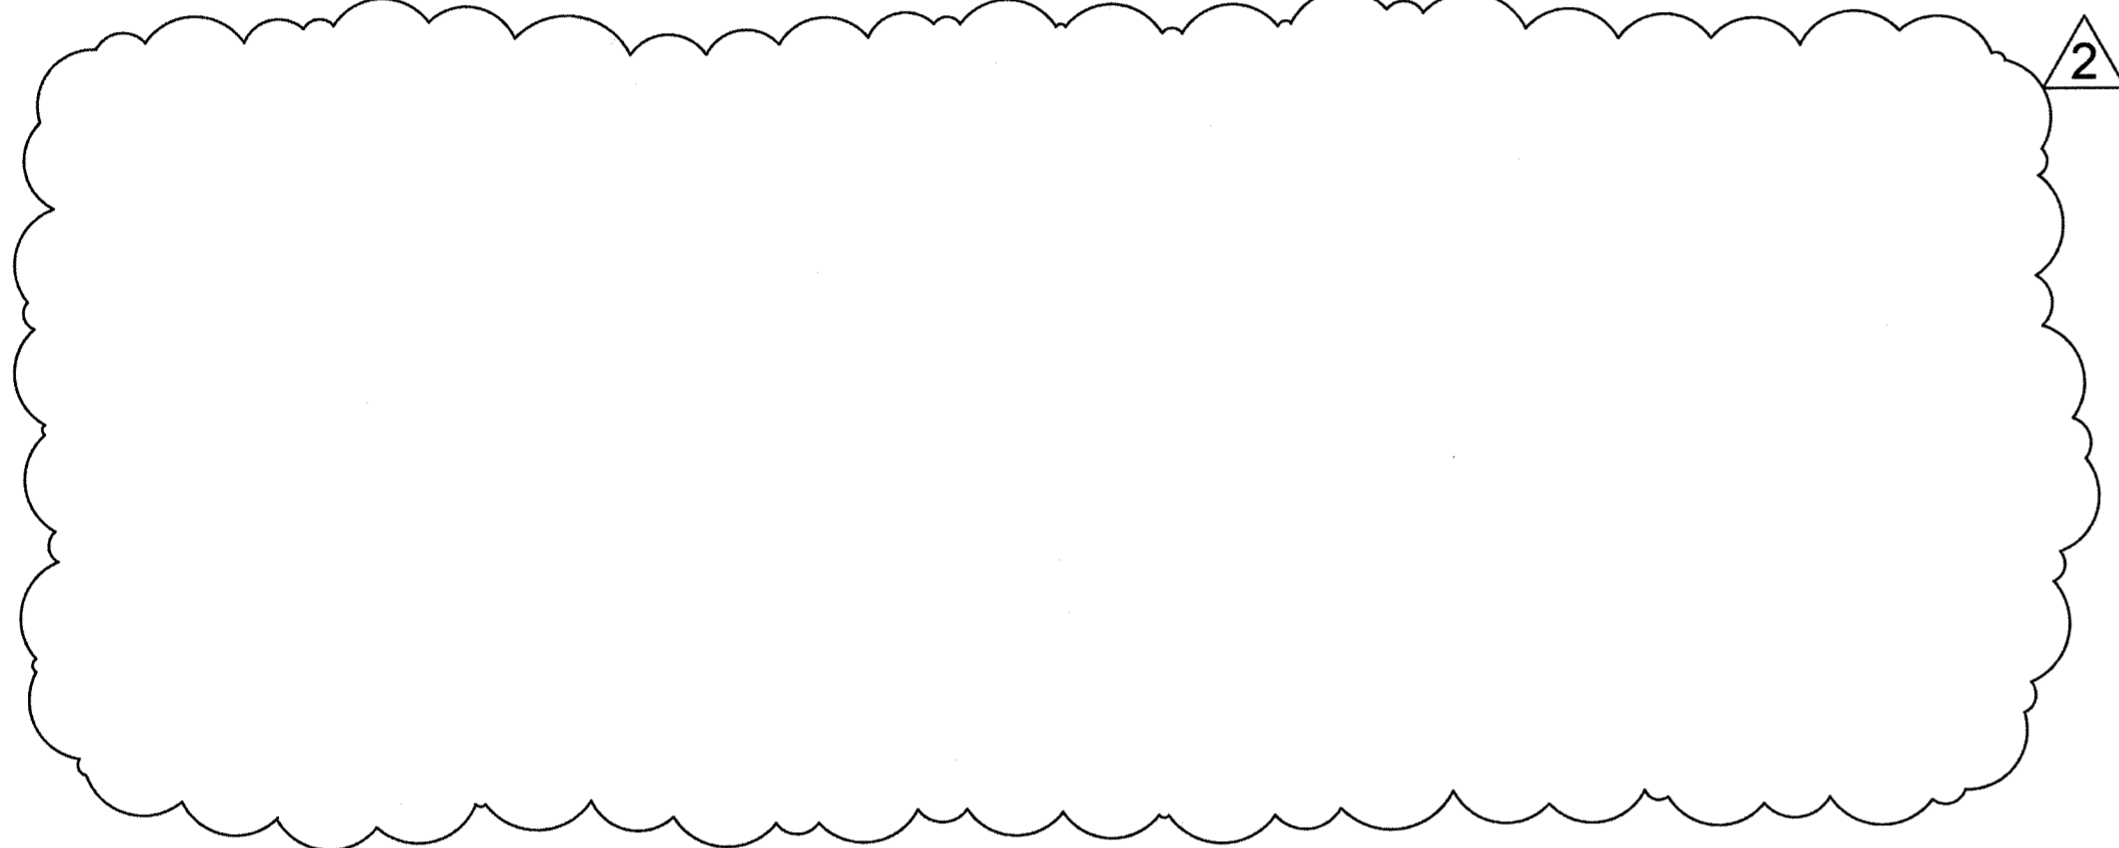

PANEL BOARD		1HM		EXISTING					
DIRECTORY	LOAD	BKR	CIR		CIR	BKR	LOAD	DIRECTORY	
(N) FC-1	998	20	1	A	2	20/1	3324	(N) Basement Mech Xfmr	
	998		3	B	4	20/1	3324	(N) Ground Flr Mech Xfmr	
	998		5	C	6	20/1	3324	(N) 2nd Flr Mech Xfmr	
(N) Spare		20/1	7	A	8	20/1		(N) Spare	
(N) Spare		20/1	9	B	10	30/1		(N) Spare	
Existing Load	3500	20/1	11	C	12	20/1	3500	Existing Load	
Existing Load	3500	20/1	13	A	14	20/1	3500	Existing Load	
Existing Load	3500	20/1	15	B	16	20/1	3500	Existing Load	
Existing Load	3500	20/1	17	C	18	50	8924	(N) AC-3	
Existing Load	3500	20/1	19	A	20		8924		
Existing Load	3500	20/1	21	B	22	3	8924		
(N) Spare		20/1	23	C	24	20/1		(N) Spare	
(N) Spare		20/1	25	A	26	20/1		(N) Spare	
(N) FC-2	998	20	27	B	28	20	998	(N) FC-3	
	998		29	C	30		998		
	998		31	A	32	3	998		
Space			33	B	34			Space	
			35	C	36				
			37	A	38				
			39	B	40				
			41	C	42				
CONNECTED LOAD		77226 VA	(93 A)					OTHER NOTES:	
		A= 25742 VA	93 A					277/480V., 3PH, 4W	
		B= 25742 VA	93 A					200 AMP MLO	
		C= 25742 VA	93 A					200 AMP BUS	

PANEL BOARD		BLB		EXISTING					
DIRECTORY	LOAD	BKR	CIR		CIR	BKR	LOAD	DIRECTORY	
Spare		20/1	1	A	2	20/1	800	WH-1 Control	
Spare		20/1	3	B	4	20/1	1200	CP-1	
Spare		20/1	5	C	6	20/1	800	Chiller Control	
Spare		20/1	7	A	8	20/1		Spare	
Spare		20/1	9	B	10	20/1		Spare	
Spare		20/1	11	C	12	20/1		Spare	
Spare		20/1	13	A	14	20/1		Spare	
Spare		20/1	15	B	16	20/1		Spare	
Spare		20/1	17	C	18	20/1	1656	(N) EF-1	
Aux HTR CHLR	4680	50	19	A	20	50	4680	Aux HTRS BLR	
	4680		21	B	22	2	4680		
Space			23	C	24			Space	
			25	A	26				
			27	B	28				
			29	C	30				
			31	A	32				
			33	B	34				
			35	C	36				
			37	A	38				
			39	B	40				
			41	C	42				
CONNECTED LOAD		23176 VA	(64 A)					OTHER NOTES:	
		A= 10160 VA	85 A					120/208V., 3PH, 4W	
		B= 10560 VA	88 A					200 AMP MLO	
		C= 2456 VA	20 A					200 AMP BUS	

385 Gentry Way
Reno, NV 89502
Ph: 775.826.4044
Fax: 775.826.4190
Web: dinter.com
J-4538

DINTER
ENGINEERING CONFIDENCE

06/04/2019

MMI ENGINEERING
385 GENTRY WAY
RENO, NV. 89502
(775) 499-5784
WWW.MMI-DESIGNER.COM
MMI PROJECT #2016-19

MMI
ENGINEERING

SPARKS POLICE DEPARTMENT
HVAC UPGRADE PHASE 1
1701 EAST PRATER WAY
SPARKS, NEVADA 89434

SHEET TITLE
ELECTRICAL NOTES
AND CALCULATION

REVISIONS


2	OWNER REVISIONS (10/31/18)
3	OWNER REVISIONS (06/04/19)

BID DOCUMENTS


CITY OF SPARKS
DATE: JUNE 11, 2019
COMMUNITY SERVICES-BLDG. DIV.
SHEET NO. E0.2

ELECTRICAL SHEET NOTES:

- ① ELECTRICAL CONTRACTOR SHALL REMOVE ELECTRICAL CONNECTIONS TO MECHANICAL FAN AND VAV. THE FAN AND VAV SHALL BE REMOVED BY MECHANICAL CONTRACTOR. ELECTRICAL CONTRACTOR SHALL REMOVE ALL WIRING AND CONDUIT FOR FAN AND VAV CIRCUITS 1, 3, 5, 2, AND 4 BACK TO PANEL BOARD '1HM' ON THE GROUND FLOOR.
- ② ELECTRICAL CONTRACTOR SHALL REMOVE ELECTRICAL CONNECTIONS TO LIGHT FIXTURES AND ROOM LIGHT SWITCH, AND REMOVE EXISTING LIGHT FIXTURES AND WALL SWITCH. EXISTING CEILING GRID SHALL BE REMOVED BY GENERAL CONTRACTOR. ELECTRICAL CONTRACTOR TO LEAVE CONDUIT FROM WALL SWITCH UP TO CEILING SPACE AND REUSE FOR NEW LIGHTING.
- ③ ELECTRICAL CONTRACTOR SHALL INTERCEPT CONDUIT AND WIRING FROM VAULT LIGHT. ELECTRICAL CONTRACTOR TO FURNISH AND INSTALL JUNCTION BOX FOR CONNECTION TO NEW LIGHTING (SEE SHEET E2.1)
- ④ ELECTRICAL CONTRACTOR SHALL INTERCEPT CONDUIT AND WIRING FROM ROOM 041. ELECTRICAL CONTRACTOR TO FURNISH AND INSTALL JUNCTION BOX FOR CONNECTION TO NEW LIGHTING (SEE SHEET E2.1).
- ⑤ ELECTRICAL CONTRACTOR SHALL REMOVE ELECTRICAL CONNECTIONS TO CONDENSER WATER PUMP "P-4" AND PUMP "P-4"'S COMBINATION CIRCUIT BREAKER-MOTOR STARTER. ELECTRICAL CONTRACTOR SHALL REMOVE COMBINATION CIRCUIT BREAKER-MOTOR STARTER, REMOVE WIRING AND CONDUIT FROM PUMP "P-4" TO COMBINATION CIRCUIT BREAKER-MOTOR STARTER, AND REMOVE WIRING AND CONDUIT FROM MOTOR STARTER BACK TO PANEL BOARD.

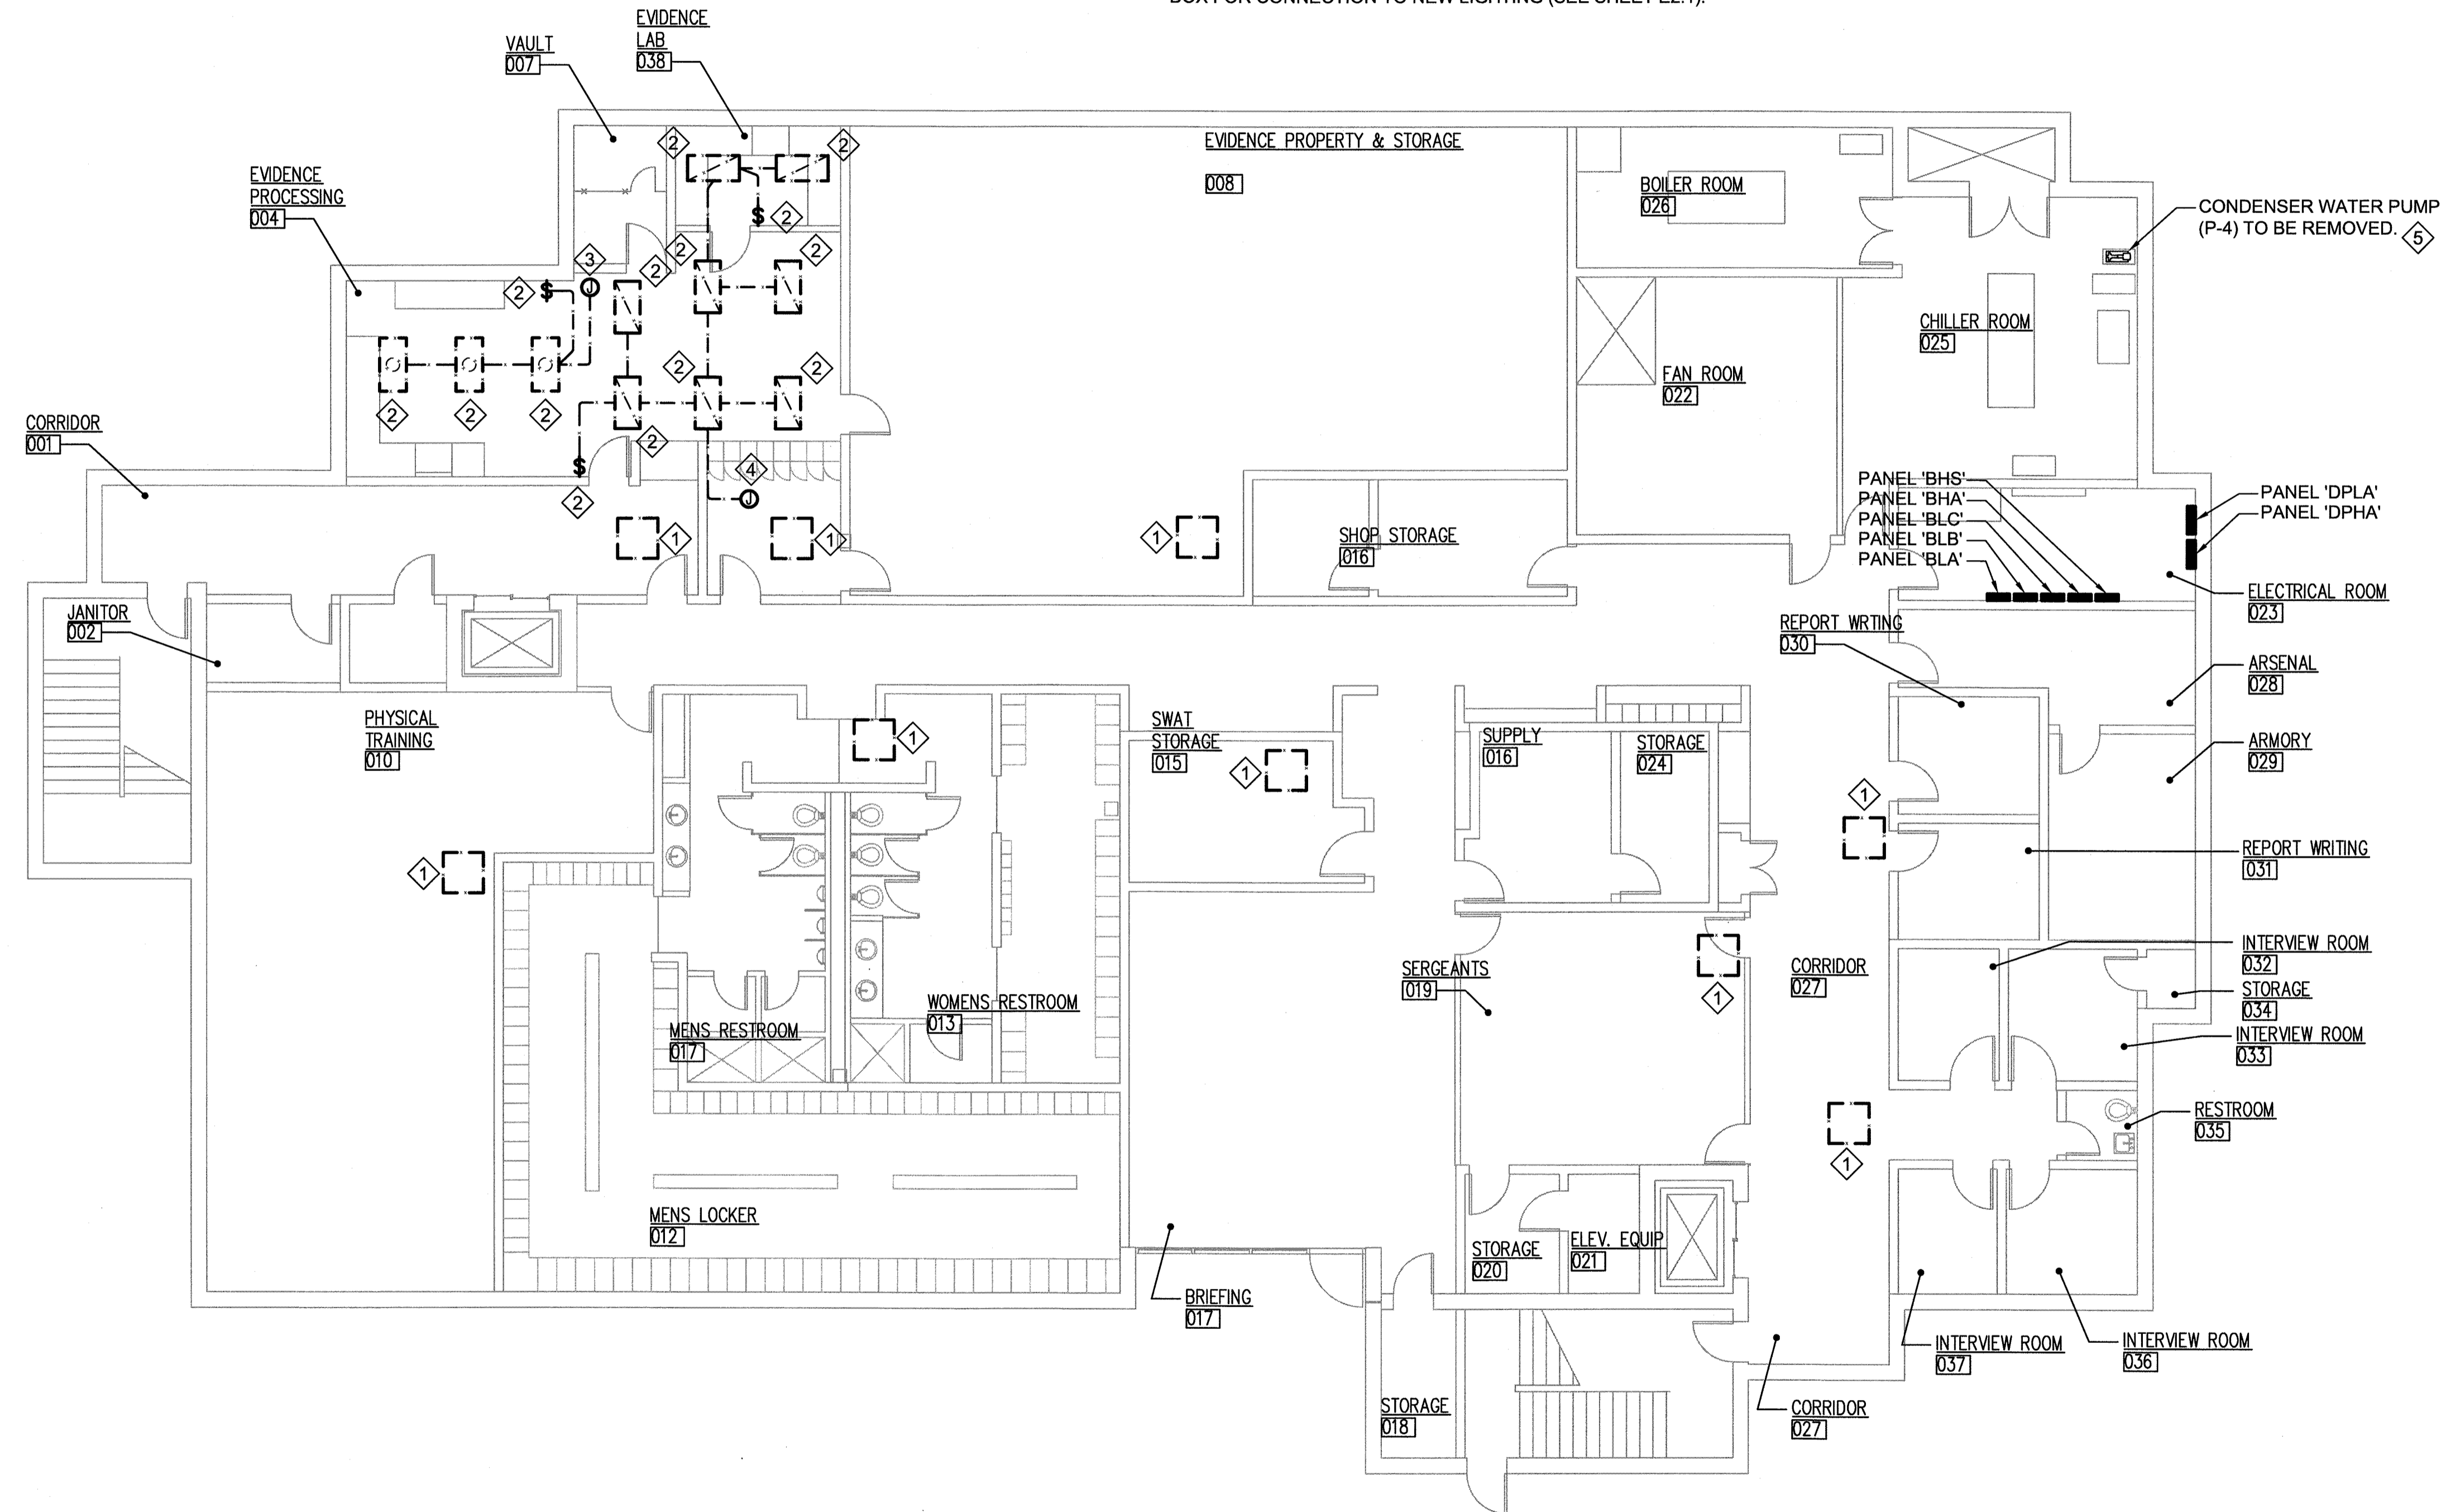


385 Gentry Way
Reno, NV 89502
Ph: 775.826.4044
Fax: 775.826.4190
Web: dinter.com
J-4538

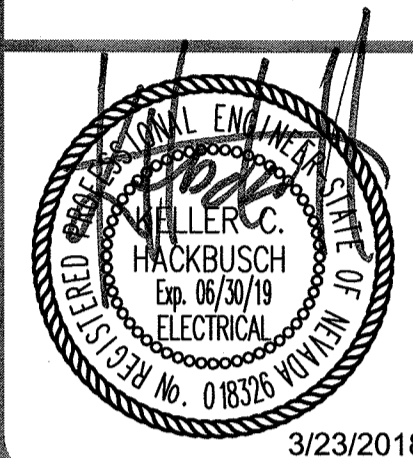

3/23/2018

MMI ENGINEERING
385 GENTRY WAY
RENO, NV. 89502
(775) 499-5784
WWW.MMIE-DESIGNER.COM
MMI PROJECT #2016-19

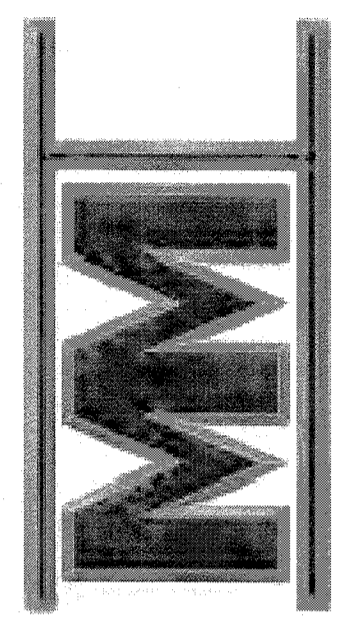

MMI ENGINEERING

SPARKS POLICE DEPARTMENT
HVAC UPGRADE PHASE 1
1701 EAST PRATER WAY
SPARKS, NEVADA 89434


SHEET TITLE
ELECTRICAL DEMOLITION
FLOOR PLAN - BASEMENT

REVISIONS

1
E1.1 ELECTRICAL DEMOLITION FLOOR PLAN - BASEMENT
SCALE: 1/8" = 1'-0"

BID DOCUMENTS

DATE: MARCH 26, 2018
SHEET NUMBER: E1.1
RECEIVED-CITY OF SPARKS
MAR 28 2018
COMMUNITY SERVICES
BUILDING DIVISION

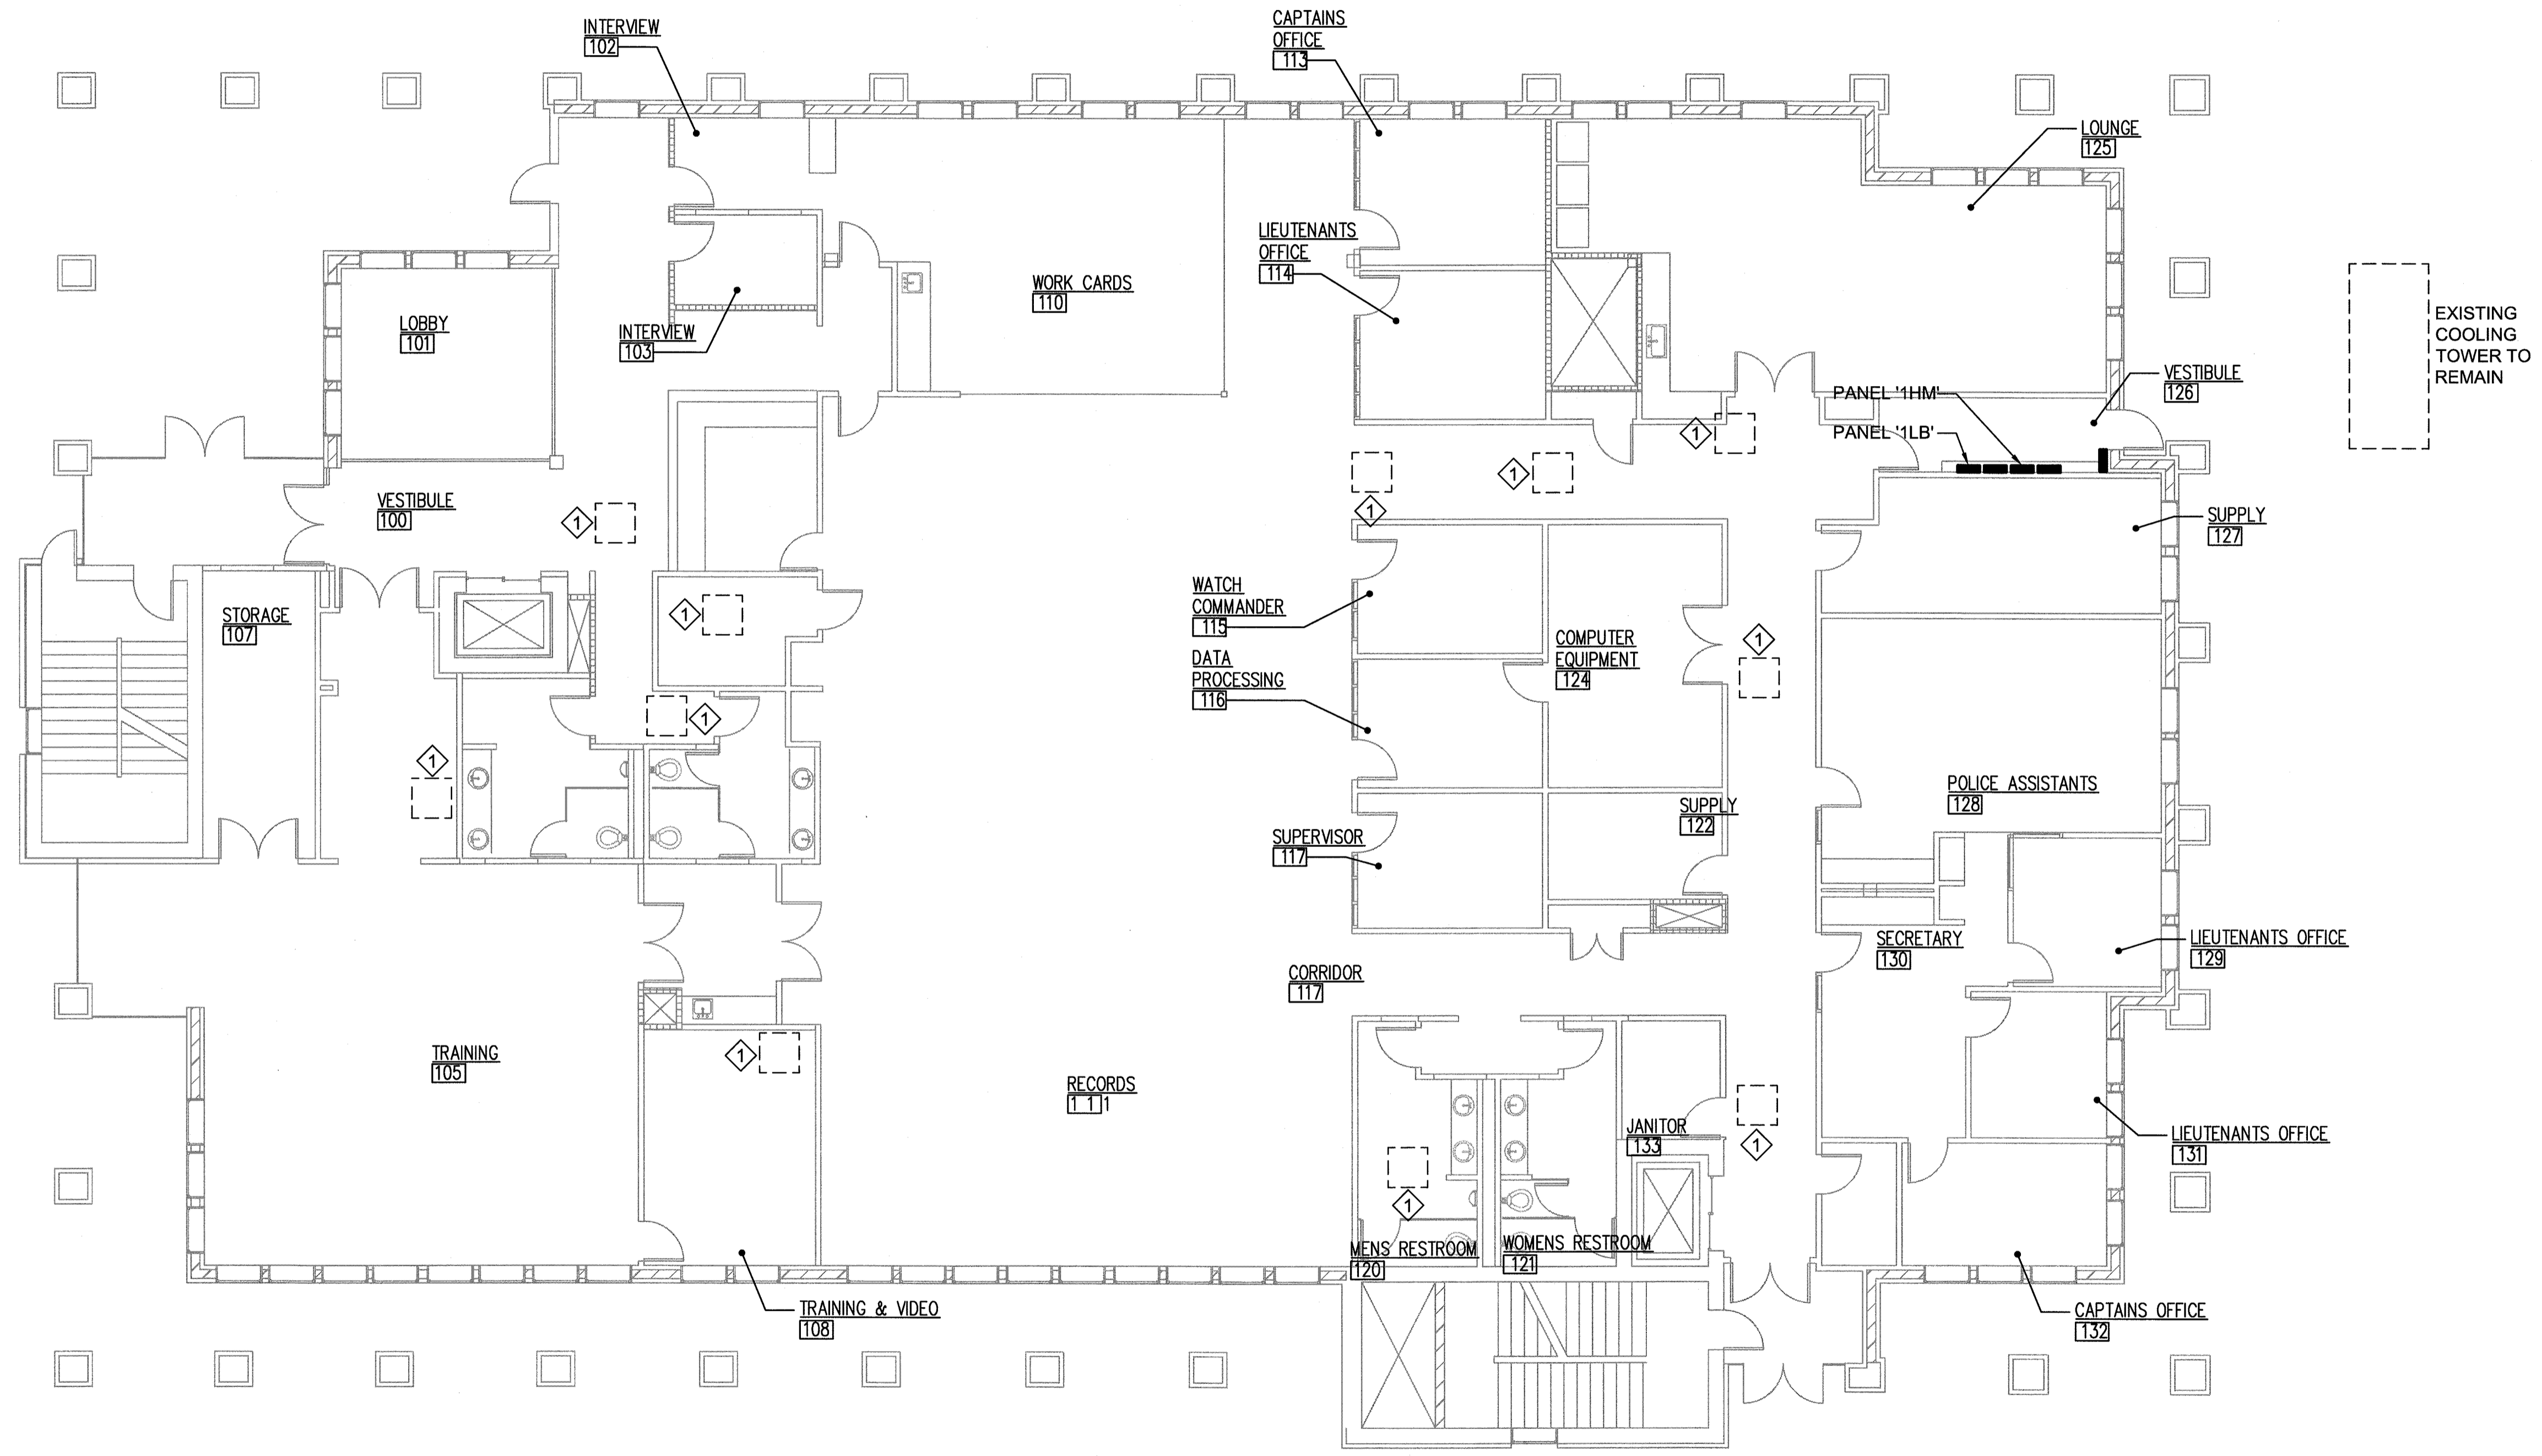

ELECTRICAL SHEET NOTES:

1 ELECTRICAL CONTRACTOR SHALL REMOVE ELECTRICAL CONNECTIONS TO MECHANICAL FAN AND VAV. THE FAN AND VAV SHALL BE REMOVED BY MECHANICAL CONTRACTOR. ELECTRICAL CONTRACTOR SHALL REMOVE ALL WIRING AND CONDUIT FOR FAN AND VAV CIRCUITS 6, 8, 10, 7, AND 9 BACK TO PANEL BOARD '1HM' ON THE GROUND FLOOR.

385 Gentry Way
 Reno, NV 89502
 Ph: 775.826.4044
 Fax: 775.826.4190
 Web: dinter.com
 J-4538

DINTER
 ENGINEERING CONFIDENCE

3/23/2018

MMI ENGINEERING

MMI ENGINEERING
 385 GENTRY WAY
 RENO, NV. 89502
 (775) 499-5784
 WWW.MMIE-DESIGNER.COM
 MMI PROJECT #2016-19

**SPARKS POLICE DEPARTMENT
 HVAC UPGRADE PHASE 1
 1701 EAST PRATER WAY
 SPARKS, NEVADA 89434**

SHEET TITLE
 ELEDTRICAL DEMOLITION
 FLOOR PLAN - GROUND
 FLOOR

REVISIONS

1
 E1.2 ELECTRICAL DEMOLITION FLOOR PLAN - GROUND FLOOR
 SCALE: 1/8" = 1'-0"


BID DOCUMENTS

DATE: MARCH 28, 2018 CITY OF SPARKS

SHEET NUMBER: MAR 28 2018

E1.2

COMMUNITY SERVICES
 BUILDING DIVISION

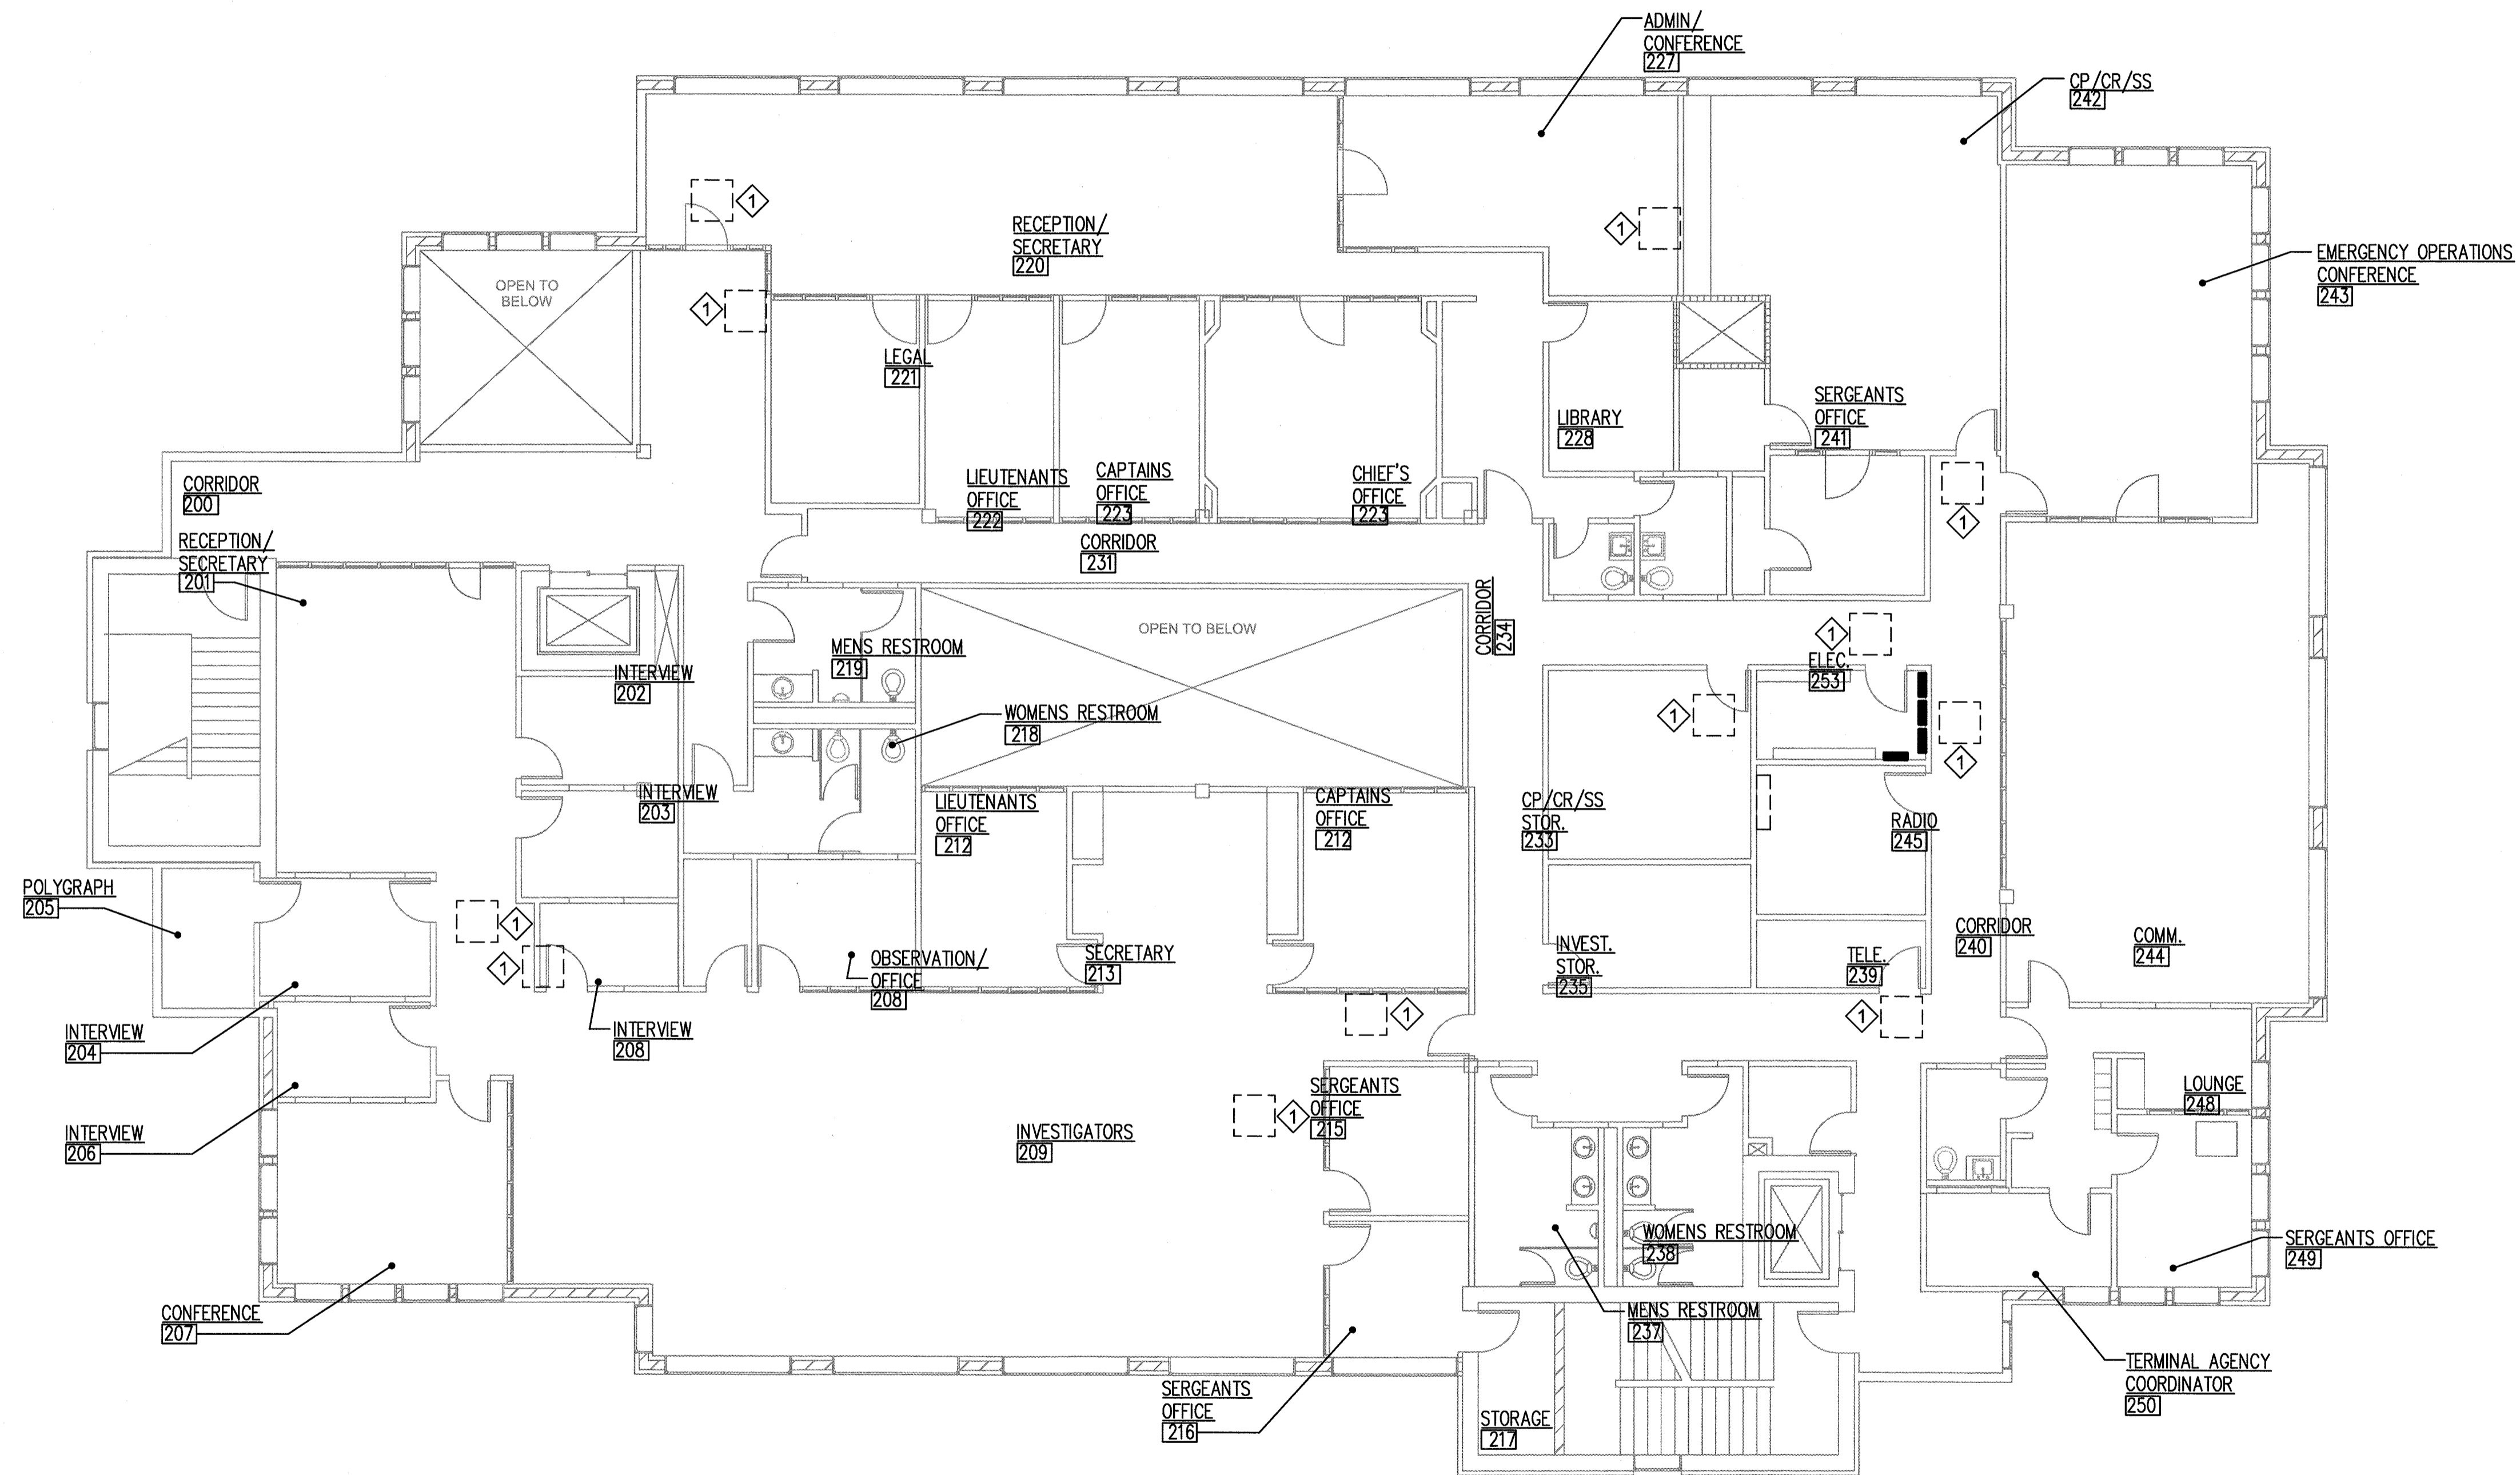

ELECTRICAL SHEET NOTES:

◆ ELECTRICAL CONTRACTOR SHALL REMOVE ELECTRICAL CONNECTIONS TO MECHANICAL FAN AND VAV. THE FAN AND VAV SHALL BE REMOVED BY MECHANICAL CONTRACTOR. ELECTRICAL CONTRACTOR SHALL REMOVE ALL WIRING AND CONDUIT FOR FAN AND VAV CIRCUITS 18, 20, 22, 24, 23, AND 25 BACK TO PANEL BOARD '1HM' ON THE GROUND FLOOR.

385 Gentry Way
 Reno, NV 89502
 Ph: 775.826.4044
 Fax: 775.826.4190
 Web: dnter.com
 J-4538

DINTER
 ENGINEERING CONFIDENCE

3/23/2018

MMI ENGINEERING
 385 GENTRY WAY
 RENO, NV. 89502
 (775) 499-5784
 WWW.MMIE-DESIGNER.COM
 MMI PROJECT #2016-19

**SPARKS POLICE DEPARTMENT
 HVAC UPGRADE PHASE 1
 1701 EAST PRATER WAY
 SPARKS, NEVADA 89434**

SHEET TITLE
 ELECTRICAL DEMOLITION
 FLOOR PLAN - SECOND
 FLOOR

REVISIONS

1 ELECTRICAL DEMOLITION FLOOR PLAN - SECOND FLOOR
 E1.3 SCALE: 1/8" = 1'-0"

BID DOCUMENTS

DATE: MARCH 26, 2018 RECEIVED-CITY OF SPARKS
 SHEET NUMBER: E1.3 COMMUNITY SERVICES BUILDING DIVISION


ELECTRICAL SHEET NOTES:

- ① COORDINATE AND VERIFY EXACT SIZE AND LOCATION OF 277-24V TRANSFORMER WITH MECHANICAL DRAWINGS AND MECHANICAL CONTROLS CONTRACTOR.
- ② VAV POWER CONNECTION TO NEW 277V FLOOR TRANSFORMER. TRANSFORMER SHALL BE FURNISHED AND INSTALLED BY MECHANICAL CONTROLS CONTRACTOR.
- ③ NEW CEILING MOUNTING LED LIGHT FIXTURE SHALL BE FURNISHED AND INSTALLED BY ELECTRICAL CONTRACTOR.
- ④ ELECTRICAL CONTRACTOR SHALL CONNECT NEW LIGHTING TO EXISTING CIRCUIT OUTSIDE OF VAULT.
- ⑤ ELECTRICAL CONTRACTOR SHALL CONNECT NEW LIGHTING TO EXISTING CIRCUIT IN ROOM 041.

- ⑥ ELECTRICAL CONTRACTOR SHALL FURNISH AND INSTALL NEW THREE BUTTON LIGHT LEVEL SETTING LIGHT SWITCH WITH MOTION SENSOR LIGHT SWITCH.
- ⑦ LIGHTING SENSORS TO TURN OFF LIGHTING AFTER 45 MINUTES OF NO DETECTION;
 - Ⓜ1: WSX PDT - ROOM MOTION SENSOR.
 - Ⓜ2: CMR 10 - CEILING AREA MOTION SENSOR.
- ⑧ ELECTRICAL CONTRACTOR SHALL USE EXISTING SPARE BREAKER FROM PANEL BOARD 'BLB' AT CIRCUIT 18.
- ⑨ ELECTRICAL CONTRACTOR SHALL USE EXISTING BREAKER FROM PANEL BOARD '1HM' AT CIRCUIT 2. CIRCUIT WAS PART OF DEMO WORK. CONTRACTOR CAN REUSE EXISTING CONDUIT WHERE POSSIBLE.


⑩ ELECTRICAL CONTRACTOR SHALL RE-INSTALL LIGHT FIXTURE, SPEAKER, ETC. IN THE NEW HARD LID CEILING. ELECTRICAL CONTRACTOR SHALL TEST EACH DEVICE AFTER INSTALLATION TO MAKE SURE THE DEVICE IS FULLY OPERATIONAL AND FUNCTIONING CORRECTLY. THE ELECTRICAL CONTRACTOR SHALL ALSO VERIFY ELECTRICAL SYSTEM IS THAT THE DEVICE IS CONNECTED TO IS FULLY OPERATIONAL AND FUNCTIONING CORRECTLY.

⑪ ELECTRICAL CONTRACTOR SHALL UNCOVER OR RE-INSTALL HORN/STROBE, ETC. IN THE NEW HARD LID CEILING. ELECTRICAL CONTRACTOR SHALL TEST EACH DEVICE AFTER INSTALLATION TO MAKE SURE THE DEVICE IS FULLY OPERATIONAL AND FUNCTIONING CORRECTLY. THE ELECTRICAL CONTRACTOR SHALL ALSO VERIFY THE FIRE ALARM SYSTEM IS FULLY OPERATIONAL AND FUNCTIONING CORRECTLY.

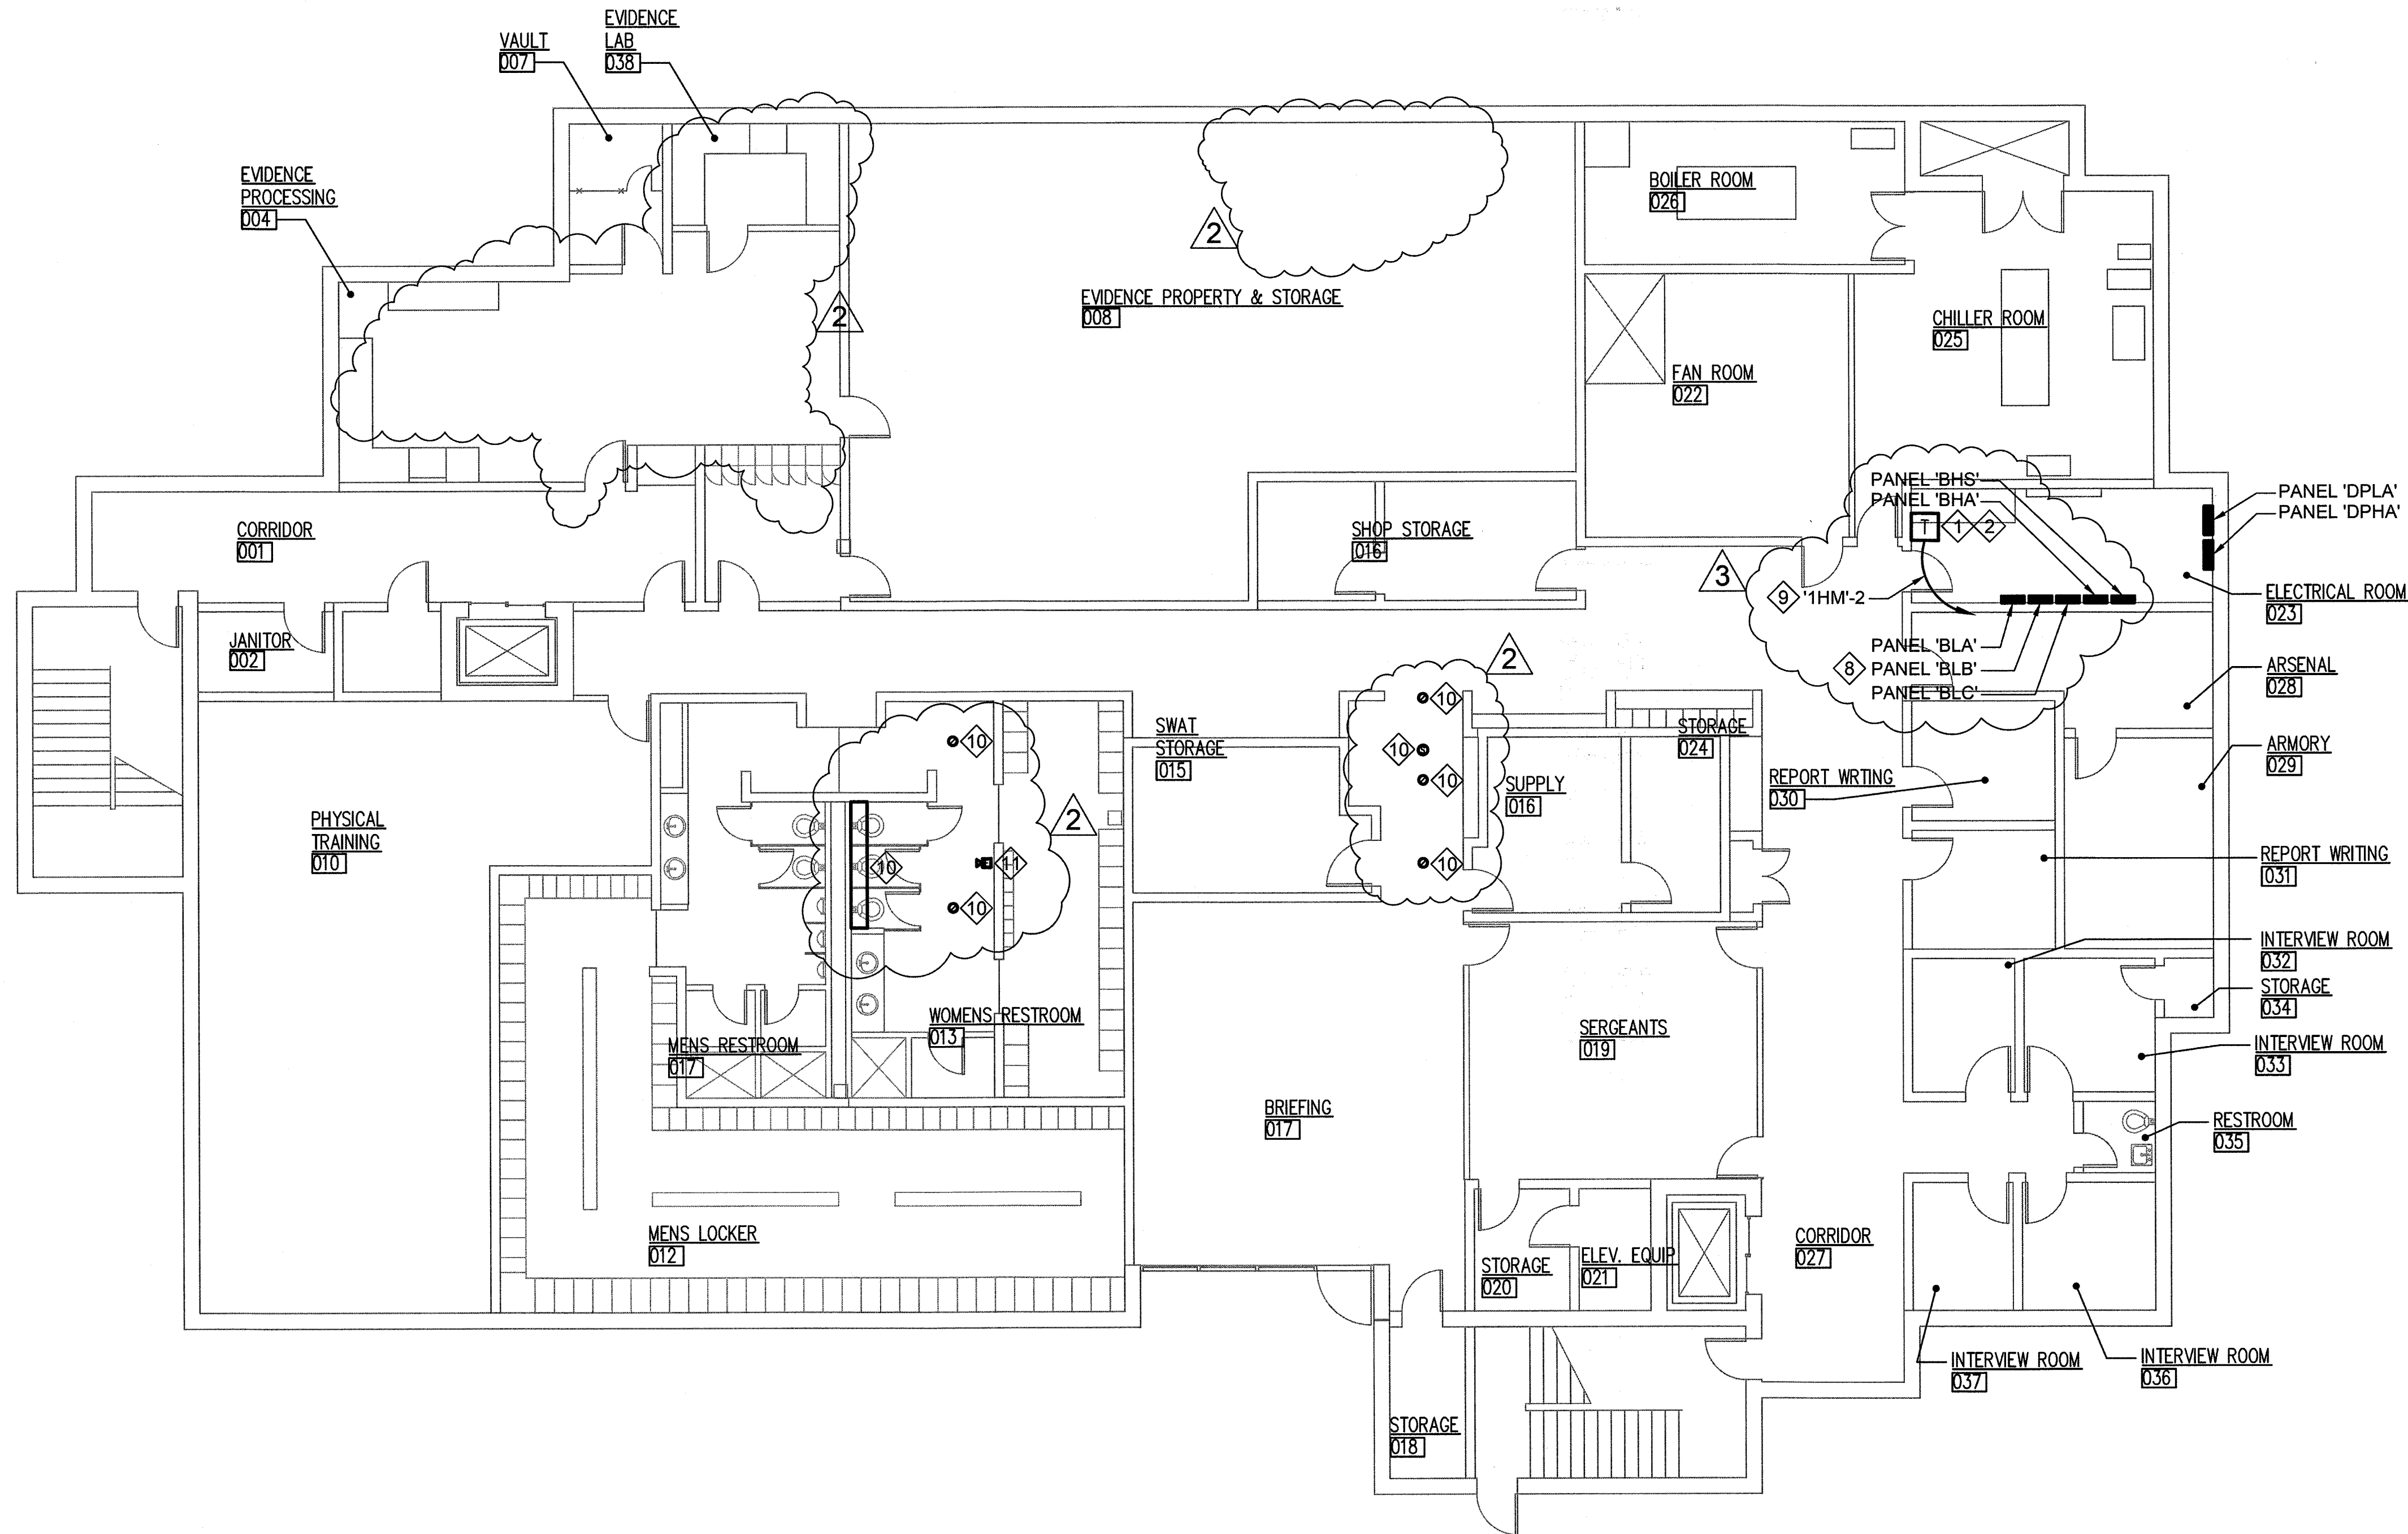


① ELEDTRICAL FLOOR PLAN - BASEMENT
E2.1 SCALE: 1/8" = 1'-0"

385 Gentry Way
Reno, NV 89502
Ph: 775.826.4044
Fax: 775.826.4190
Web: dinter.com
J-4538

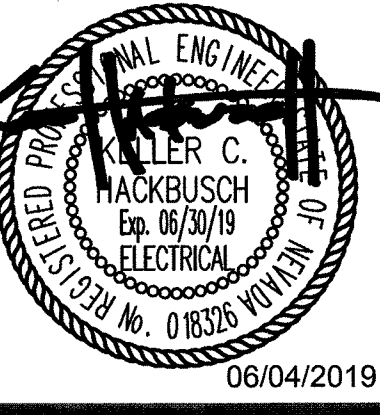

MMI ENGINEERING
385 GENTRY WAY
RENO, NV. 89502
(775) 499-5784
WWW.MMI-DESIGNER.COM
MMI PROJECT #2016-19

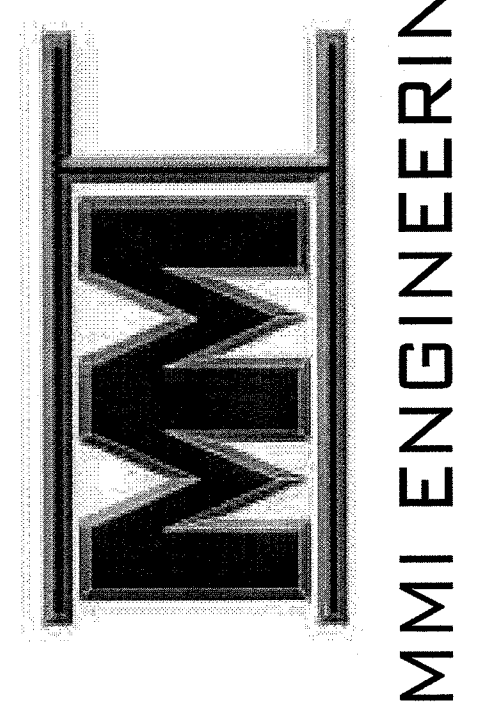

SPARKS POLICE DEPARTMENT
HVAC UPGRADE PHASE 1
1701 EAST PRATER WAY
SPARKS, NEVADA 89434

SHEET TITLE
ELECTRICAL FLOOR PLAN - BASEMENT


REVISIONS	OWNER REVISIONS
②	(10/31/18)
③	(06/04/19)

BID DOCUMENTS

CITY OF SPARKS
COMMUNITY SERVICES-BLDG. DIV.
DATE: JUNE 4, 2019
SHEET NUMBER: JUN 07 2019
REVISED
E2.1

ELECTRICAL SHEET NOTES:

- 1 COORDINATE AND VERIFY EXACT SIZE AND LOCATION OF 277-24V TRANSFORMER WITH MECHANICAL DRAWINGS AND MECHANICAL CONTROLS CONTRACTOR.
- 2 VAV POWER CONNECTION TO NEW 277V FLOOR TRANSFORMER. TRANSFORMER SHALL BE FURNISHED AND INSTALLED BY MECHANICAL CONTROLS CONTRACTOR.
- 3 ELECTRICAL CONTRACTOR SHALL REMOVE 20A/1P SPARE BREAKERS FROM PANEL '1HM' AT CIRCUITS 1, 3, AND 5. ELECTRICAL CONTRACTOR SHALL FURNISH AND INSTALL A NEW 20A/3P BREAKER AT CIRCUITS 1, 3, AND 5. BREAKER SHALL MATCH PANEL BOARD MANUFACTURER AND MEET MANUFACTURER'S REQUIREMENT FOR EXITING PANEL BOARD.
- 4 ELECTRICAL CONTRACTOR SHALL USE EXISTING BREAKER FROM PANEL BOARD '1HM' AT CIRCUIT 4. CIRCUIT WAS PART OF DEMO WORK. CONTRACTOR CAN REUSE EXISTING CONDUIT WHERE POSSIBLE.
- 5 ELECTRICAL CONTRACTOR SHALL REMOVE 20A/1P SPARE BREAKERS FROM PANEL '1HM' AT CIRCUITS 18, 20, AND 22. ELECTRICAL CONTRACTOR SHALL FURNISH AND INSTALL A NEW 50A/3P BREAKER AT CIRCUITS 18, 20, AND 22. BREAKER SHALL MATCH PANEL BOARD MANUFACTURER AND MEET MANUFACTURER'S REQUIREMENT FOR EXITING PANEL BOARD.
- 6 ELECTRICAL CONTRACTOR SHALL RE-INSTALL LIGHT FIXTURE, SPEAKER, ETC. IN THE NEW HARD LID CEILING. ELECTRICAL CONTRACTOR SHALL TEST EACH DEVICE AFTER INSTALLATION TO MAKE SURE THE DEVICE IS FULLY OPERATIONAL AND FUNCTIONING CORRECTLY. THE ELECTRICAL CONTRACTOR SHALL ALSO VERIFY ELECTRICAL SYSTEM IS THAT THE DEVICE IS CONNECTED TO IS FULLY OPERATIONAL AND FUNCTIONING CORRECTLY.
- 7 ELECTRICAL CONTRACTOR SHALL RE-INSTALL LIGHT FIXTURE, ETC. IN THE NEW GRID CEILING. ELECTRICAL CONTRACTOR SHALL TEST EACH DEVICE AFTER INSTALLATION TO MAKE SURE THE DEVICE IS FULLY OPERATIONAL AND FUNCTIONING CORRECTLY. THE ELECTRICAL CONTRACTOR SHALL ALSO VERIFY ELECTRICAL SYSTEM IS THAT THE DEVICE IS CONNECTED TO IS FULLY OPERATIONAL AND FUNCTIONING CORRECTLY.
- 8 ELECTRICAL CONTRACTOR TO COORDINATE WITH ON SITE IT MANAGER FOR CONDUIT RUN IN RAISED FLOOR CABLE RUN SPACE.

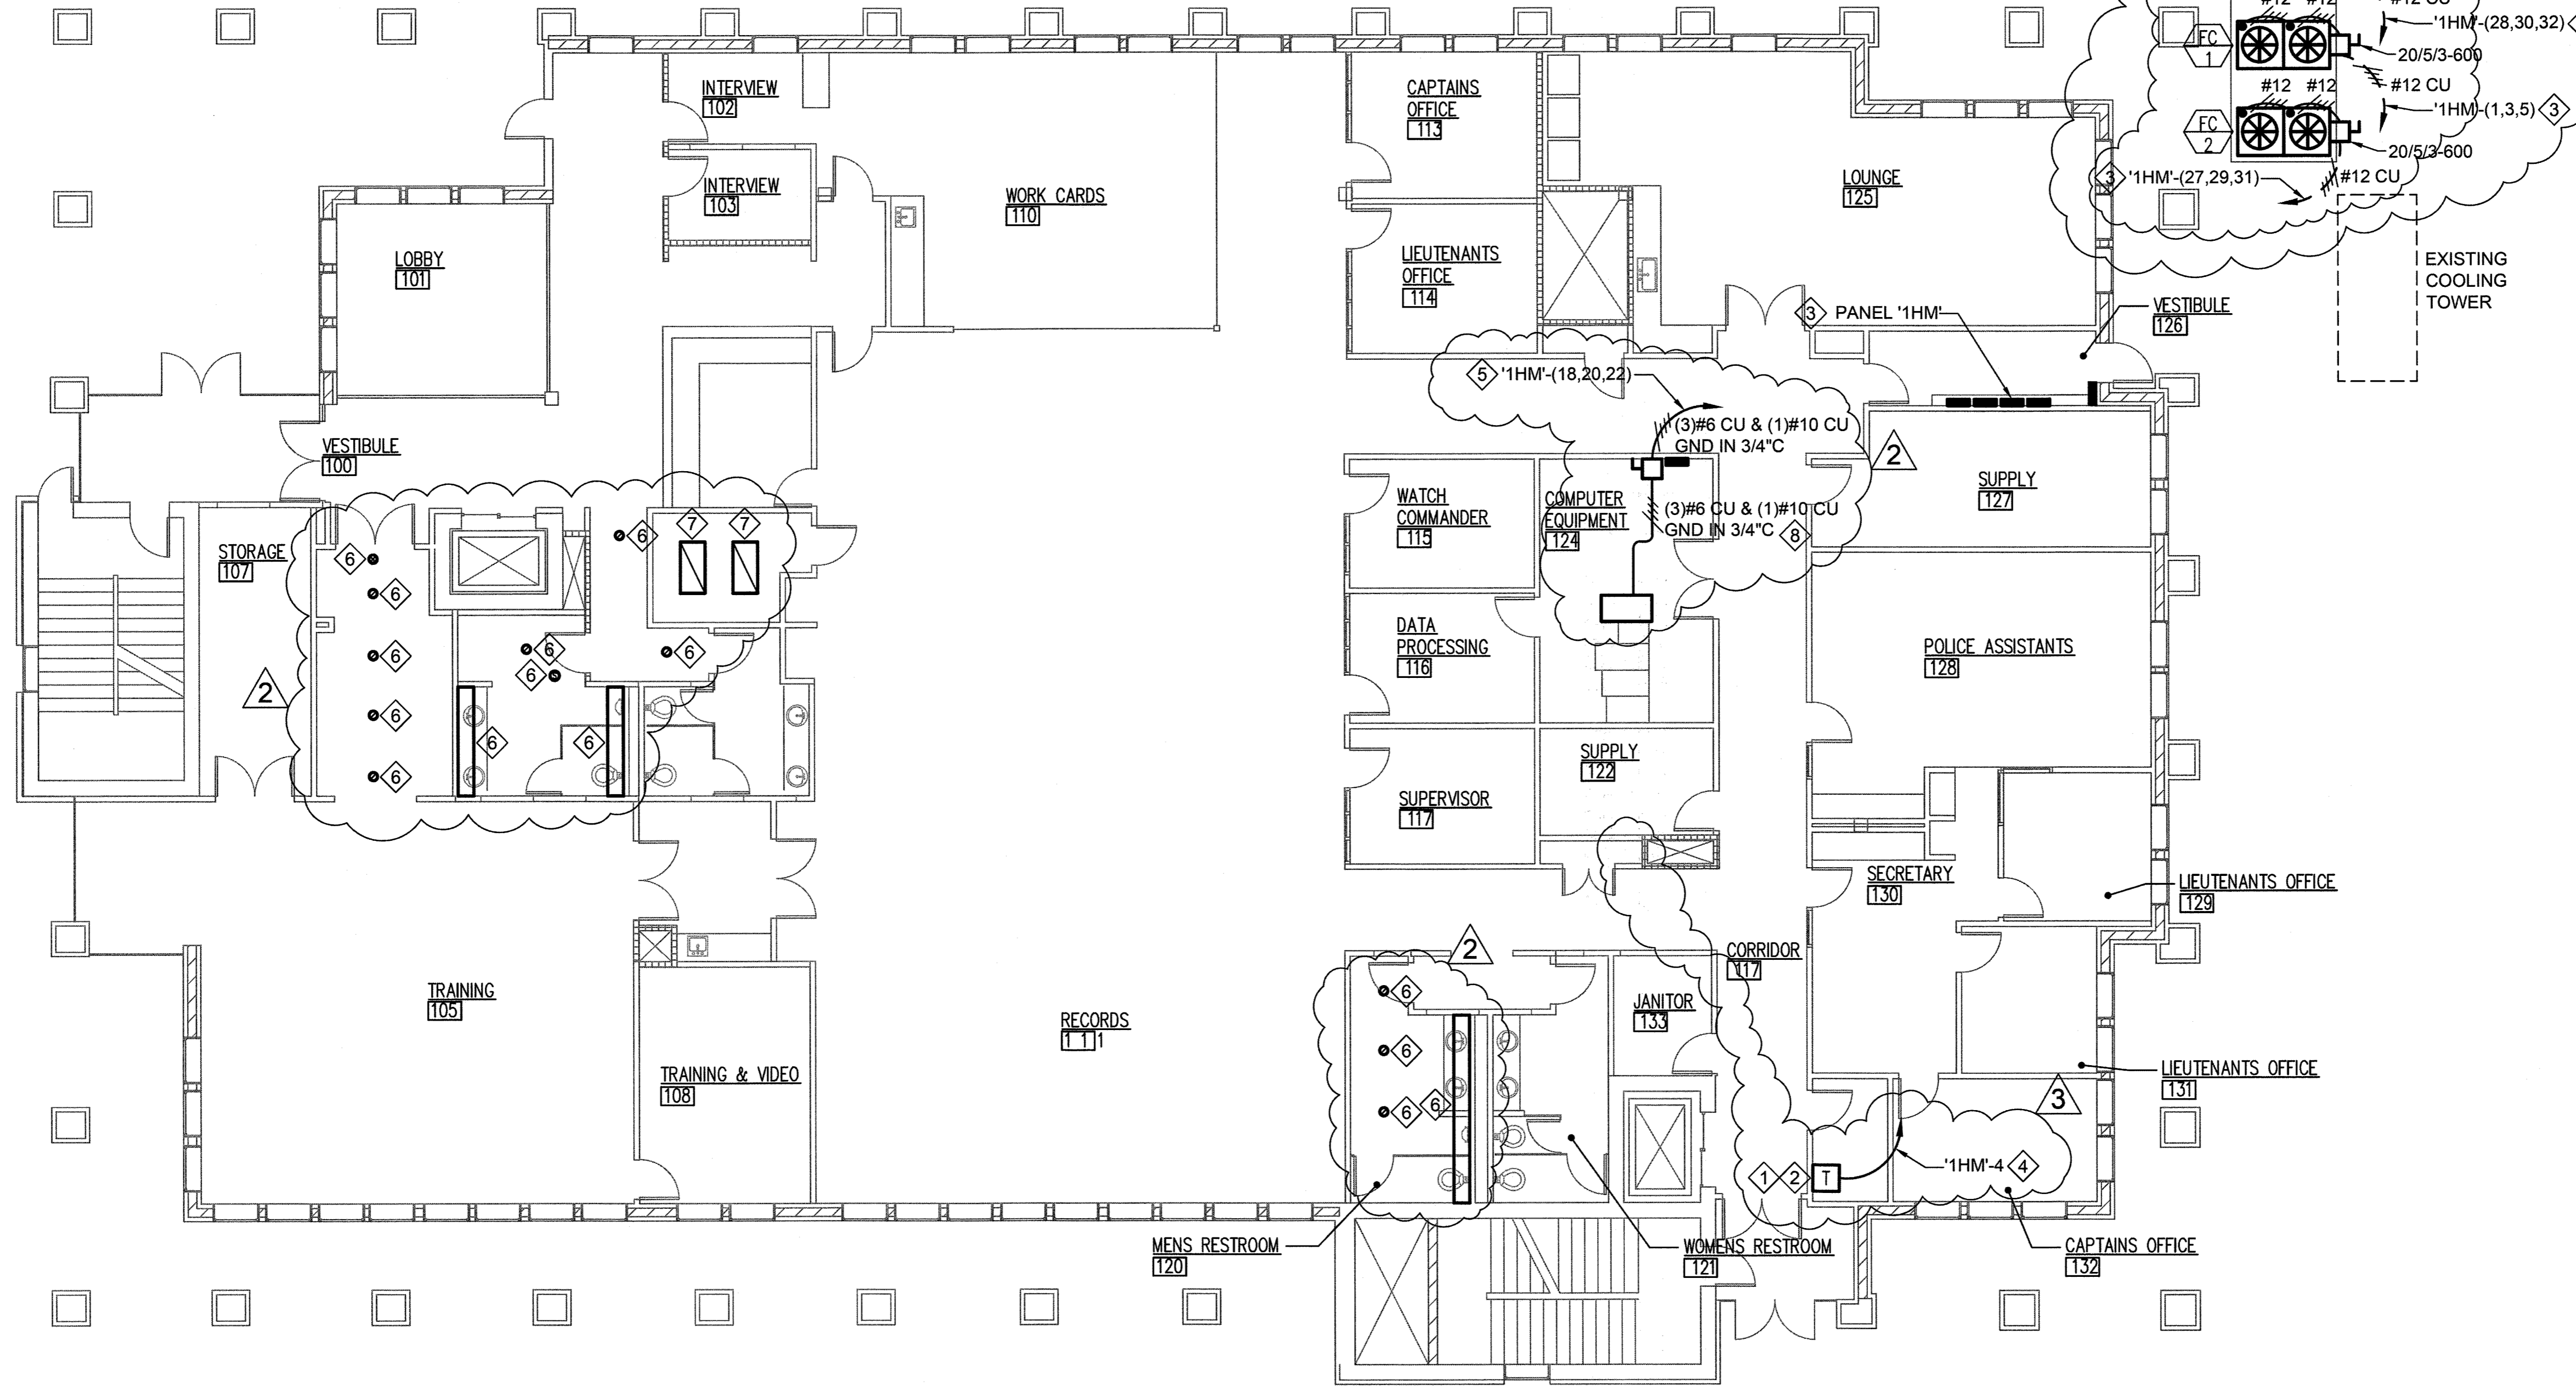

1 ELECTRICAL FLOOR PLAN - GROUND FLOOR
E2.2 SCALE: 1/8" = 1'-0"

385 Gentry Way
Reno, NV 89502
Ph: 775.826.4044
Fax: 775.826.4190
Web: dinter.com
J-4538

DINTER
ENGINEERING CONFIDENCE

REGISTERED PROFESSIONAL ENGINEER
WALTER C. HACKBUSCH
Exp. 06/30/19
ELECTRICAL
1979 No. 08306 NV/MS/JD
06/04/2019

MMI ENGINEERING
385 GENTRY WAY
RENO, NV. 89502
(775) 499-5784
WWW.MMIE-DESIGNER.COM
MMI PROJECT #2016-19

MMI ENGINEERING

SPARKS POLICE DEPARTMENT
HVAC UPGRADE PHASE 1
1701 EAST PRATER WAY
SPARKS, NEVADA 89434


SHEET TITLE
ELECTRICAL FLOOR PLAN - GROUND FLOOR

REVISIONS

2	OWNER REVISIONS (10/31/18)
3	OWNER REVISIONS (06/04/19)

BID DOCUMENTS



CITY OF SPARKS
DATE: COMMUNITY SERVICES-BLDG. DIV.
JUNE 4, 2019
JUN 07 2019
REVISION
E2.2

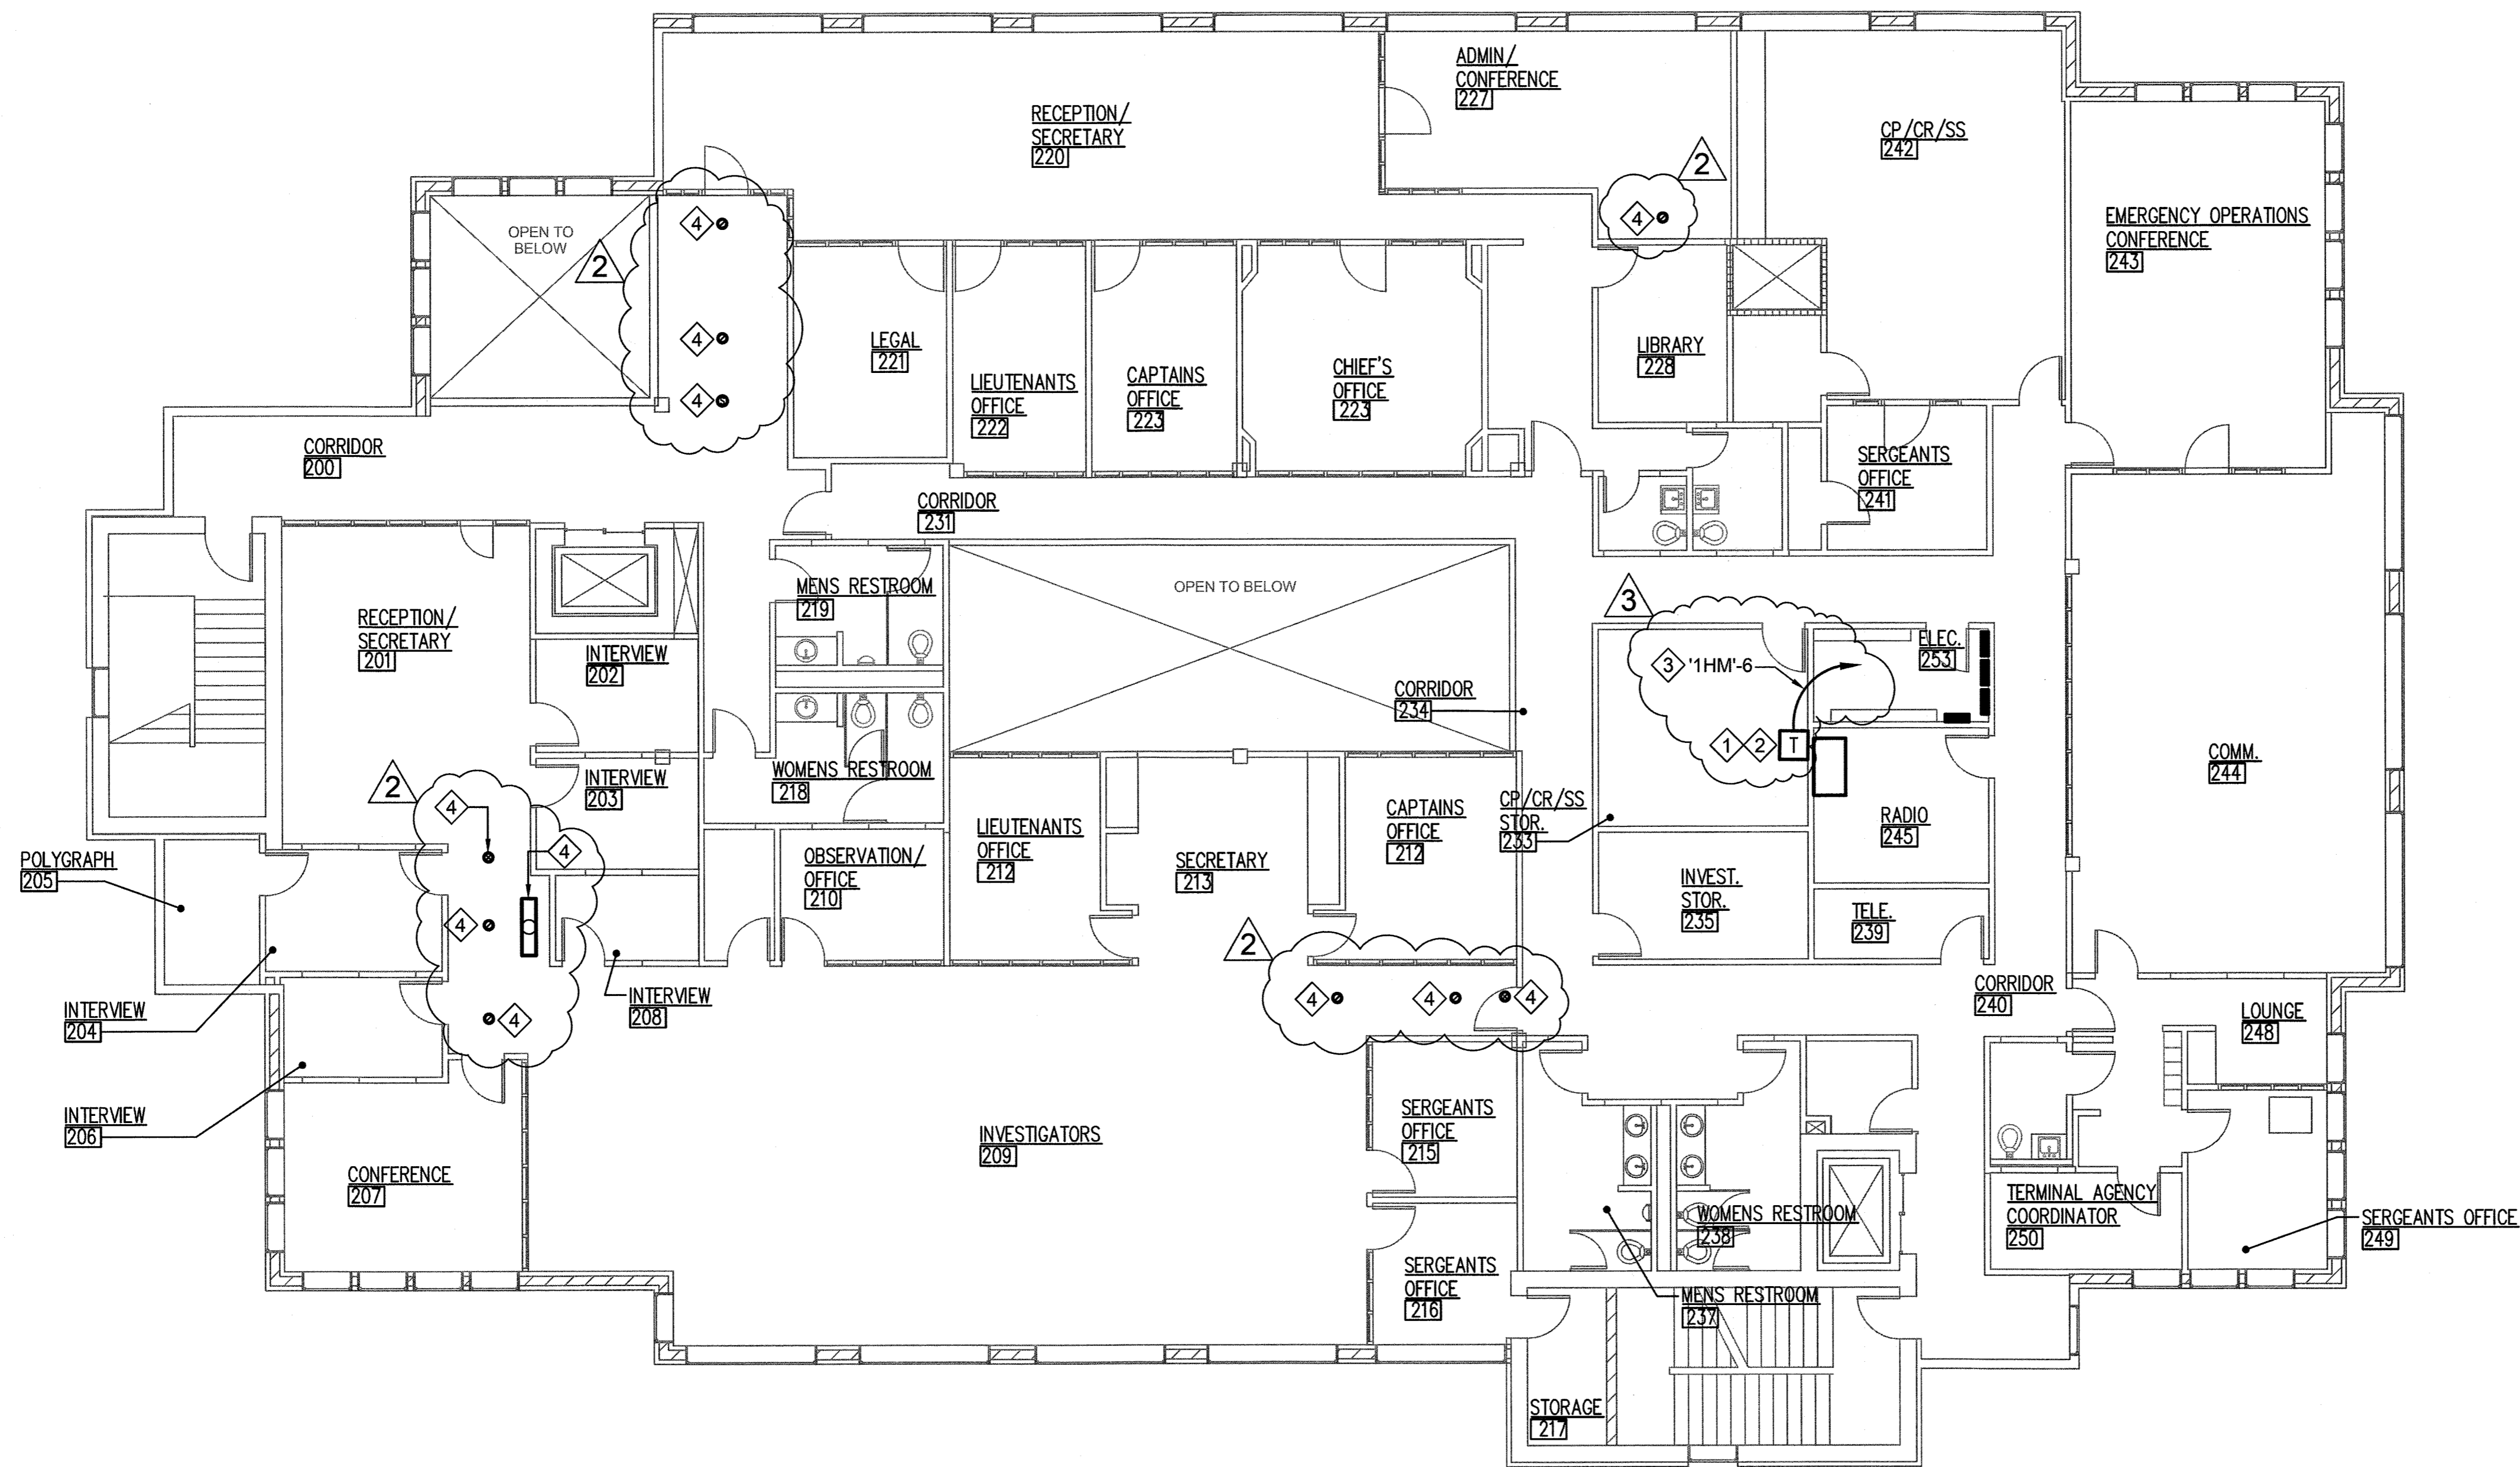


ELECTRICAL SHEET NOTES:

- ① COORDINATE AND VERIFY EXACT SIZE AND LOCATION OF 277-24V TRANSFORMER WITH MECHANICAL DRAWINGS AND MECHANICAL CONTROLS CONTRACTOR.
- ② VAV POWER CONNECTION TO NEW 277V FLOOR TRANSFORMER. TRANSFORMER SHALL BE FURNISHED AND INSTALLED BY MECHANICAL CONTROLS CONTRACTOR.
- ③ ELECTRICAL CONTRACTOR SHALL USE EXISTING BREAKER FROM PANEL BOARD '1HM' AT CIRCUIT 6. CIRCUIT WAS PART OF DEMO WORK. CONTRACTOR CAN REUSE EXISTING CONDUIT WHERE POSSIBLE.
- ④ ELECTRICAL CONTRACTOR SHALL RE-INSTALL LIGHT FIXTURE, SPEAKER, ETC. IN THE NEW HARD LID CEILING. ELECTRICAL CONTRACTOR SHALL TEST EACH DEVICE AFTER INSTALLATION TO MAKE SURE THE DEVICE IS FULLY OPERATIONAL AND FUNCTIONING CORRECTLY. THE ELECTRICAL CONTRACTOR SHALL ALSO VERIFY ELECTRICAL SYSTEM IS THAT THE DEVICE IS CONNECTED TO IS FULLY OPERATIONAL AND FUNCTIONING CORRECTLY.

385 Gentry Way
Reno, NV 89502
Ph: 775.826.4044
Fax: 775.826.4190
Web: dinter.com
J-4538

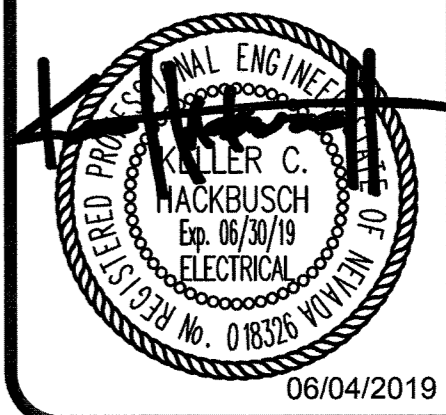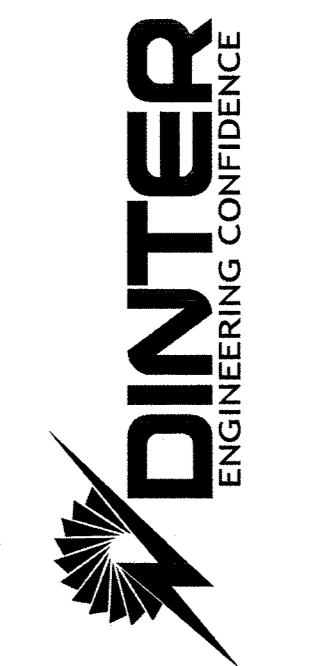

MMI ENGINEERING
385 GENTRY WAY
RENO, NV. 89502
(775) 499-5784
WWW.MMI-DESIGNER.COM
MMI PROJECT #2016-19

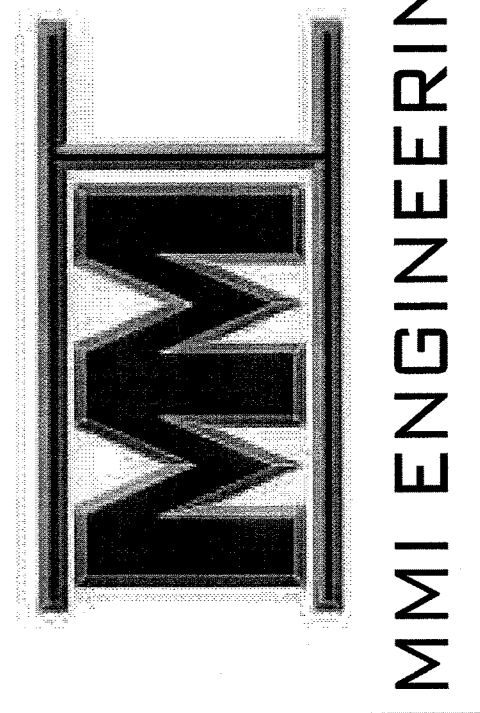

SPARKS POLICE DEPARTMENT
HVAC UPGRADE PHASE 1
1701 EAST PRATER WAY
SPARKS, NEVADA 89434

SHEET TITLE
ELECTRICAL FLOOR PLAN
- SECOND FLOOR

REVISIONS	OWNER REVISIONS
②	(10/31/18)
③	(06/04/19)

① ELECTRICAL FLOOR PLAN - SECOND FLOOR
E2.3 SCALE: 1/8" = 1'-0"

BID DOCUMENTS

CITY OF SPARKS
COMMUNITY SERVICES-BLDG. DIV.
JUNE 4, 2019
JUN 07 2019
REVISED
E2.3