



TimberForm-2 Model No. 4890-TF Appropriate for Children 5 to 12 Years of Age.
RePlay Model No. 4890-RP

Play Area, Equipment Only:
34' x 26' (10.4m x 8.0m)

Minimum Safe Use Zone:
46' x 38' (14.1m x 11.6m)

Accessibility Profile:

- 19 Total Play Components
- 14 Elevated Play Components
(14 Accessible)
- 5 Ground Level Play Components
(5 Accessible)

Colors Illustrated:

- Accessories:** Evergreen
- Decks:** SofDek Plastic-coated
Perforated Steel, Brown
- Plastic:** Yellow



4890 Features:

- Abacus
- Accessible Transfer Station, 8" (21cm) Riser
- Addition Panel
- Arch Ring Climber
- Baluster Wall (6)
- Baluster Wall with Ship's Wheel
- ~~Bubble Panel~~
- Cargo Net
- Kid Spinner
- Overhead Safety Ladder
- School Bus with Wheel and Wood Seats
- Spelling Panel, Baluster Wall
- Spiral Slide Chute
- Storefront Countertop
- ~~Suspension Bridge,~~
- ~~Perforated Steel,~~
- ~~with Baluster Walls~~
- Talk Tube
- Tot Slide Chute, Curved
- ~~Track Ride, 8' (244cm)~~
- Tunnel Crawl, Clear Plastic
- Vertical Loop Climber
- Vertical Safety Climber
- Welcome/Rules Sign
- Wood Roof




Play Area, Kid Spinner Only:
2' x 2' (0.7m x 0.7m)

Minimum Safe Use Zone:
14' x 14' (4.3m x 4.3m)

Safe use zone border

1613-22-38

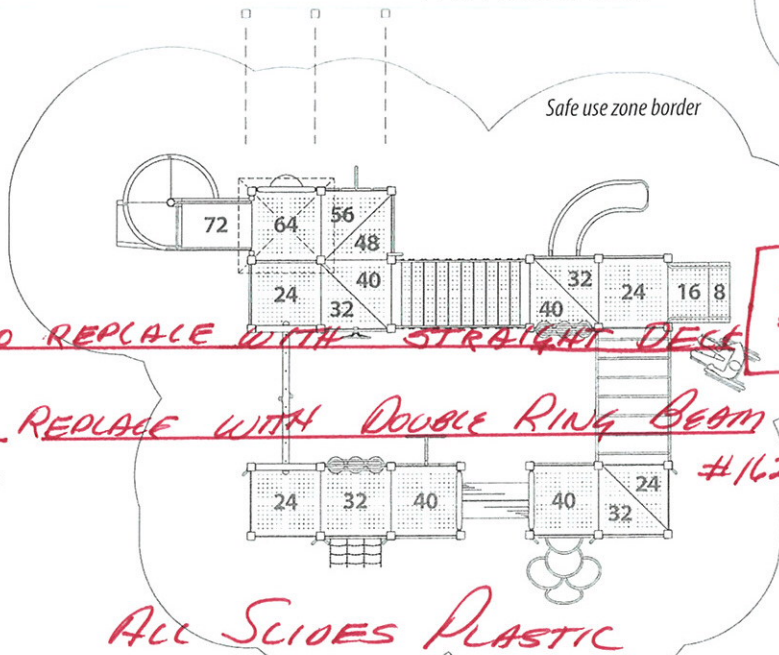

SIMILAR TO #1664-8 (BUT PERF. STEEL)

Deck Heights:

| | |
|----------|--------|
| 8"..... | 205mm |
| 16"..... | 405mm |
| 24"..... | 610mm |
| 32"..... | 815mm |
| 40"..... | 1015mm |
| 48"..... | 1220mm |
| 56"..... | 1420mm |
| 64"..... | 1625mm |
| 72"..... | 1830mm |



Plan-view scale: 3/32" = 1' (1 = 133mm)